


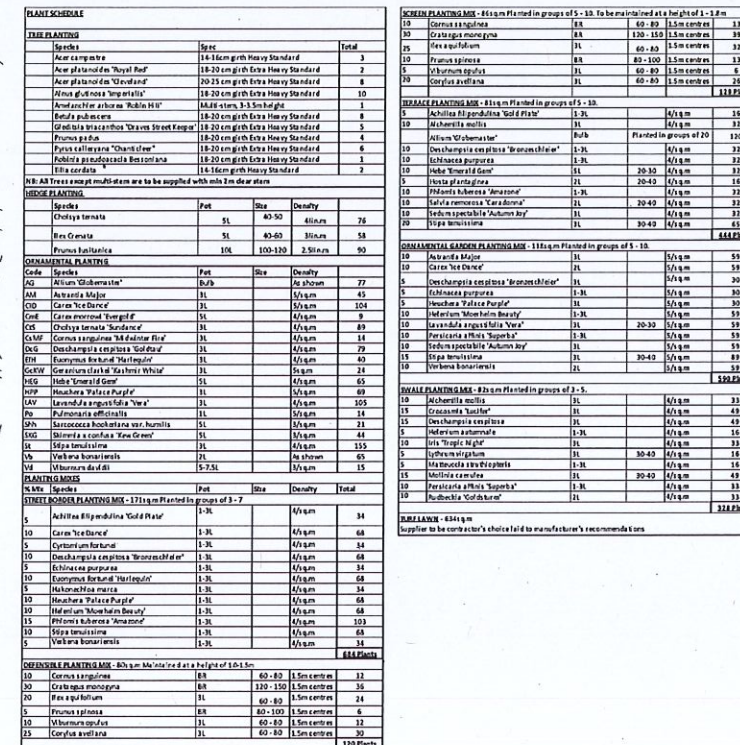

 Existing Trees Retained
Trees to be retained and protected inline with B55837:2012 recommendations. Please refer to Urban Green Tree Survey Report and Tree Protection Plan for further details.

-
- Proposed Feature Trees**
To be deciduous species around the development frontage.
18-20cm girth Extra-High Standards & 20-25cm girth Semi-mature standards
- Proposed Ornamental Trees**
To be planted within the swales and soft landscaped areas as 18-20cm girth Extra-High Standard deciduous specimens.
- Proposed Native Trees**
To be planted within the landscaped buffer to Pottery Lane as 14-16cm girth High Standards.
- Proposed Ornamental Shrub Planting** – refer detail planting plan
To be planted as 3-5L contained plant stock at 3-5m
- Proposed Evergreen Hedge**
To be a single species evergreen hedge species
- Proposed Street Border Buffer Planting**
To include fast growing and native/semi-native varieties to provide a landscaped buffer.
- Proposed Defensible Planting Mix**
To include fast growing and native/semi-native varieties
- Proposed Screen Planting**
To include fast growing and native/ semi-native varieties to provide a landscaped buffer.
- Proposed Private Terrace Planting Mix**
To include fast growing and native/ semi-native varieties to provide a landscaped buffer.
- Proposed Ornamental Garden Planting Mix**
To be planted as 2-5L, contained plant stock at 3-5m
- Proposed Swale Planting Mix**
To be plants which are tolerant of wet conditions and those which are beneficial to wildlife and/or native species
- Proposed Grassed Areas**
To be laid as turf

○ SCHWEGLER
1B NEST BOX MOUNTED
TO EXISTING TREE.

○ SCHWEISSEN 2F
BAT BOX MOUNTED
TO EXISTING MTE

23/01/23
MARKUP SHOWING BAT/
BIRD BOX LOCATIONS.



DEP LANDSCAPE ARCHITECTURE LTD
BLACKFRIARS HOUSE, PARSONAGE
MANCHESTER, M3 2JA
T: 0161 2419878
E: info@dep.co.uk
W: www.dep.co.uk

Client
One Manchester

Project
Gorton Lane, Gorton

Site 2 Planting Plan

8790-DEF-XX-GE-D8-I-0011

For Information

Scale

1:200@A1	BH
Job number	Drawing number
Date	Revision

3882 11 Feb 2021

Copyright DEF Landscape Architecture Ltd

All levels and dimensions to be checked on site by contractor prior to commencement; Any variations to be reported to the client. This drawing is to be read in conjunction with all others relating to the project and all information derived accordingly; any anomalies to be reported to the client. Do not scale from this drawing. Use figured dimensions only. Work shown on this drawings to be carried out in accordance with current British Standards and Codes of Practice.

© Copyright to DEP Landscape Architecture Limited. The information shown on this drawing shall not be reproduced or copied in any form without prior written consent from DEP Landscape Architecture Limited.

