


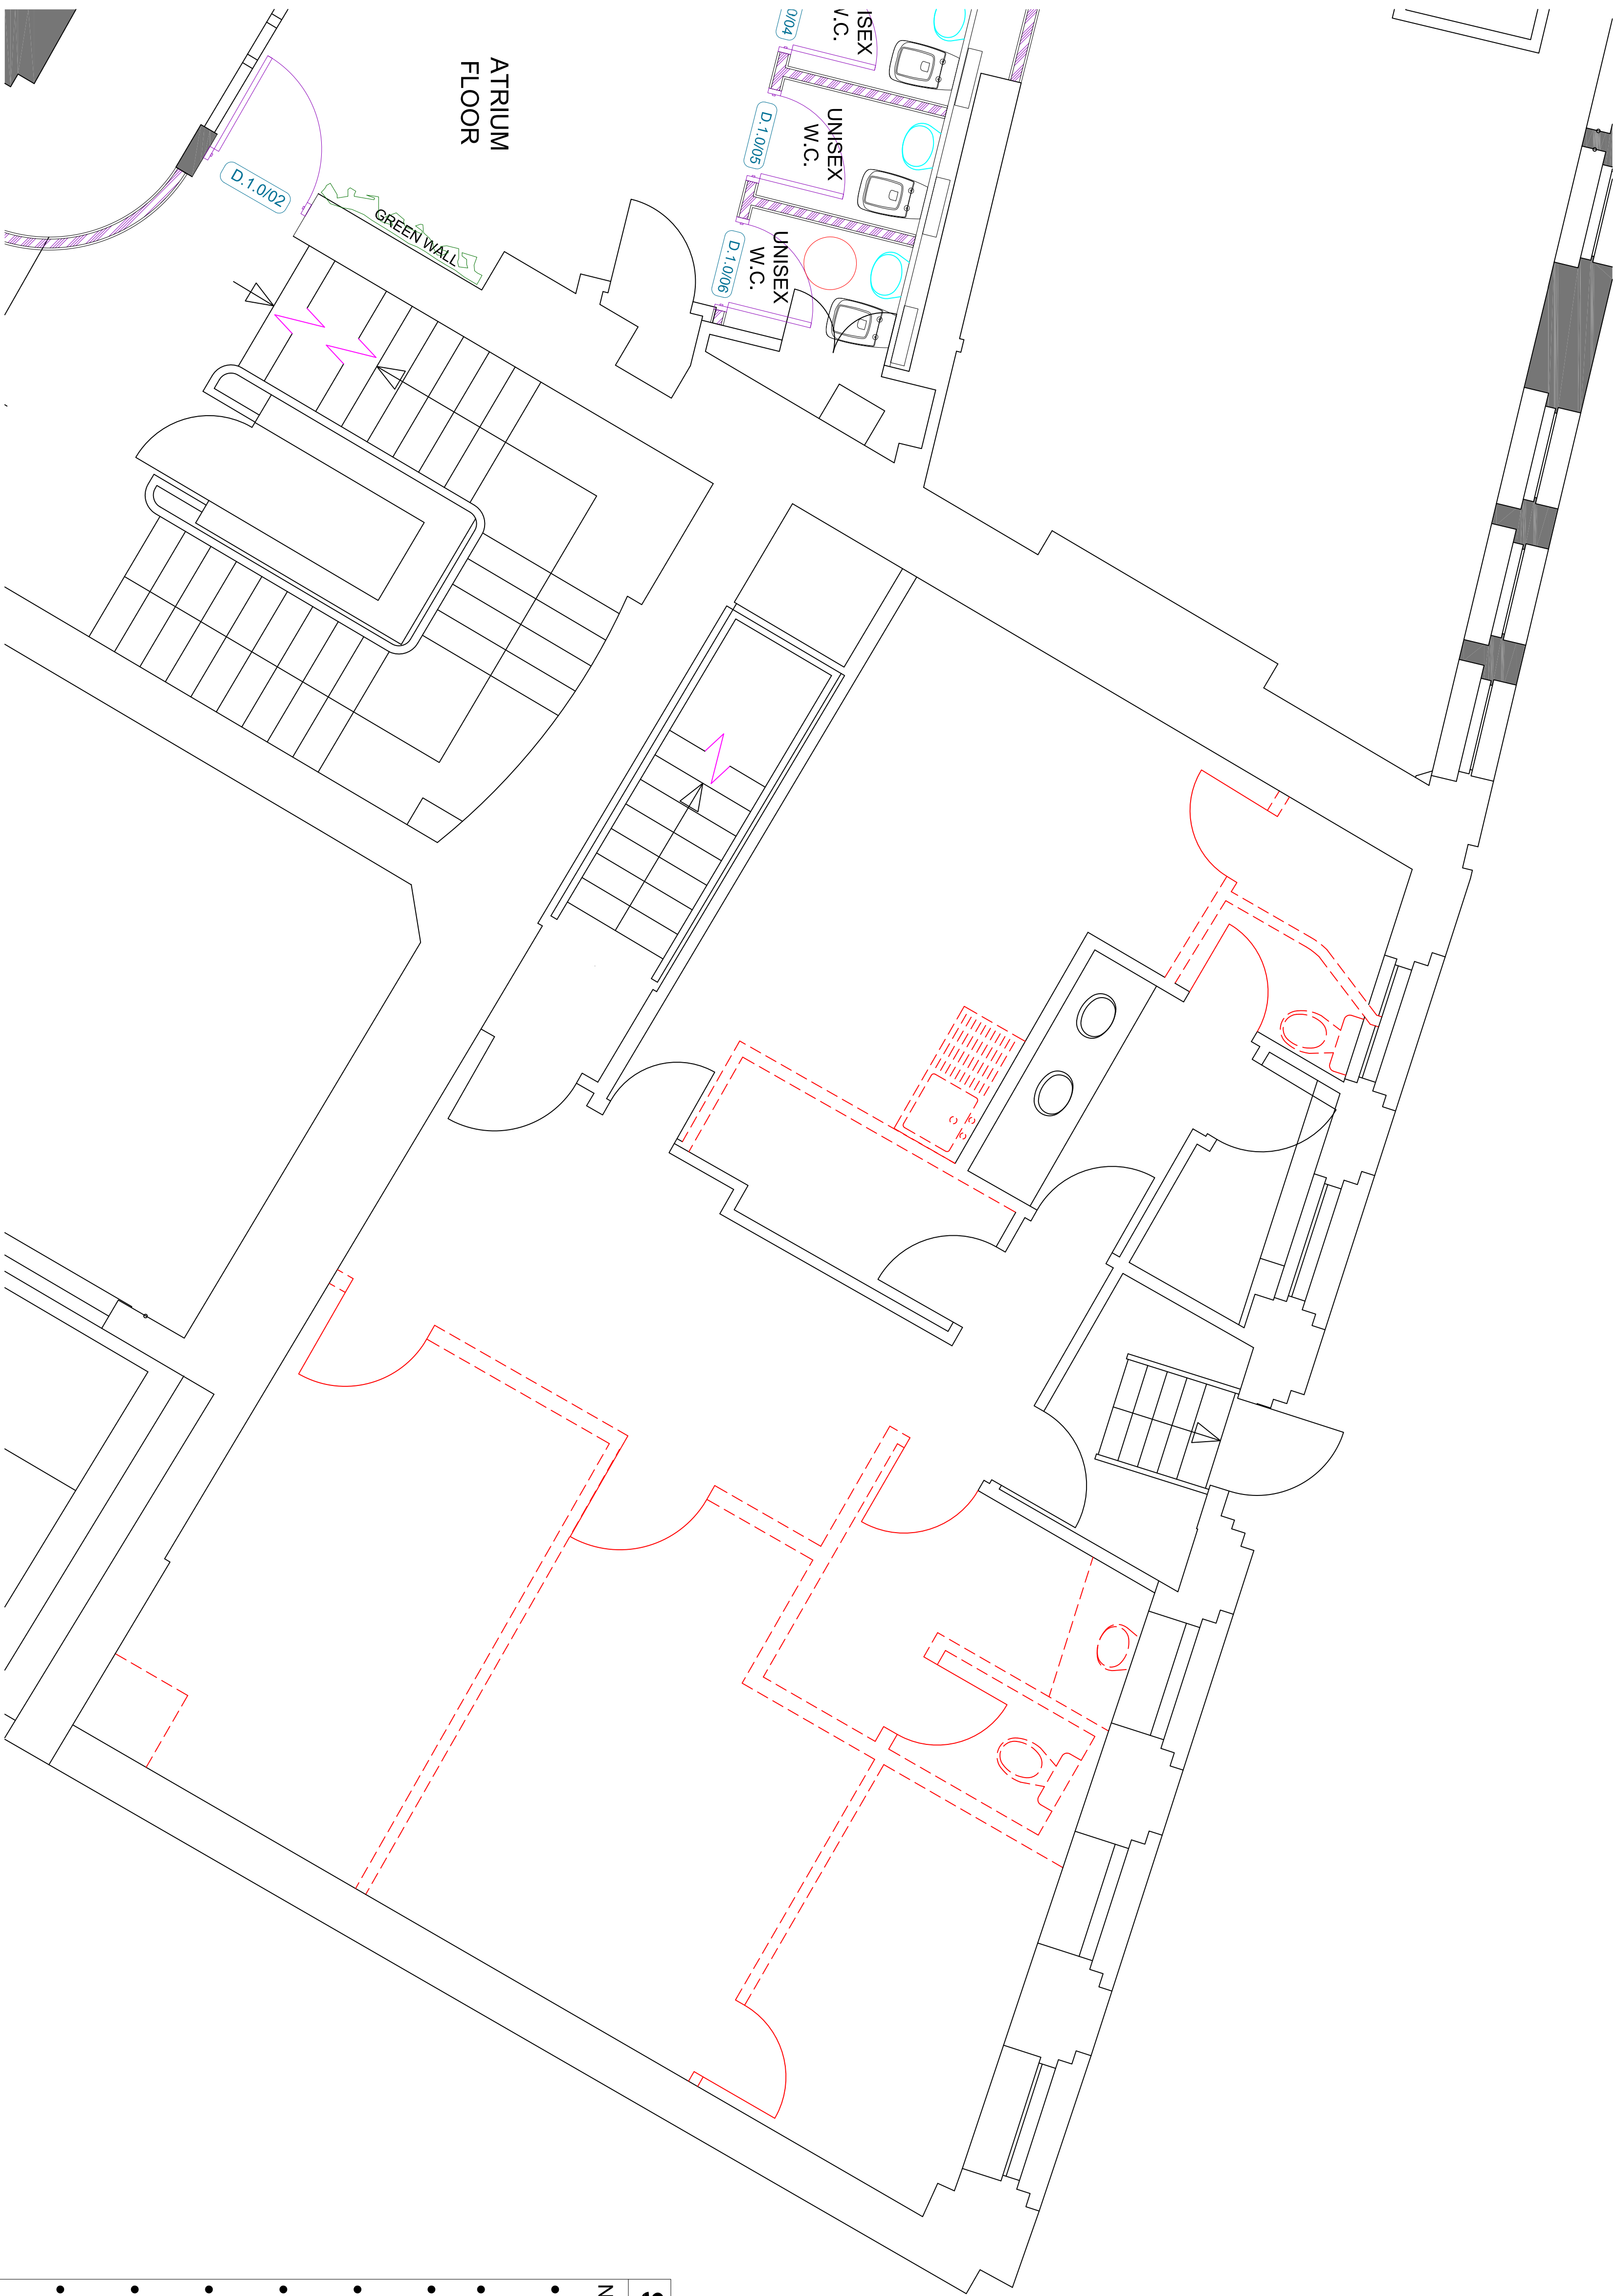

Demolition Plan

First Floor Victoria Building scale 1:50

CLIENT :		BUILDING :		DRAWING TITLE :		DRAWN BY :		DATE :		SIZE :		REV :	
Armenian Experience		Victoria Buildings 1-7 Princess Street Manchester M2 4DF		Existing Fit-Out Demolition Plan		James C Scott		March 2022		A1			
						DWG No :		SCALE :		DOC FOR :			
						C8S_10194.1.2		1:50		For Site			


COPYRIGHT: The copyright in this drawing is vested in Cube8 Studio Ltd and no licence or assignment of any kind has been, or is, granted to any third party whether by provision of copies or originals of the drawings or otherwise unless otherwise agreed in writing. DO NOT SCALE FROM THIS DRAWING. | BUILDING APPRAISAL | HUMAN-CENTERED DESIGN | SPACE PLANNING | INTERIOR DESIGN & ARCHITECTURE | BRAND & IDENTITY | FURNITURE & ACCESSORIES | 3D VISUALISATION | PROJECT MANAGEMENT |

SRIP-OUT & DEMOLITION

Notes:

- Remove all dry-lining partitions and doors indicated in red.
- Remove all floor LVT & Carpet.
- Remove all Sanitary-ware and kitchens as indicated on the drawing.
- Remove all suspended ceiling and MF to expose original ceiling height.
- Remove all compact florescent lights and make cable safe.
- Any fire alarm fittings are to securely taped up and made safe.
- All interior existing solid walls are to be stripped back to original finish.
- Any original fittings, walls, joinery, flooring and ceiling features to be left. The building is grade 11 listed. An inspection will need to done to ascertain what's listed once strip out is completed.

Cube 8 Studio are to be contacted if you are unsure whether to the strip-out items are original or add on's.

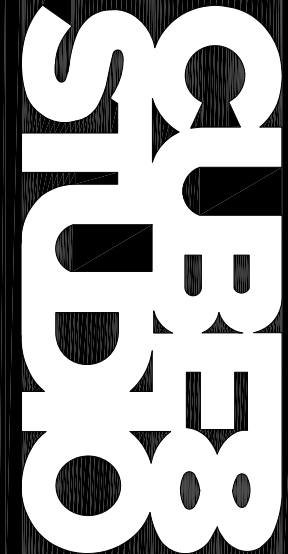

0161 849239
info@cube8studio.com
studio 427, The Mels, Mcr
Black & White Bld, London
www.cube8studio.com

