
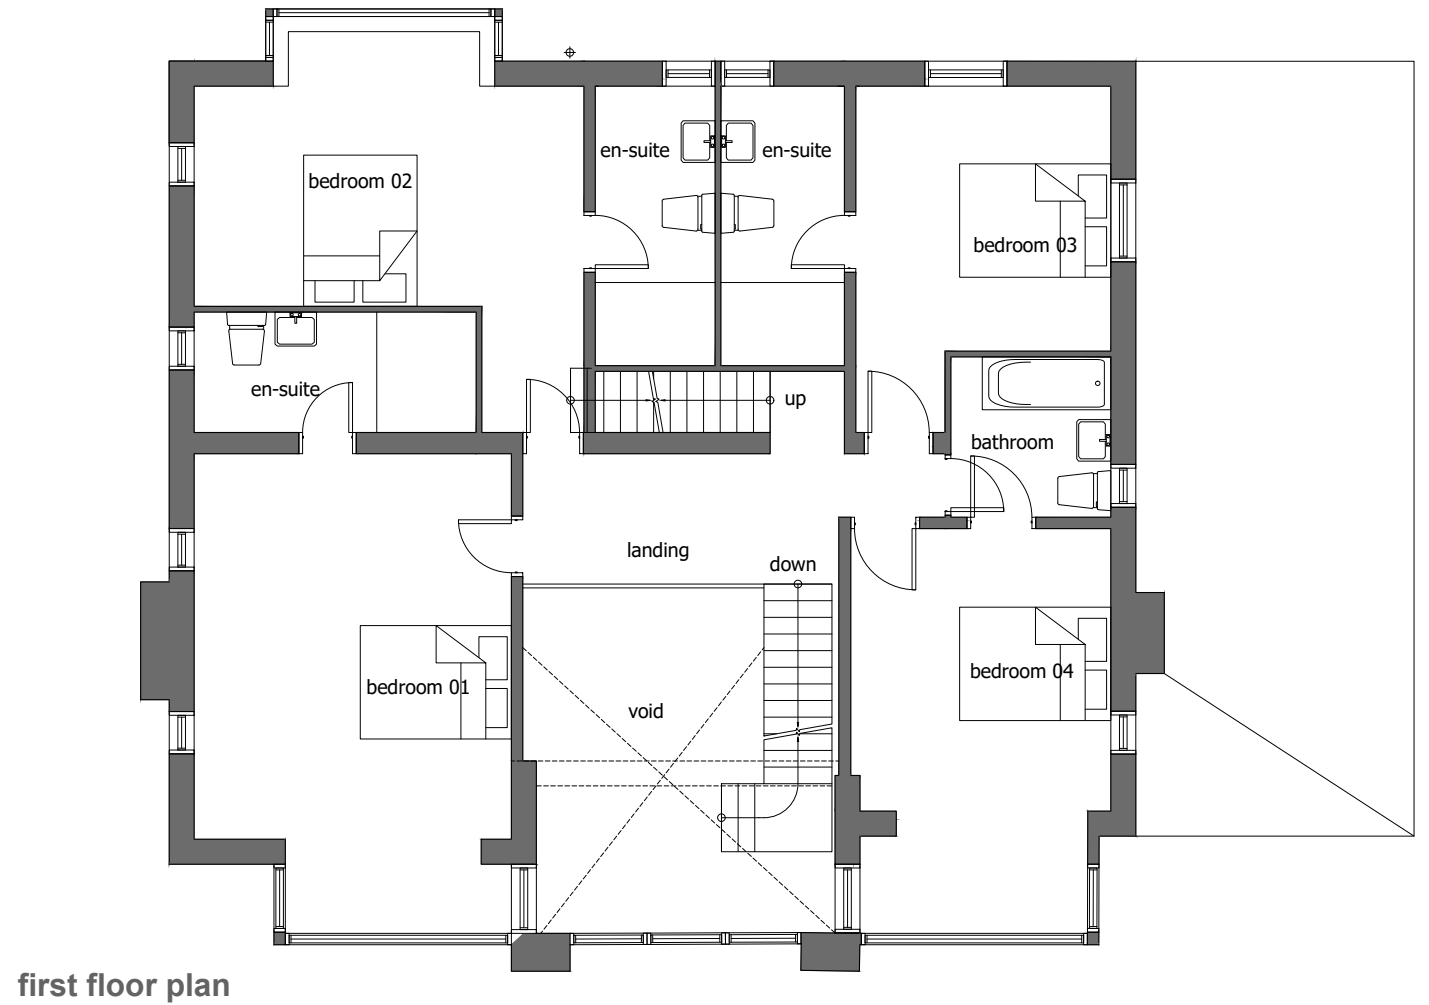


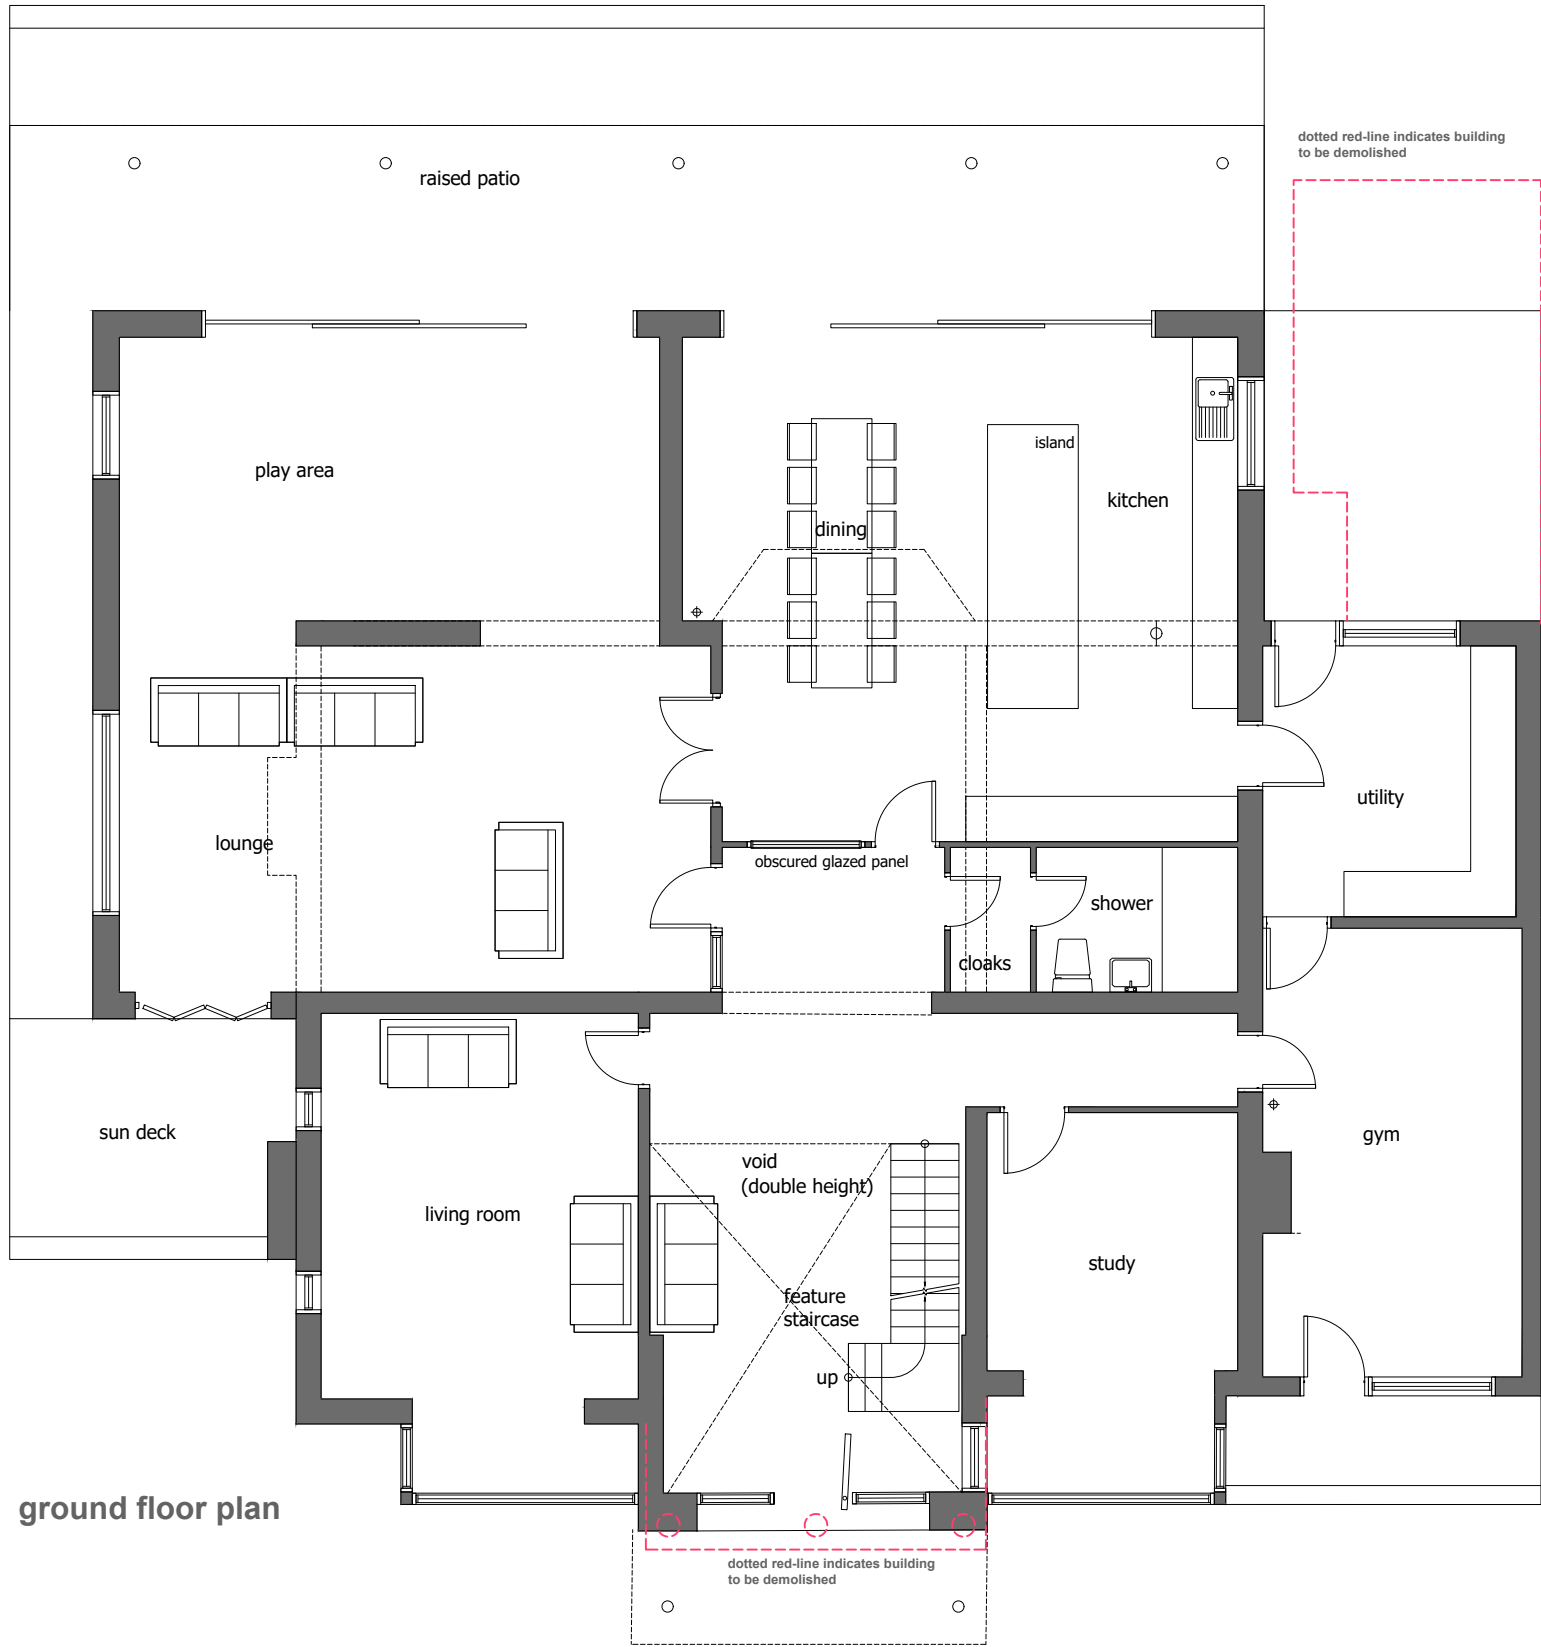

Usman Anjum
The Grange
Grange Avenue
Levenshulme
Manchester

Plans as Proposed

work to figured dimensions

© CJ Partnership owns the copyright of this design / drawing which must not be reproduced in whole or in part without the written permission of CJ Partnership

contract no

3632 04

drawn by
PDC

drawing no

date
June 2022

revision

E

scale @ A3
1:100

Planning

Revisions:
A. Layout redesigned to accommodate modern additions.PDC August 2022
B. Rear lounge reduced in length. PDC, August 2022.
C. Garage converted into a gym.PDC, August 2022
D. Areas/elements to be demolished indicated by dotted red line.PDC, August 2022
E. Size of entrance canopy reduced.PDC, October 2022

Blue Pit Mill Queensway
Castleton Rochdale OL11 2PG

+44 (0)1706 631347
info@cjpartnership.com
www.cjpartnership.com

CJ PARTNERSHIP
ENVIRONMENTAL ARCHITECTS

