
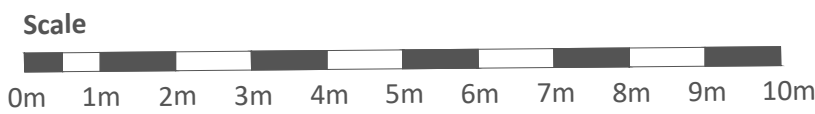


Notes

1. All information shown outside of application boundary is to be considered indicative and subject to separate detailed planning applications.
 2. All dimensions in mm, unless otherwise stated.
 3. Scaling from drawing if printed incorrectly may lead to errors.
 4. All information outside red line boundary shown for contextual purpose only.
 5. All hatch patterns are indicative only unless stated otherwise.
 6. This drawing is to be read in conjunction with the following re-form landscape architecture documentation:
 - CAS-RFM-XX-L0-DR-L-19-0022 Planning Condition Landscape General Arrangement -Level 00
 - CAS-RFM-XX-L01-DR-L-19-0023 Planning Condition Landscape General Arrangement -Level 01
- AND all relevant documentation from the design team
6. Levels information on this drawing illustrates the design intent. The contractor is to check and verify all levels and dimensions against site survey information.
 7. Any discrepancies in the design information are to be brought to the attention of re-form landscape architecture, in writing, prior to commencement of construction works.
 8. All proprietary products shall be installed in strict accordance with manufacturers written instructions.
 9. Refer to other consultants' drawings and specifications for the following design information:
 - Foundation details
 - Base course and/or sub bases design & specification
 - Waterproofing of any element
 - Levels & Drainage design and infrastructure
 - Lighting and ducting
 - Existing & proposed utilities
 10. Plant quantities are to suit site areas in accordance with scheduled plant densities.
 11. Any proposed plant substitution shall be agreed with the landscape architect prior to ordering.

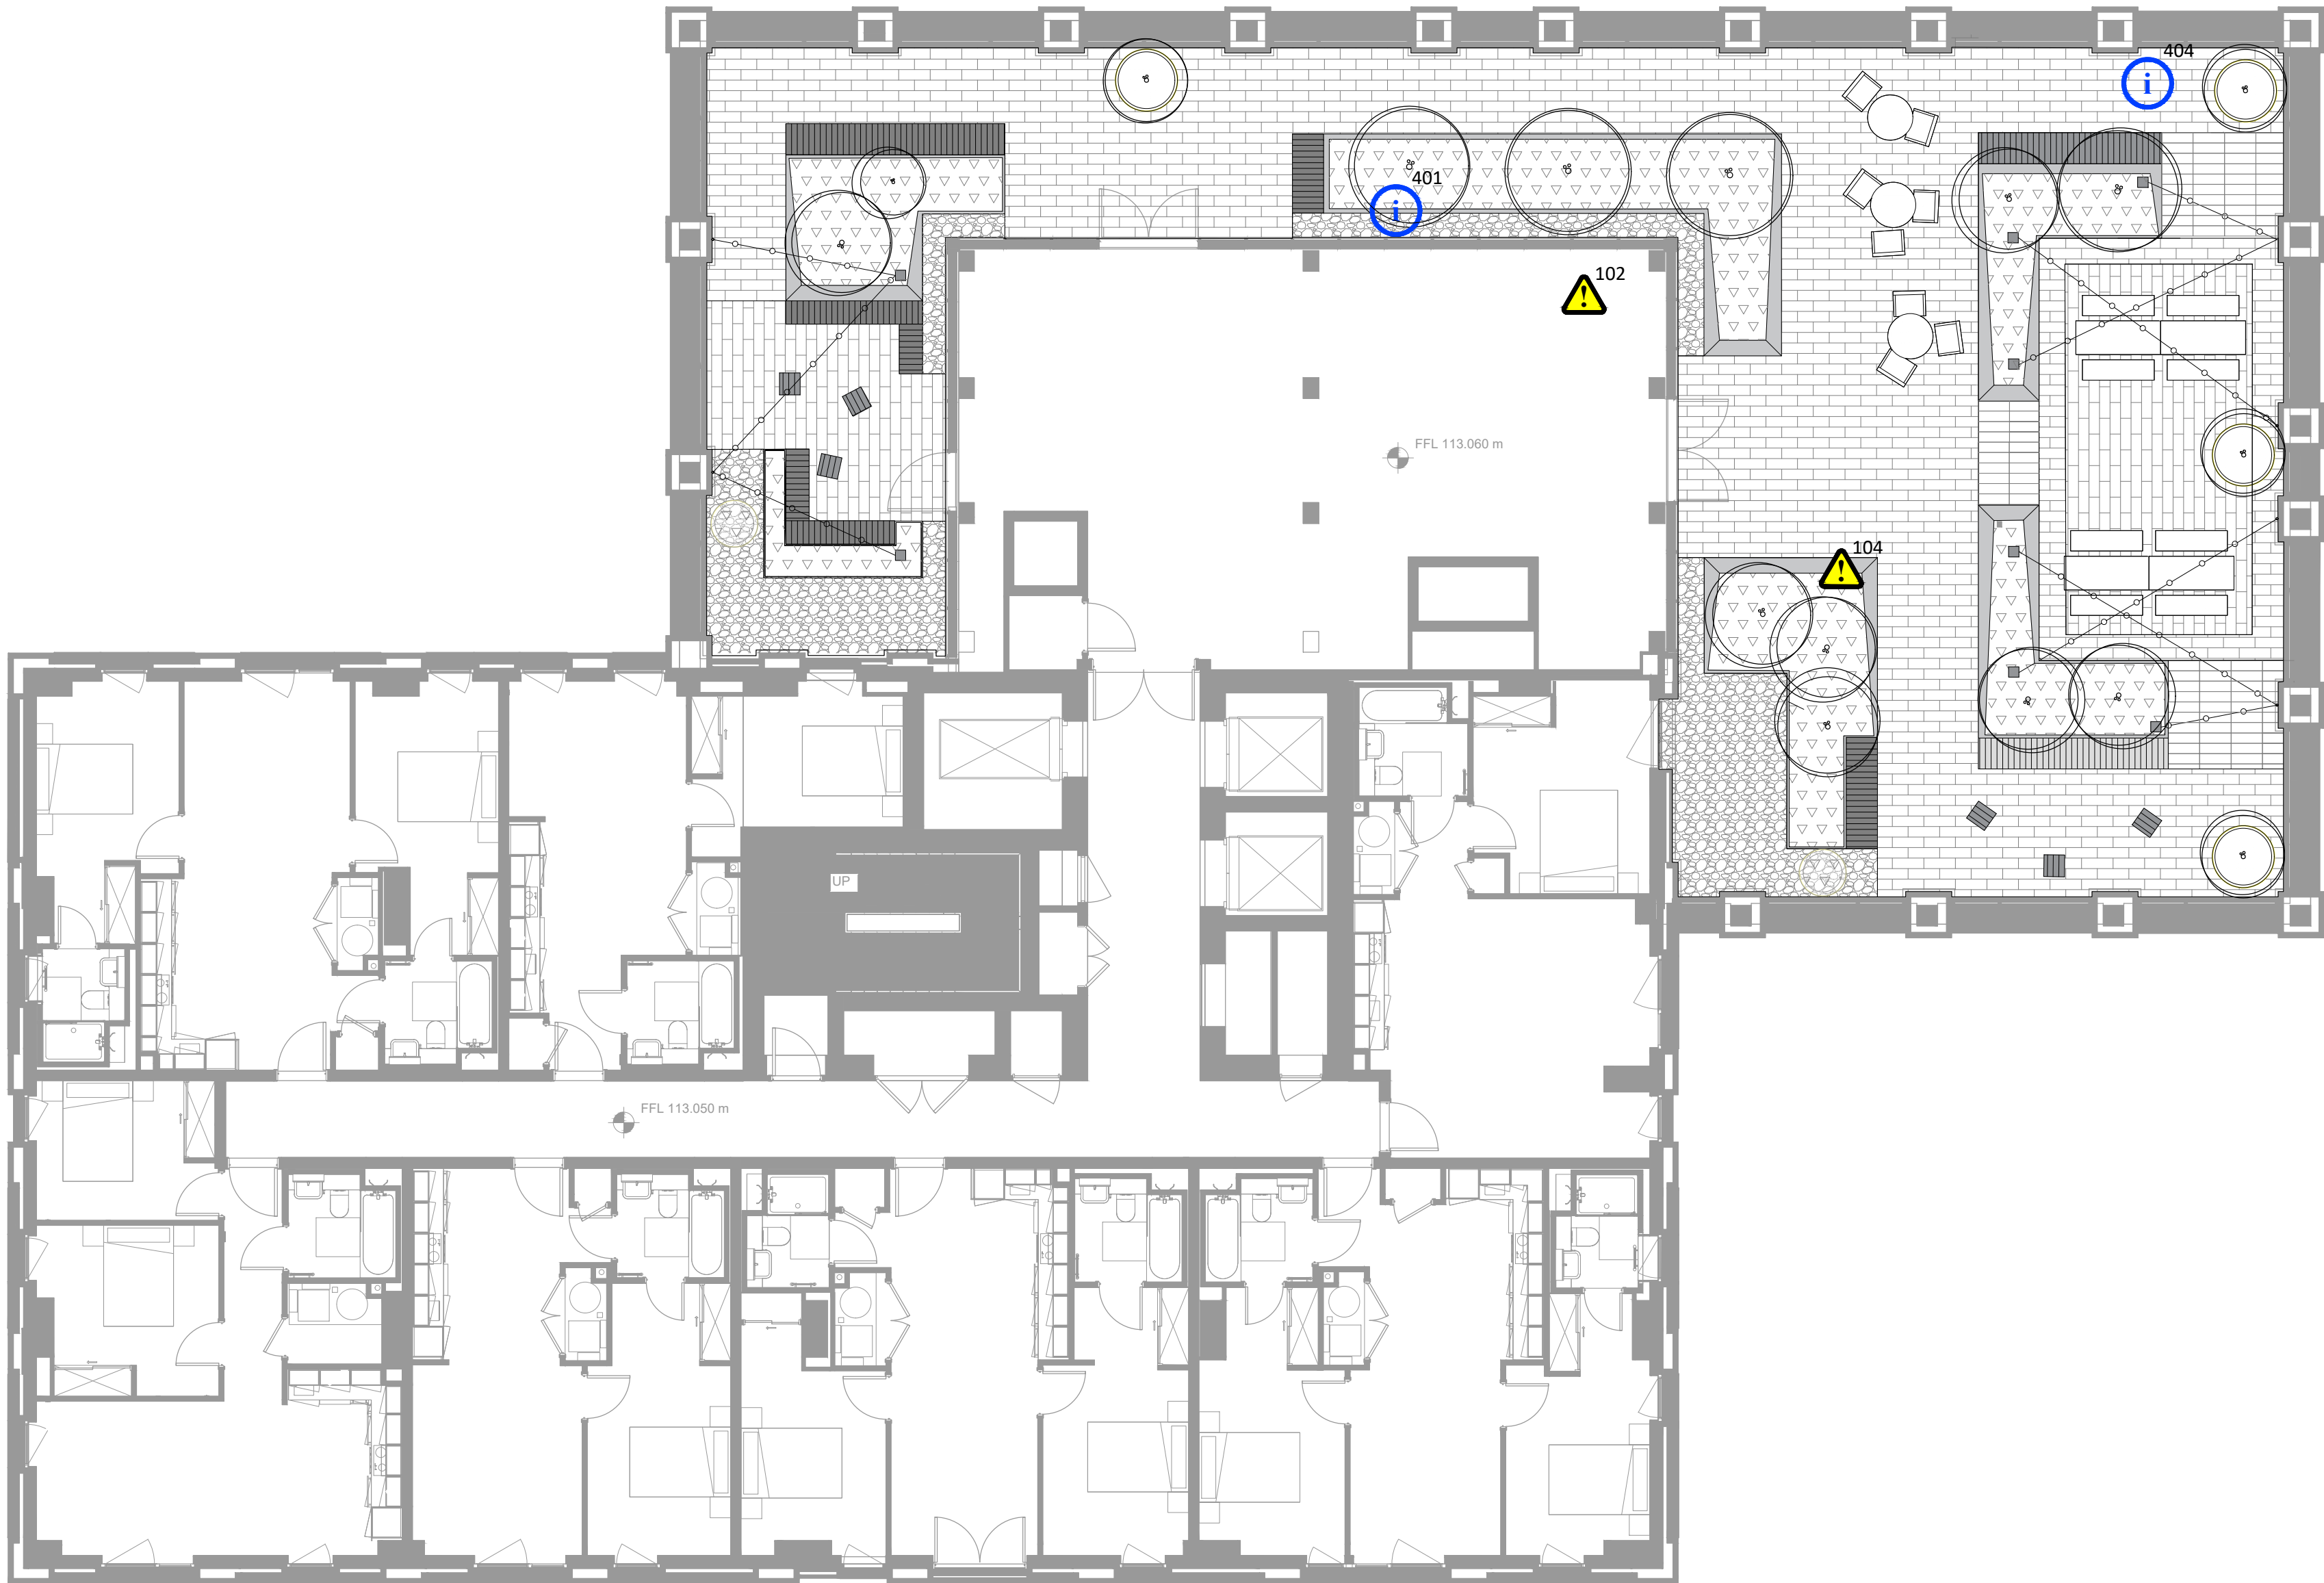

Planning application boundary

Paving type 01 Granite paver
Product: Hardscape Magma granite
Dims: 30mm thickness, 600 x 200mm

Natural aggregate gravel
Product: Moonstone Flint Gravel
Size: 20mm Depth: 50mm

Proposed raised planter
Product: Kinley Systems Prism Planterline
Height: Generally 600mm, rising to 800mm around trees

Timber bench type 01 - Seating integrated into planter system
Product: Kinley Systems Perimeta

Timber seat cube/small table
Product: Vestre KONG Cube (movable)

Movable Bistro seating
Product: Vestre April GO
Type: Timber with powdercoated steel frame

Moveable Table and Benches
Product: Vestre AIR Table, Vestre AIR Bench
Type: Timber with powdercoated steel frame

Lightpost
Bespoke steel columns with catenary lighting.

Indicative layout of catenary lighting.
Refer to specialist fabricator and M&E details
Catenary lighting to be fixed to piers with a central hook.

Proposed tree in soft landscape

Proposed tree in container
Product: Boulevard Kyoto 120
Type: GRP with stone powder
Dims: 1200(Ø) x 900mm(H)

Proposed specimen plants in container
Product: Boulevard Kyoto 90
Dims: 900(Ø) x 700mm(H)

Proposed herbaceous planting

101 Warning of significant hazards or information which may be unusual or difficult to manage

201 Note to contractor to take particular action or carry out specific tasks in a particular way

301 Prohibitive action to avoid something or to refrain from a particular action

401 Significant information needed to convey to the contractor which they may need to be aware of

13.07.22	Discharge Planning Condition	EB	EB	DL	P01
Date	Description of revision	Drawn	Checked	Approved	Revision

re-form
landscape architecture

Beehive Mill, Jersey Street,
Manchester M4 6JG
T: +44 (0)161 397 4953
E: info@re-formlandscape.com
W: re-formlandscape.com

Project
2 HEYROD STREET
RF20-799

Client
PACKAGED LIVING

Document title
PLANNING CONDITION
LANDSCAPE GENERAL ARRANGEMENT - LEVEL 21

Paper size
A1
Scale
1:100

Status
FOR INFORMATION
S2

Drawing number
CAS-RFM-XX-L21-DR-L-19-0024
Revision
P01

© re-form landscape architecture