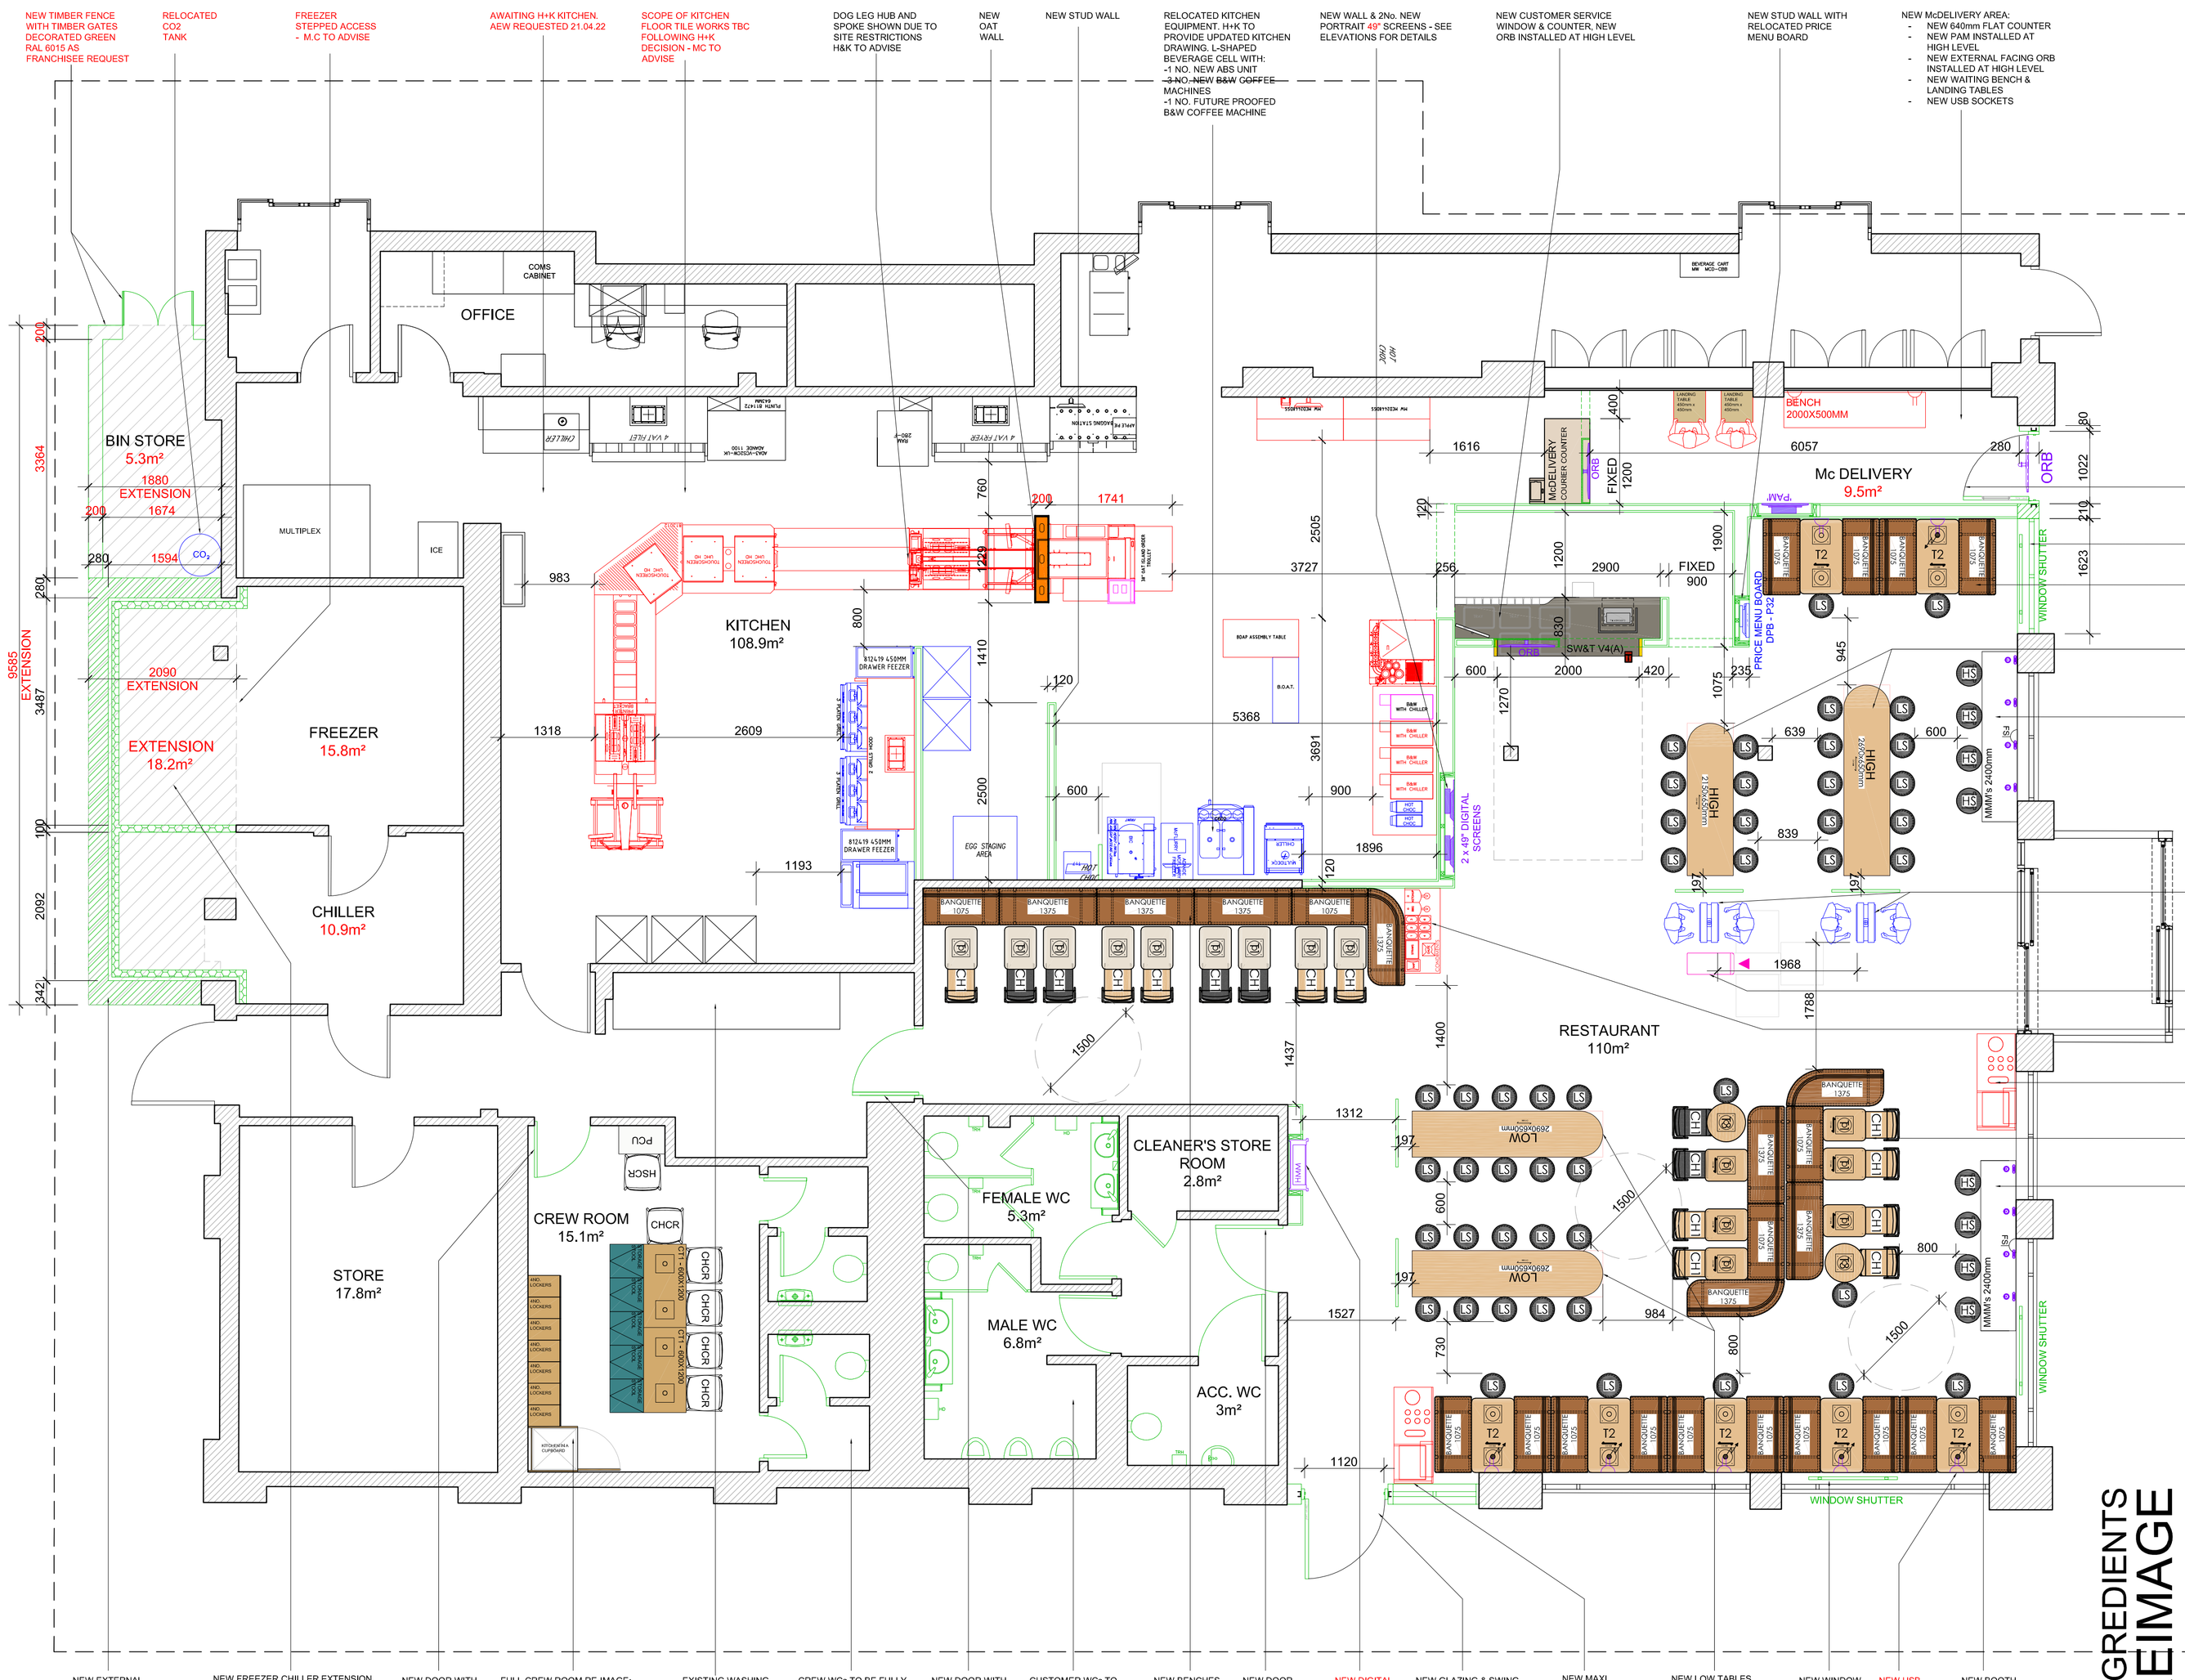


NOTES

- All dimensions and levels are to be checked on site.
- Any discrepancies are to be reported to the architect before any work commences.
- This drawing shall not be scaled to ascertain any dimensions. Work to figured dims only.
- This drawing shall not be reproduced without express written permission from AEW.
- Title overlay drawings and ownership boundaries are produced using all reasonable endeavours. AEW cannot be responsible for the accuracy or scale discrepancy of base plans supplied to them.
- All works are to be undertaken in accordance with Building Regulations and the latest British Standards.
- All proprietary materials and products are to be used strictly in accordance with the manufacturers recommendations.

CDM 2015

Client notified of duties: **At Design Workshops**

Principal Designer: **CSS**

Unless noted below, all known hazards have been highlighted on the drawing:

Notes:
All drawings to be read in conjunction with all other drawings as noted on issue sheet.

2021 CREW ROOM - N.I GREEN 2022_V3

FURNITURE SCHEDULE

STAFF CHAIR	CHROME FRAME WITH WHITE POLYPROPYLENE SEAT SUPPLIED BY DISPLAY WORLD
HIGH STOOL	CHROME FRAME WITH WHITE POLPROPYLENE SEAT SUPPLIED BY DISPLAY WORLD
TABLE 1200 x 600mm	POWDER COATED BLACK PEDESTAL CT1 TABLE TOP FINISHED IN FORMICA LAMINATE NEVADA OAK F8588
TABLE 600 x 600mm	POWDER COATED BLACK PEDESTAL CT2 TABLE TOP FINISHED IN FORMICA LAMINATE NEVADA OAK F8588 SUPPLIED BY DISPLAY WORLD.
PC UNIT	BLACK FRAME WITH M10 CONJUNTERSUNK HOLES, WHITE LAMINATE WORK TOP WITH DOLKEN EDGING 650 L x 400 D x 1000 H SUPPLIED BY DISPLAY WORLD
HELMSMAN LOCKERS	BANKS OF 4 STANDARD OR 10 WALLET LOCKETS AVAILABLE WITH OR WITHOUT USB CHARGING DOOR FINISH IN FORMICA COMPACT - RANDOM PATTERN TO MATCH VISUAL 1. FORMICA - F7879 DUSTY JADE 2. FORMICA - F2256 POLAR WHITE MAIN BODY FINHISED IN FORMICA LAMINATE NEVADA OAK F8588
STORAGE STOOL	TOP OF STOOL UPHOLSTERED SEAT PAD - JEMO 7044.04 - VESCOM STOOL BASE FORMICA LAMINATE NEVADA OAK F8588 SUPPLIED BY DISPLAY WORLD
BENCH 2000X500MM	SIMPLE BENCH TOP OF STOOL UPHOLSTERED SEAT PAD - JEMO 7044.04 - VESCOM BENCH LEGS IN FORMICA LAMINATE NEVADA OAK F8588 SUPPLIED BY DISPLAY WORLD - TO BE SIGNED OFF BY NW
KITCHEN IN A CUPBOARD	KITCHEN IN A CUPBOARD FINISHED IN FORMICA LAMINATE NEVADA OAK F8588

MARKETING ELEMENTS 2022_V5

	DIGITAL PRICE BOARD - 32" DPB-P32
	DIGITAL WINDOW POSTER (INSTORE) - 46" EXTERIOR FACING - DWP EX-P46 INTERIOR FACING - DWP IN-P46
	ORDER READY BOARD- 32" ORB-132
	DOUBLED SIDE SELF ORDER KIOSK (SOK)
	SINGLE SIDED SELF ORDER KIOSK (SOK)
	AIRCHARGE MOBILE PHONE CHARGING SOLUTION
	TABLET TABLE, 700mm SCREEN IN SCHEME SPECIFIC LAMINATE IF POWER/DATA CANT BE ACCESSED THROUGH FLOOR.

COLOUR REFERENCE

NEW EQUIPMENT/FURNITURE (OR INDICATED BY COLOURED HATCH)
EXISTING/FURNITURE EQUIPMENT
RELOCATED/FURNITURE EQUIPMENT
FUTURE/OPTIONAL EQUIPMENT
MERCHANDISING EQUIPMENT
NEW CONSTRUCTION
EXISTING STRUCTURE TO BE REMOVED
EXISTING 30 MINUTE FIRE RATE WALL
EXISTING 60 MINUTE FIRE RATE WALL
PROPOSED 30 MINUTE FIRE RATE WALL
PROPOSED 60 MINUTE FIRE RATE WALL

AREAS SCHEDULE	EXISTING	PROPOSED
TOTAL COVERS	127	120
DINING AREA INTERNAL AREA (m²)	172m²	110m²
WC INTERNAL AREA (m²)	15m²	15m²
CREW ROOM INTERNAL AREA (m²)	21m²	21m²

NOTE: AWAITING SPEC OF ESSENTIAL INGREDIENTS SCHEME. DETAILS TBC
AIRCHARGE & PLUG SOCKETS TO BE CONTROLLED BY MASTER SWITCH

DRAWINGS BASED ON:
AS BUILT: 6493_AEW_0434_0050_E
H&K - DIN-24803 UK434 Failsworth CFG Rev A

PROPOSED GENERAL ARRANGEMENT PLAN 1:50

ESSENTIAL INGREDIENTS
COTF & REIMAGE

Rev	Date	Drawn	Checked
A	20/05/2022	MA	MW
	UPDATED FOLLOWING STAGE 1 MEETING 11.05.22 -NEW USB SOCKETS TO ALL BOOTHS -RELOCATED CO2 TANK -NEW TIMBER FENCE WITH TIMBER GATES -NEW DIGITAL HMU		

DESIGN WORKING GROUP APPROVED

REV	Date	Drawn by: -	Checked by: -
-	04/04/22	MA	MW
	Initial Issue		

Status: **S2** Purpose of Issue: **For Approval**

drawing stage: **STAGE 1**

client: **McDonald's Restaurants Ltd**

project: **1169 OLDHAM ROAD FAILSWORTH M40 2FU** store: **0434**

drawing title: **PROPOSED GA PLAN COTF**

date: **04.04.22** drawn: **MA**

scale@A1: **1:50** checked: **MW**

Job No **12824_AEW_0434_0050** Rev **A**

aew architects
0161 214 4370
www.aewarchitects.com