


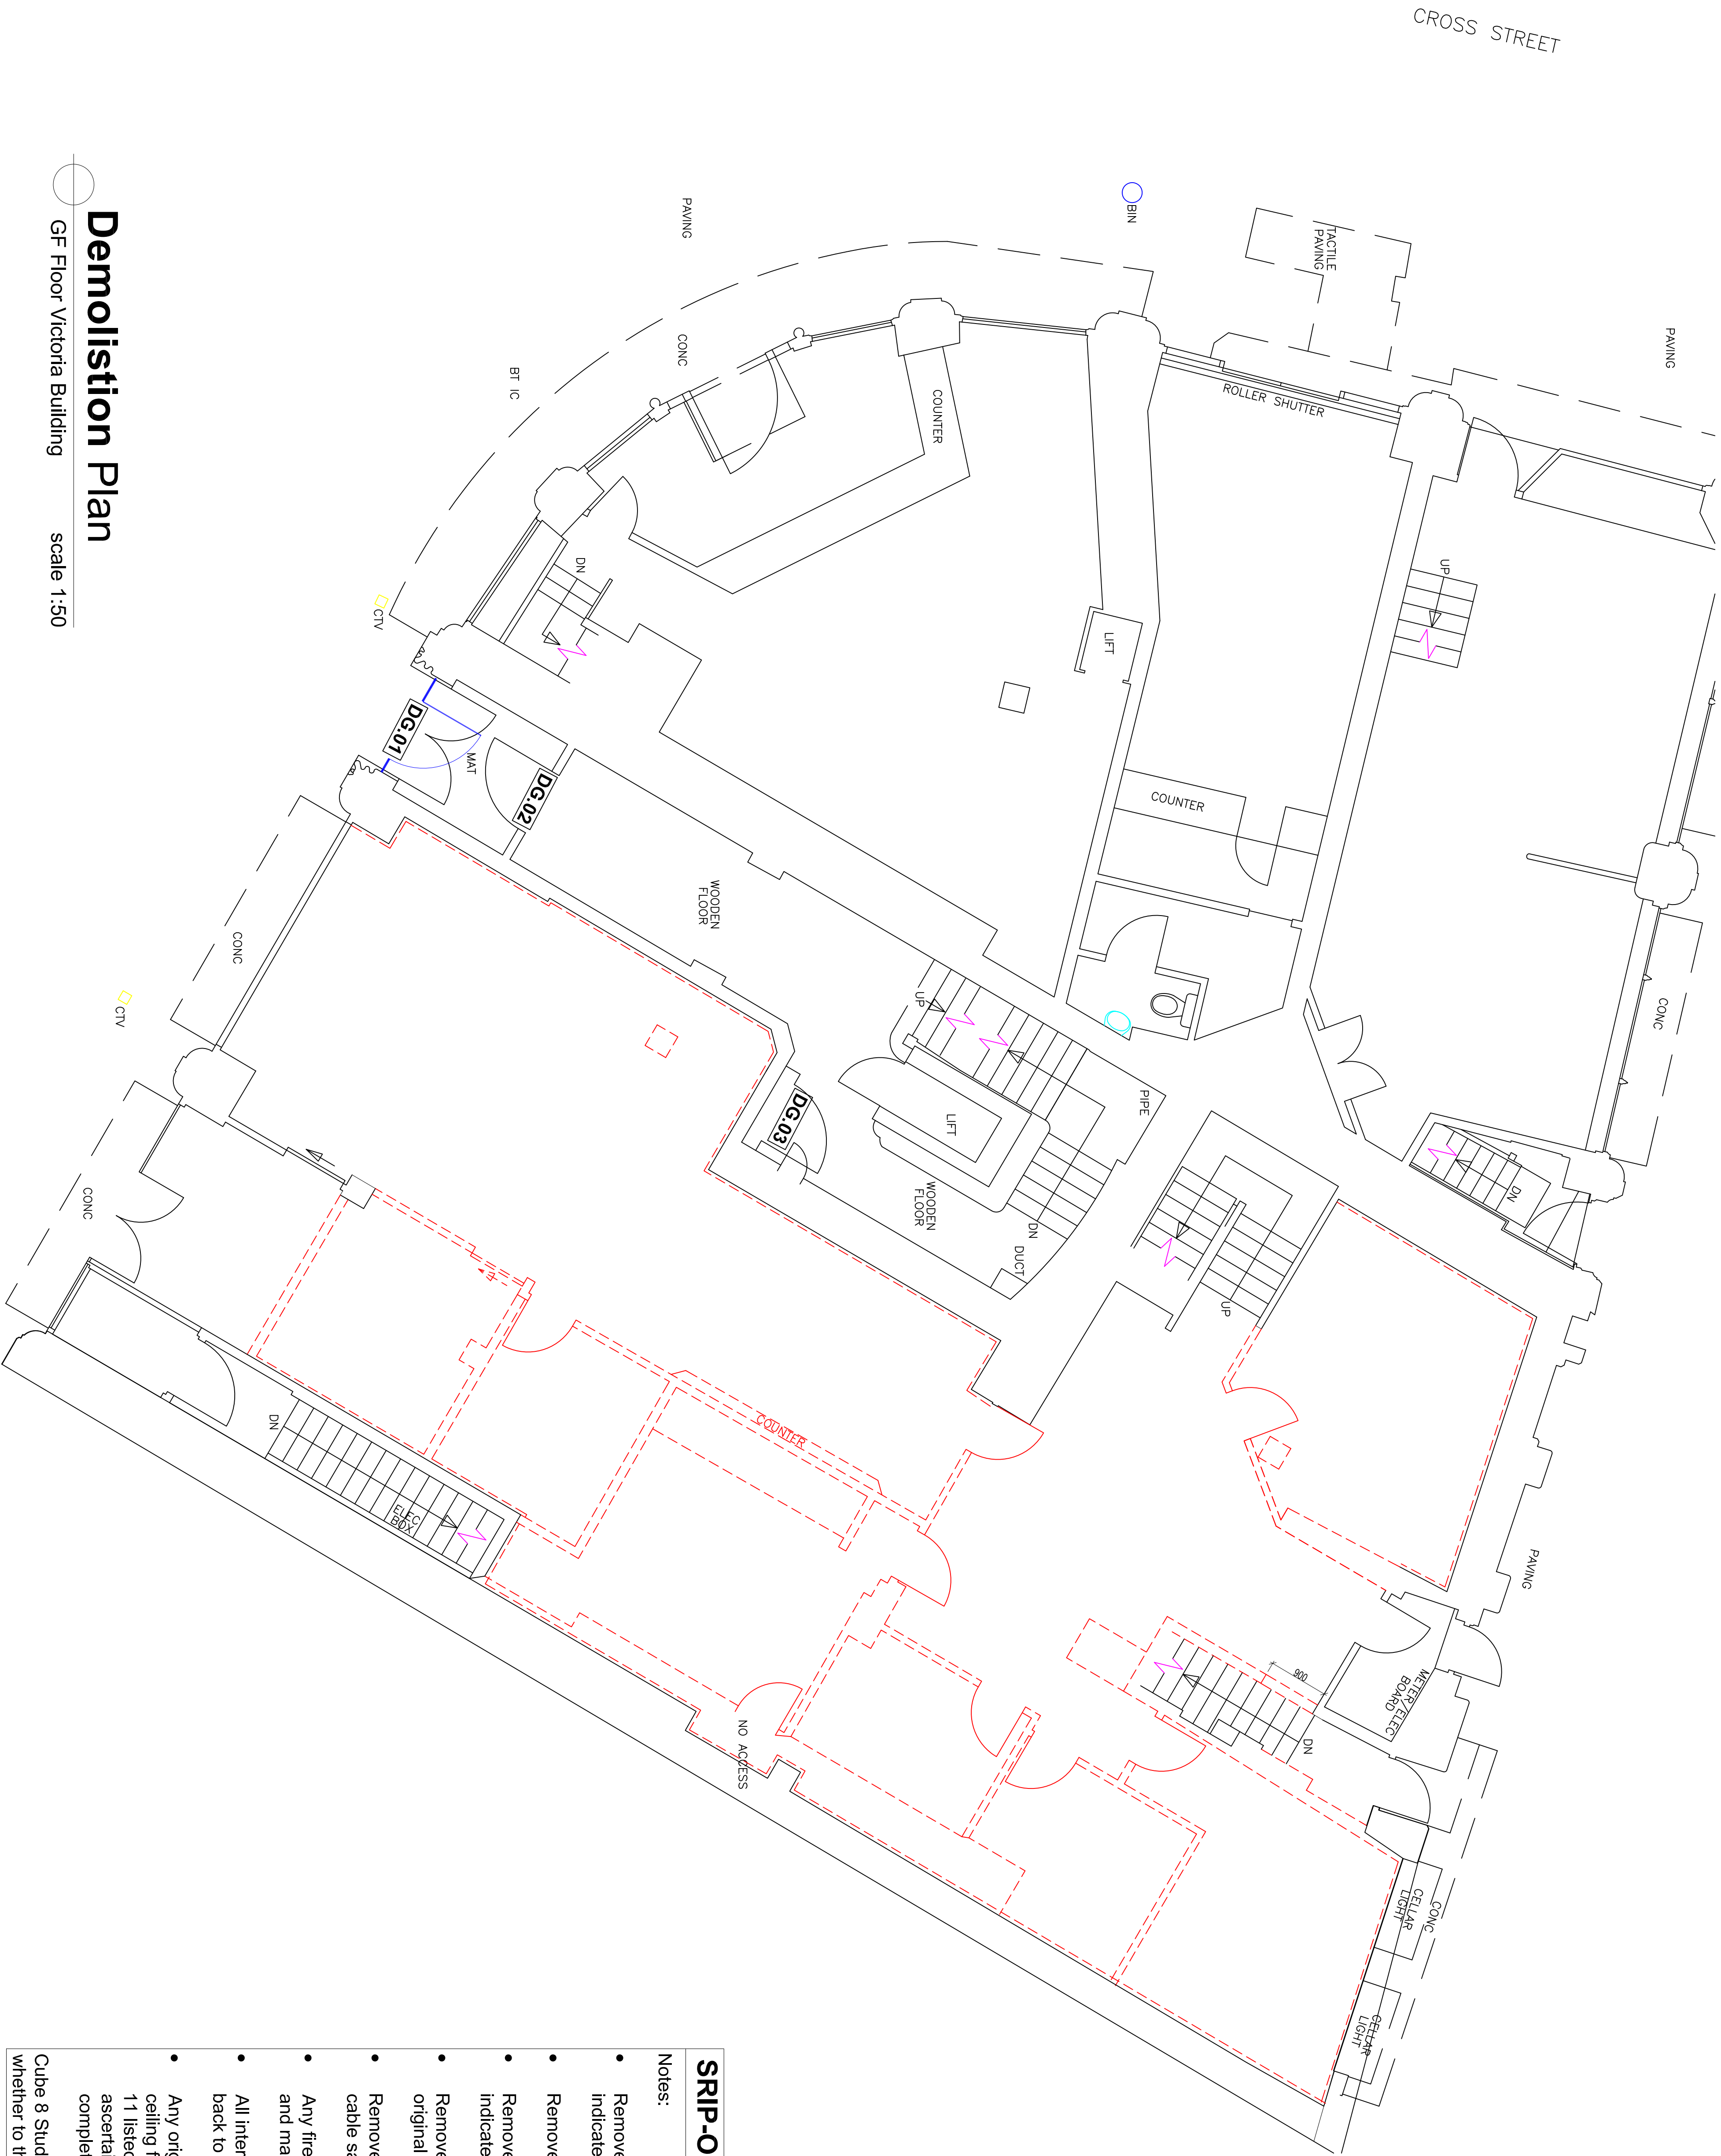

SRIP-OUT & DEMOLITION

Notes:

- Remove all dry-lining and partitions and doors indicated in red.
- Remove all floor carpets only.
- Remove all Sanitary-ware and kitchens as indicated on the drawing.
- Remove all suspended ceiling and MF to expose original ceiling.
- Remove all compact fluorescent lights and make cable safe.
- Any fire alarm fittings are to securely taped up and made safe.
- All interior existing solid walls are to be stripped back to original finish.
- Any original fittings, walls, joinery, flooring and ceiling features to be left. The building is grade 11 listed. An inspection will need to be done to ascertain what's listed once strip out is completed.

Cube 8 Studio are to be contacted if you are unsure whether to the strip-out items that are original or add

Demolition Plan

GF Floor Victoria Building

scale 1:50

CLIENT:

Armenian Experience

BUILDING:

Victoria Buildings
1-7 Princess Street
Manchester
M2 4DF

DRAWING TITLE:

Existing Fit-Out Demolition Plan

DRAWN BY:

James C Scott

DATE:

March 2022

SIZE:

A1

REV:

DWG. No.:

C8S_10194.0.2

SCALE:

1:50

DOC FOR:

For Site

CUBE8
STUDIO

COPYRIGHT: The copyright in this drawing is vested in Cube8 Studio Ltd and no licence or assignment of any kind has been, or is, granted to any third party whether by provision of copies or originals of the drawings or otherwise unless otherwise agreed in writing. DO NOT SCALE FROM THIS DRAWING.

BUILDING APPRAISAL | HUMAN-CENTERED DESIGN | SPACE PLANNING | INTERIOR DESIGN & ARCHITECTURE | BRAND & IDENTITY | FURNITURE & ACCESSORIES | 3D VISUALISATION | PROJECT MANAGEMENT |

0161 849239

info@cube8studio.com

studio 427, The Mels, Mcr

Black & White Bld, London

www.cube8studio.com

