



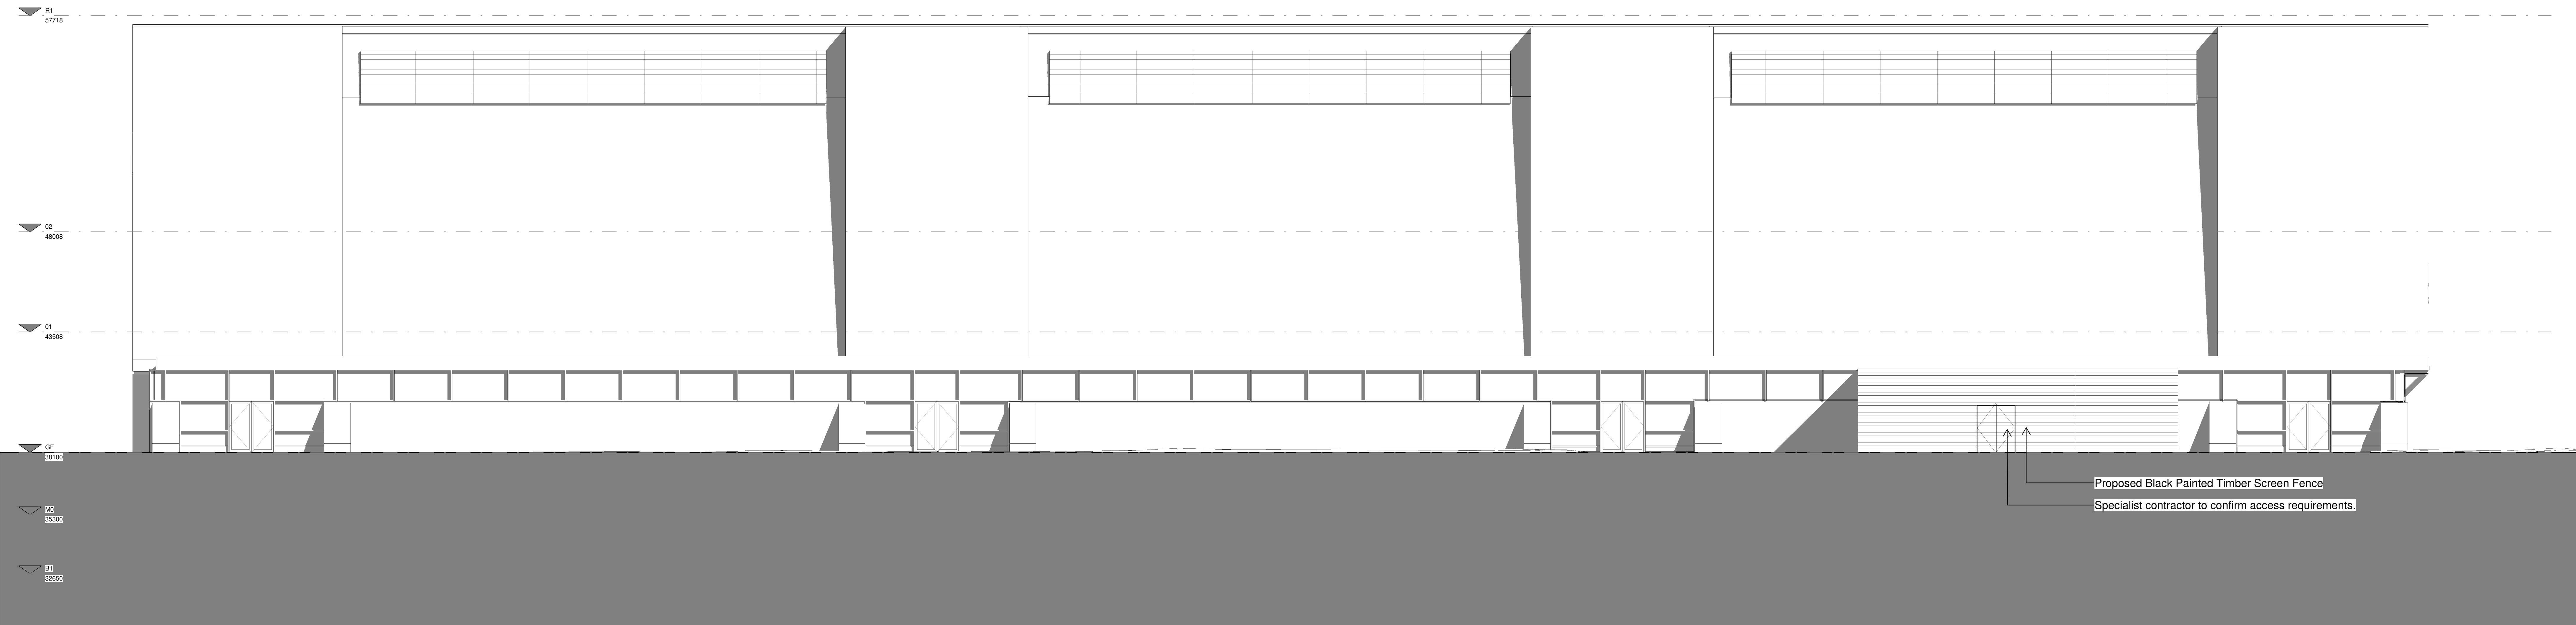


01 | North Elevation
1 : 100

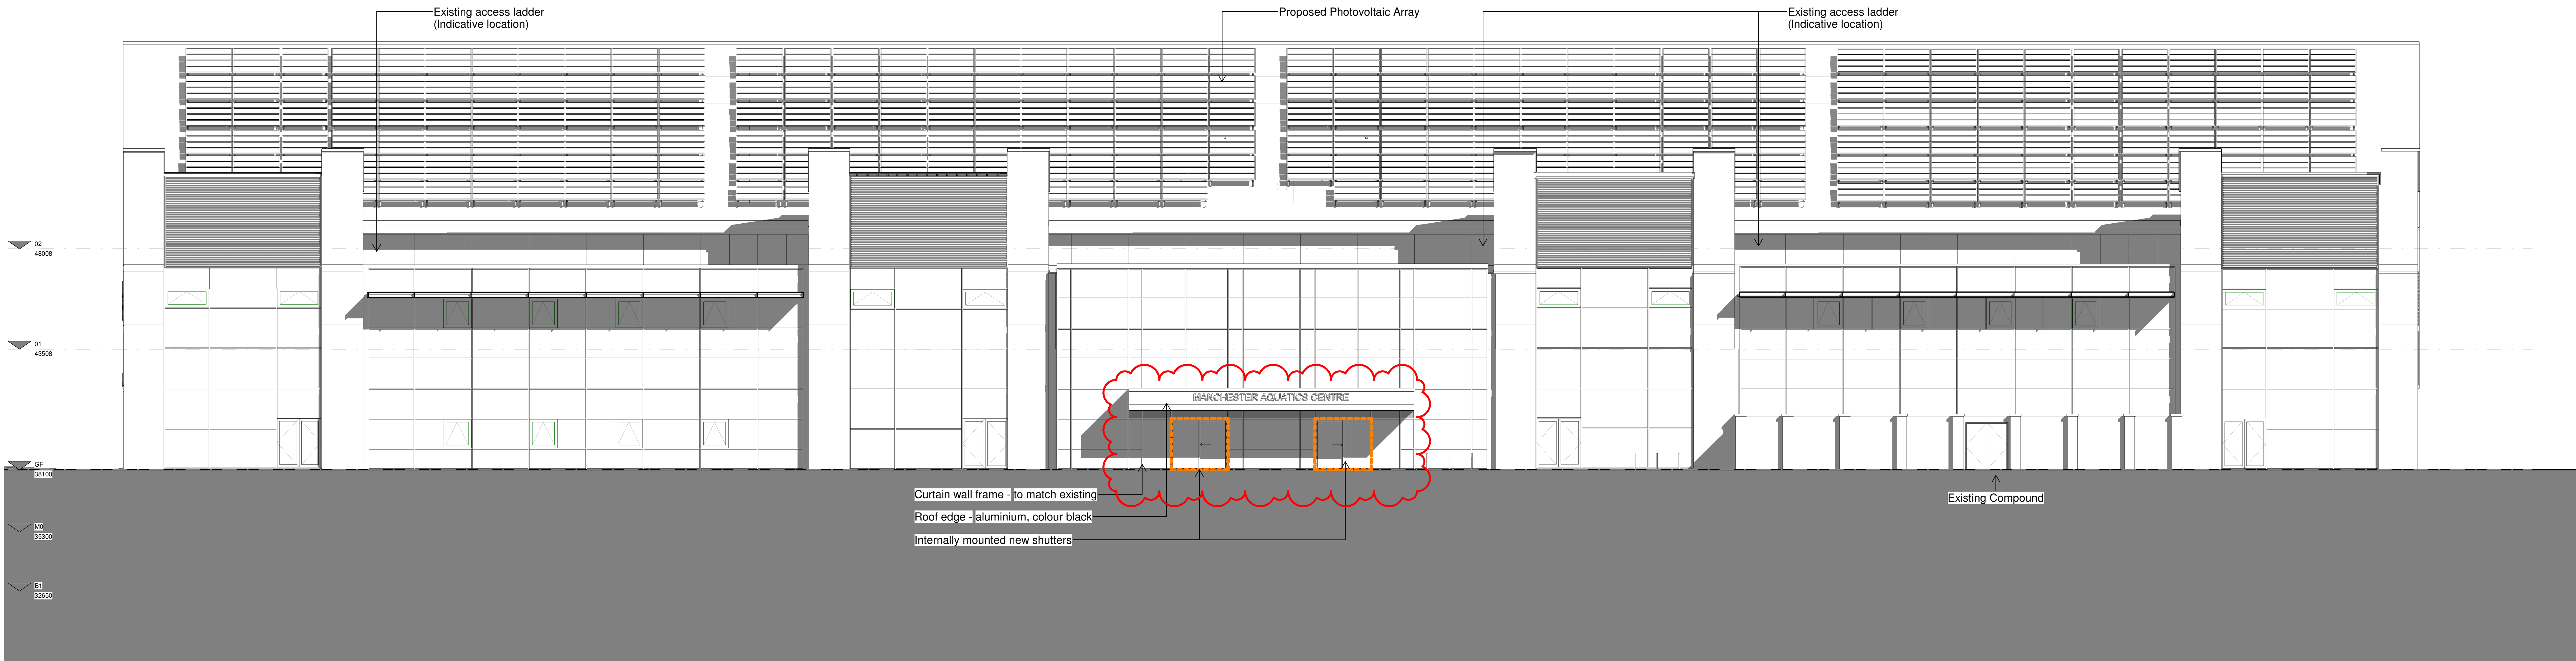

03 | South Elevation
1 : 100

REV	DATE	BY	REVISION NOTES	NOTES
A	30.06.21	DAS	Photovoltaic array indicated & ASPHP compound indicated.	Levels and Geometry based on Existing Survey.
B	22.07.21	DJ	Stage 3 issue.	SECURITY:
C	13.08.21	DJ	Updates to client comments. Mark up drawings dated 04.08.2021.	Internally mounted new shutter doors. -----
D	26.08.21	DJ	Planning Issue.	
E	12.10.21	DJ	Planning Issue. Door security note and new shutter locations indicated.	All external doors (single and double leaf) must be compliant with and certified to BS PAS 24:2012, S1500, or LPS 1175 SPC.
F	17.01.22	DJ	Stage 5 issue - QA verifications.	All sliding doors should be tested and certified to ENY 1627-30 (WKC+) and incorporate laminated glazing, have multi-point locking (preventing sliding and lifting).
G	18.02.22	DJ	Environmental lobby revised.	
H	20.02.22	DJ	Planning Issue.	Guardrail and walkway system information is awaited to be included on the drawings.

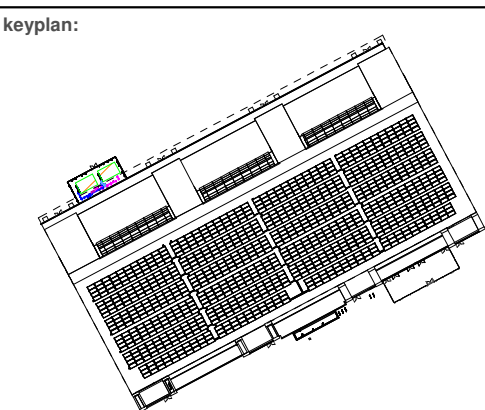

client: Manchester City Council
project: Manchester Aquatics Centre
title: Proposed North & South Elevation
POZZI job no: PS471
BS drawing no: MAC-PAL-Z0-ZZ-DR-A-3000

status: Planning
revision: C3
drawing no: 3000
date: 30.06.2021
scale: As indicated
drawn by: DJ

pozzoni
Woodville House
2 Woodville Road | Altrincham | W14 4 2TH
t: 0161 825 7948
e: info@pozzoni.co.uk
w: www.pozzoni.co.uk