




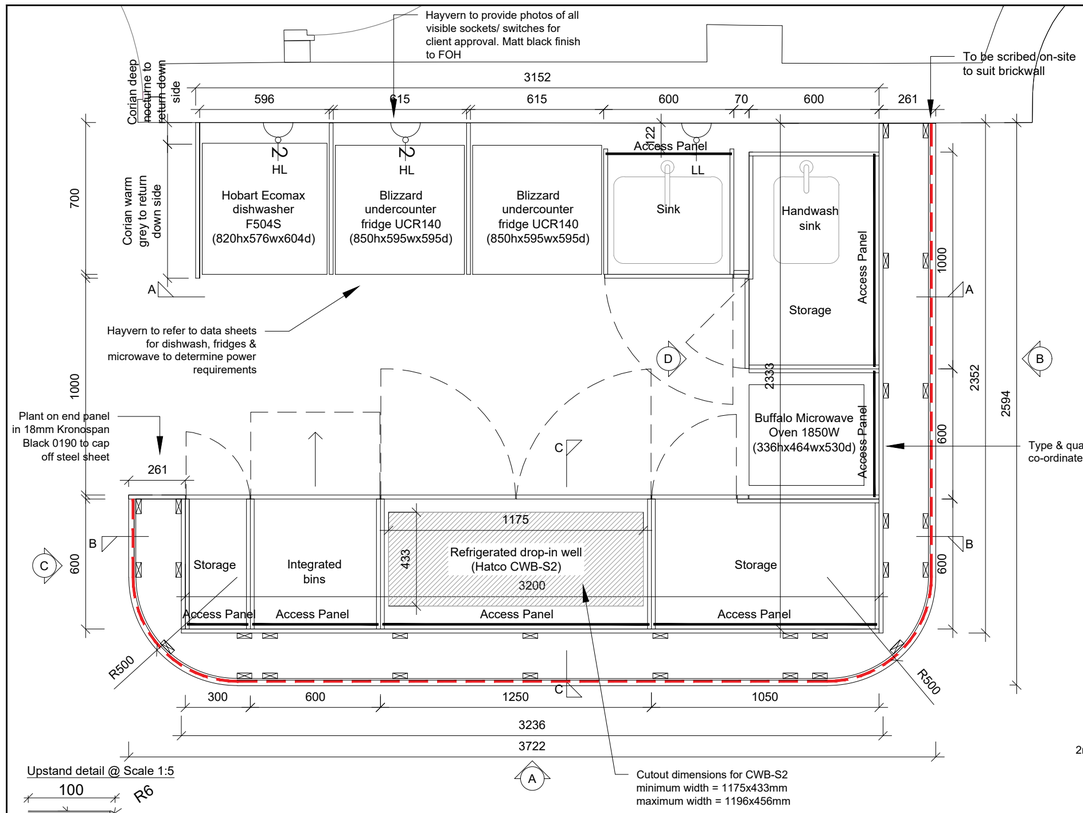


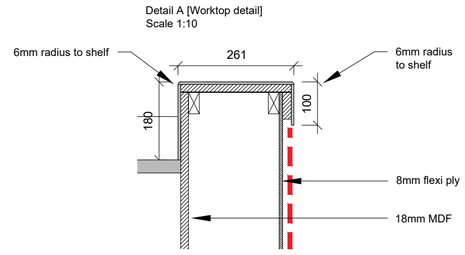


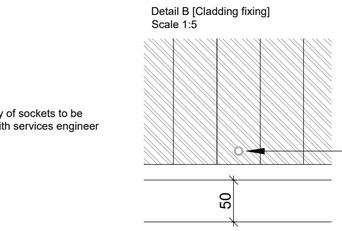


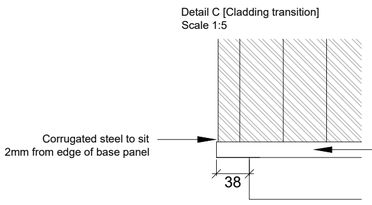


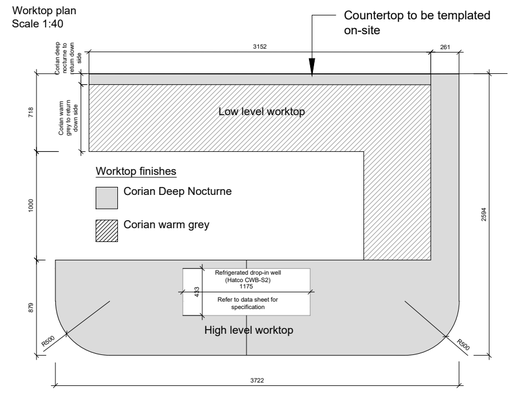


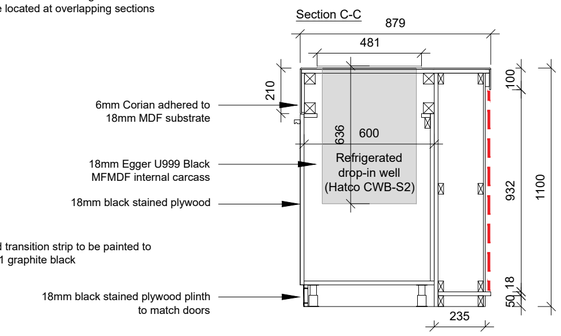


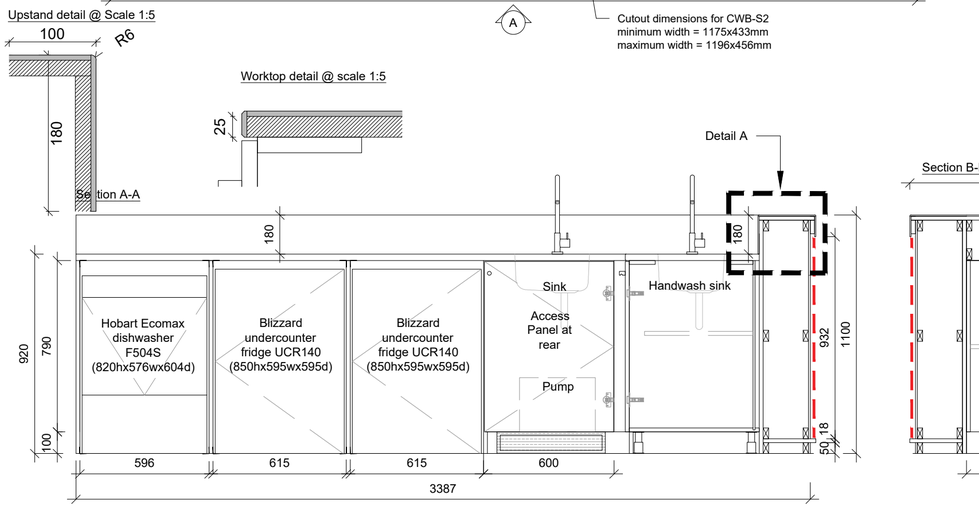


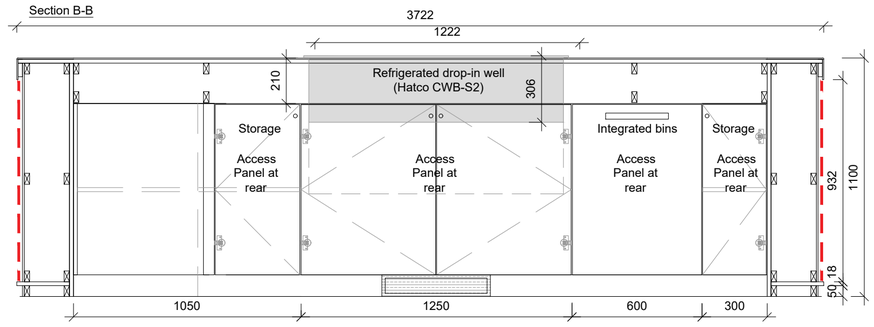

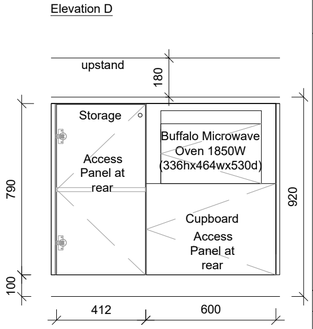

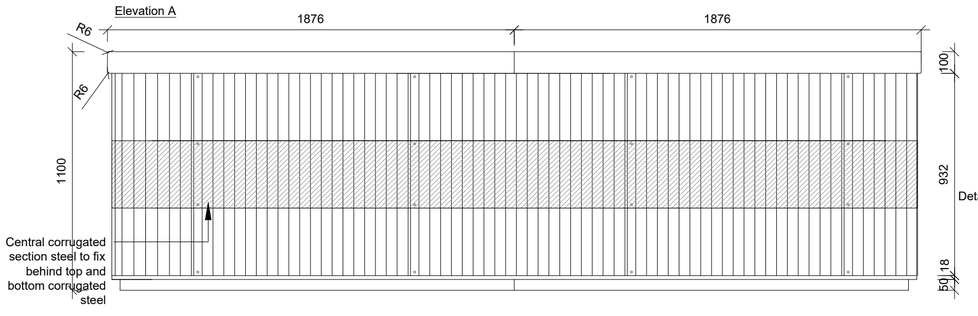

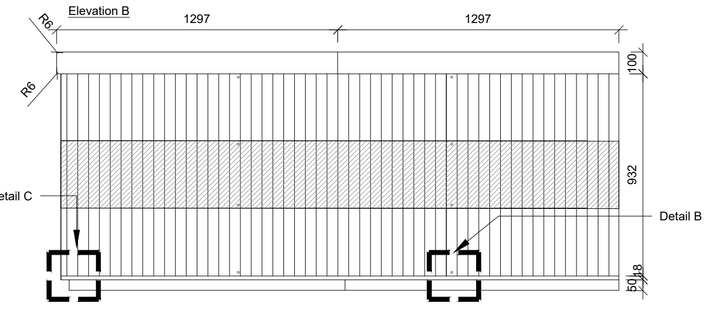

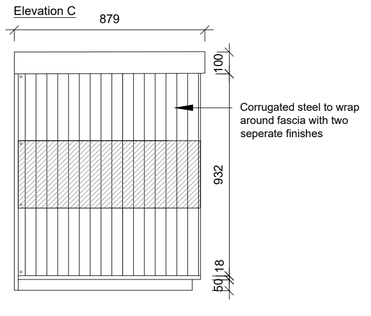

Notes:

Do not scale from this drawing. All dimensions to be checked on-site by contractor to ensure accuracy prior to any installation. All design work produced by Amspec Ltd is for indicative purposes only. It is the client and contractors responsibility to ensure that building control and fire officer approval have been met prior to commencement of site work

Materials	Description
High Worktop:	6mm Nocturne Corian adhered to 18mm MDF substrate, sanded to matt finish [sealant to match]
Low Worktop:	6mm Warm Grey Corian adhered to 25mm MDF substrate, sanded to matt finish [sealant to match]
Worktop edges:	6mm Nocturne Corian adhered to 8mm flexi ply substrate, sanded to matt finish [sealant to match]
Upper & lower cladding:	0.5mm corrugated metal sheeting PPC to RAL 9011 graphite black, gloss sheen
Central cladding:	0.5mm corrugated metal sheeting PPC to RAL 7021 black grey, matt sheen
Cupboard doors:	18mm Black stained plywood with clear 5% lacquer (edges not to be stained) TBC
Internal carcass:	18mm MFMDF in Kronospan Black 0190 with 2mm matching ABS edging
Plinth:	18mm MDF sprayed to RAL 9011 graphite black with clear 5% lacquer
Cladding substrate:	8mm flexi plywood
Grilles:	500x100mm Black plinth grille aluminium finished to RAL 9011 matt finish
Handwash sink:	Kubus KBX 110-34 stainless steel (370x430x175mm)
Sink:	Kubus KBX 110-45 stainless steel (480x430x180mm)
Taps:	Kohler purist monobloc matt black
Door pull:	A&H brass scoop cupboard knob 18mm matt black
Door handle:	A&H brass kuller cabinet handle 288x12mm matt black
Integrated bins:	Pull out waste bin Vauth-Sagel VS Envi Space 515mm ref: 503.17.304 (2 x 35ltr, 1 x 21ltr)
Refrigerated well:	Hatco CWB-S2 (1222x481) slim drop in well
Fridges:	2no. Blizzard undercounter fridge UCR140
Dishwasher:	Hobart Ecomax dishwasher F504S
Microwave:	Buffalo microwave oven 1850W

Corrugated metal sheet locations

REV:	DESCRIPTION:	BY:	DATE:

STATUS: AS BUILT

amspec
DESIGN & BUILD SOLUTIONS
t : 01942 621342 f : 01942 226552
www.amspec.co.uk

CLIENT: OBI
80 MOSLEY STREET
MANCHESTER
M2 3FX

ARCHITECT:

SITE: 18 LOWER BYROM STREET MANCHESTER

TITLE: COFFEE COUNTER RECEPTION

SCALE AT A2:	DATE:	DRAWN:	CHECKED:
1:20	24.06.19	CR	IC

PROJECT NO:	DRAWING NO:	REVISION:
1684	DP_dJ-20	