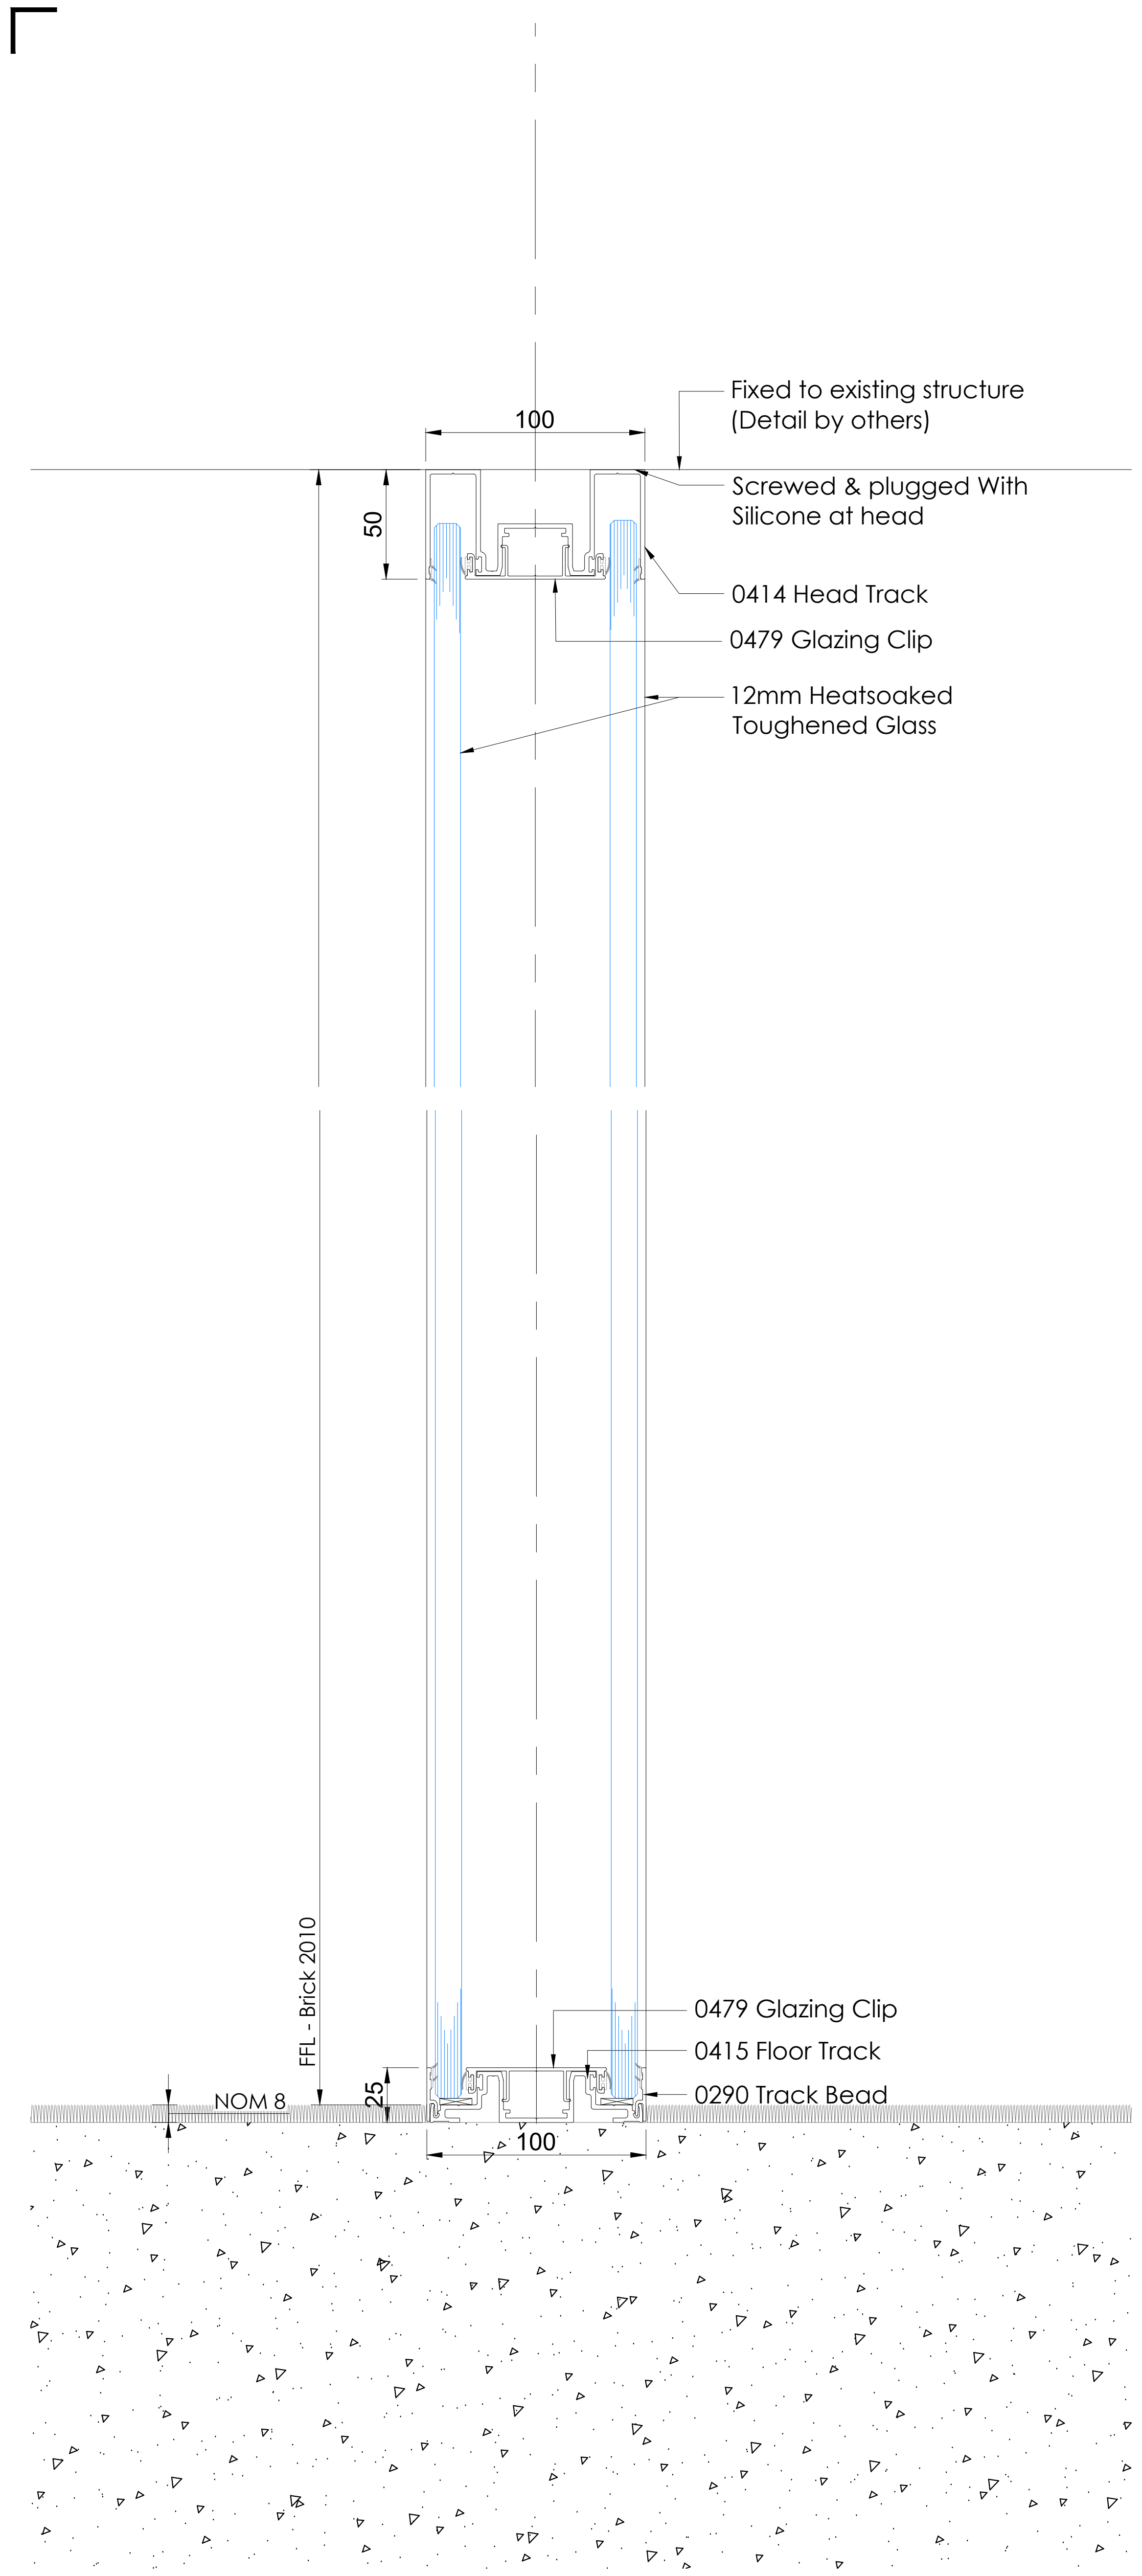

1 SECTION: Screen 8
Revolution 100
Scale 1:2

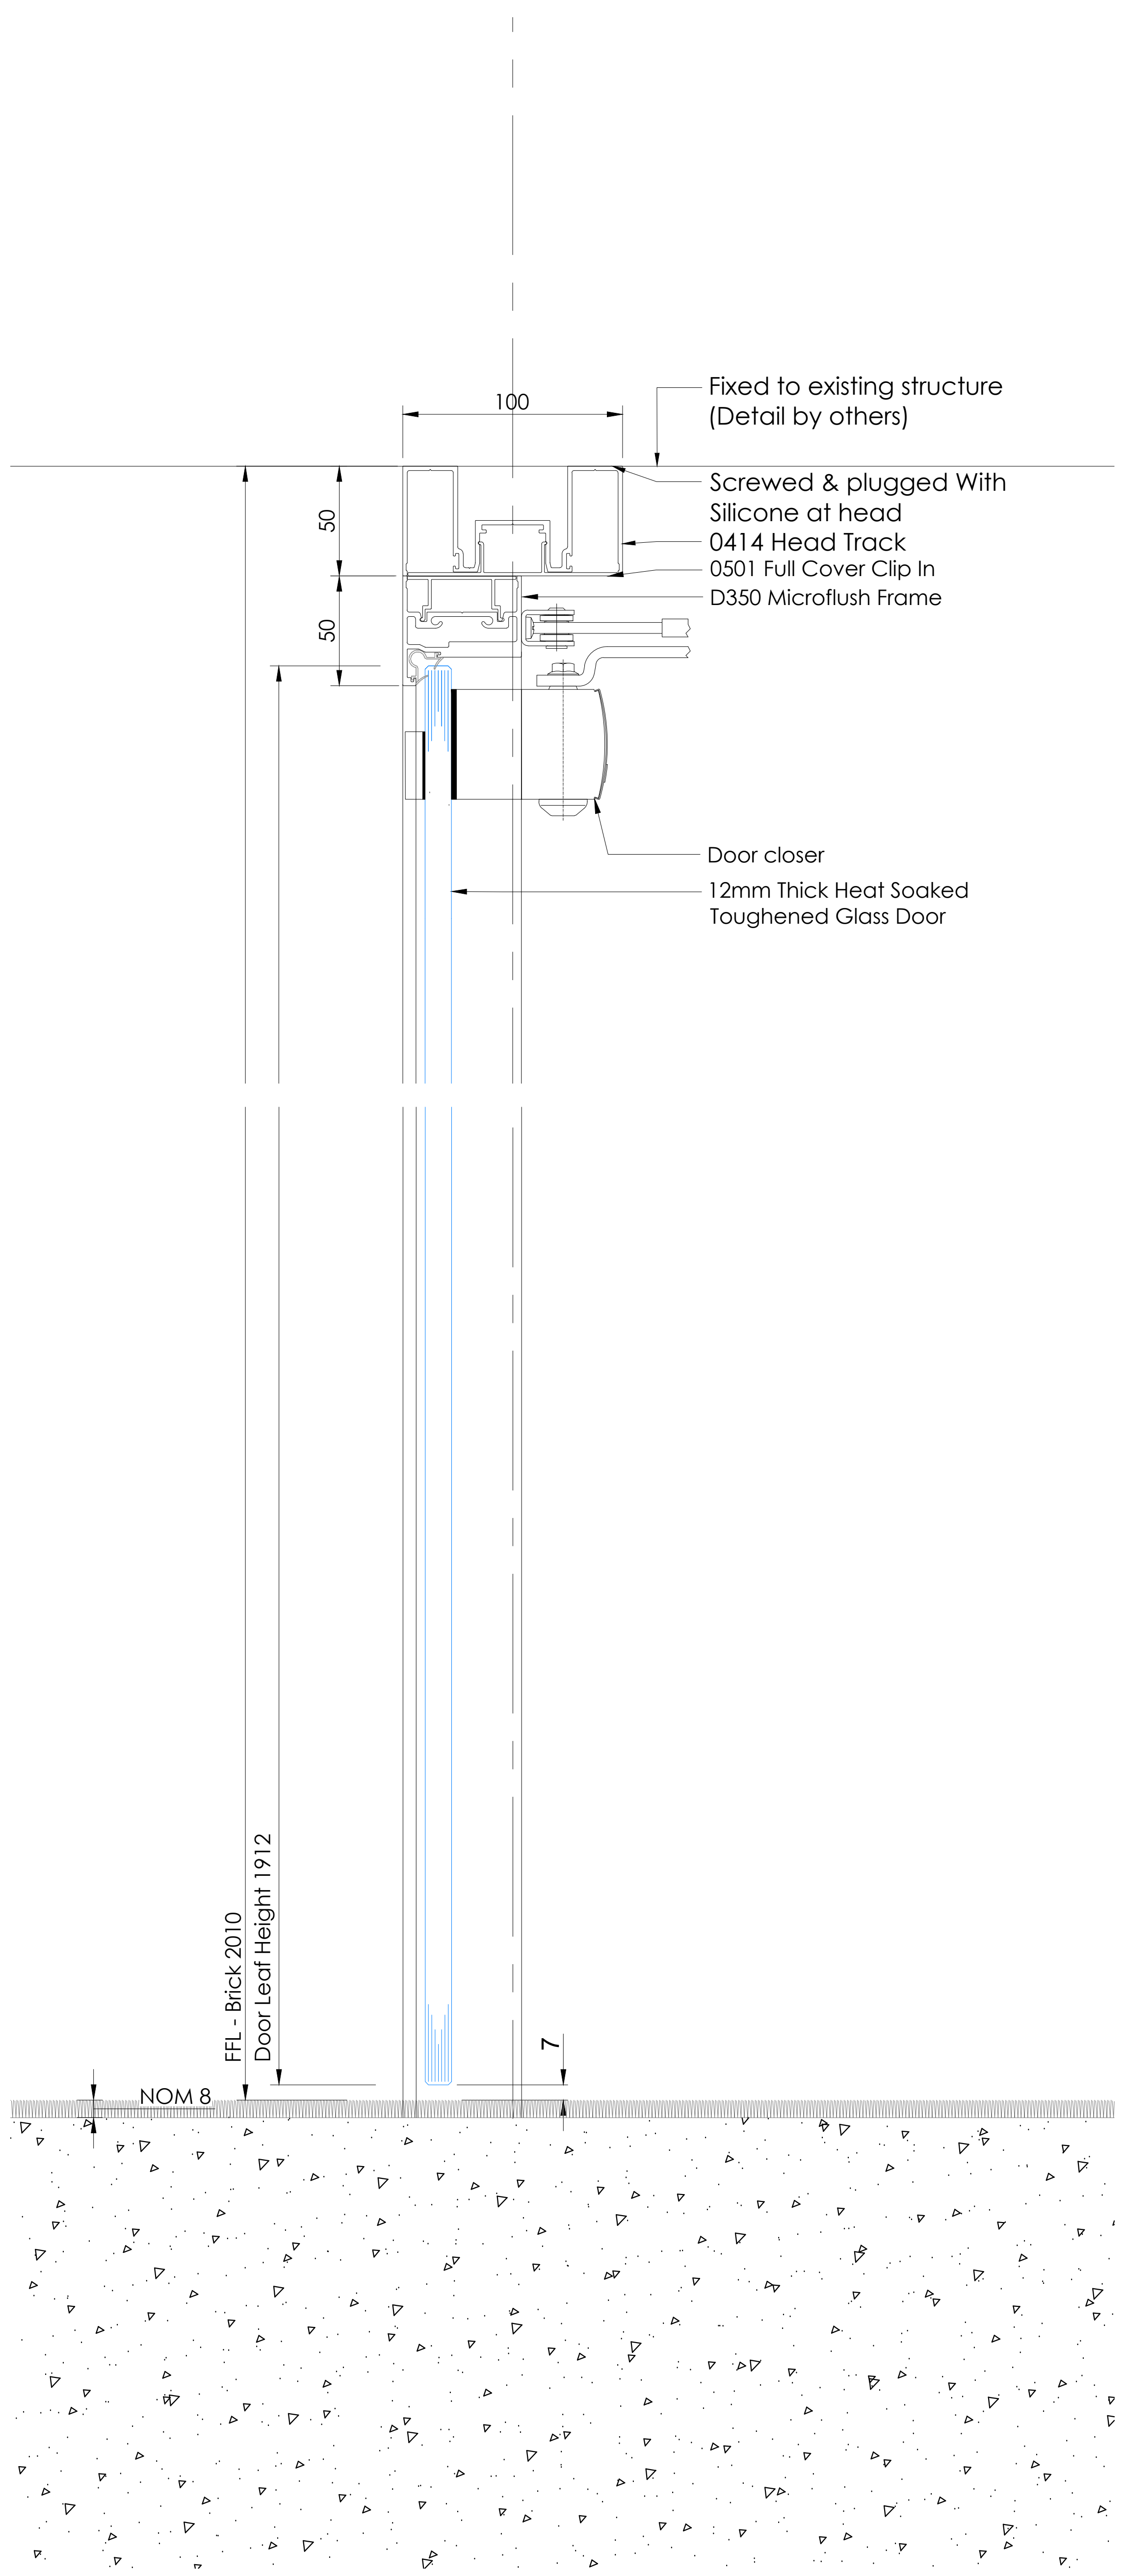

2 SECTION: Door
Axile Clarity
Scale 1:2

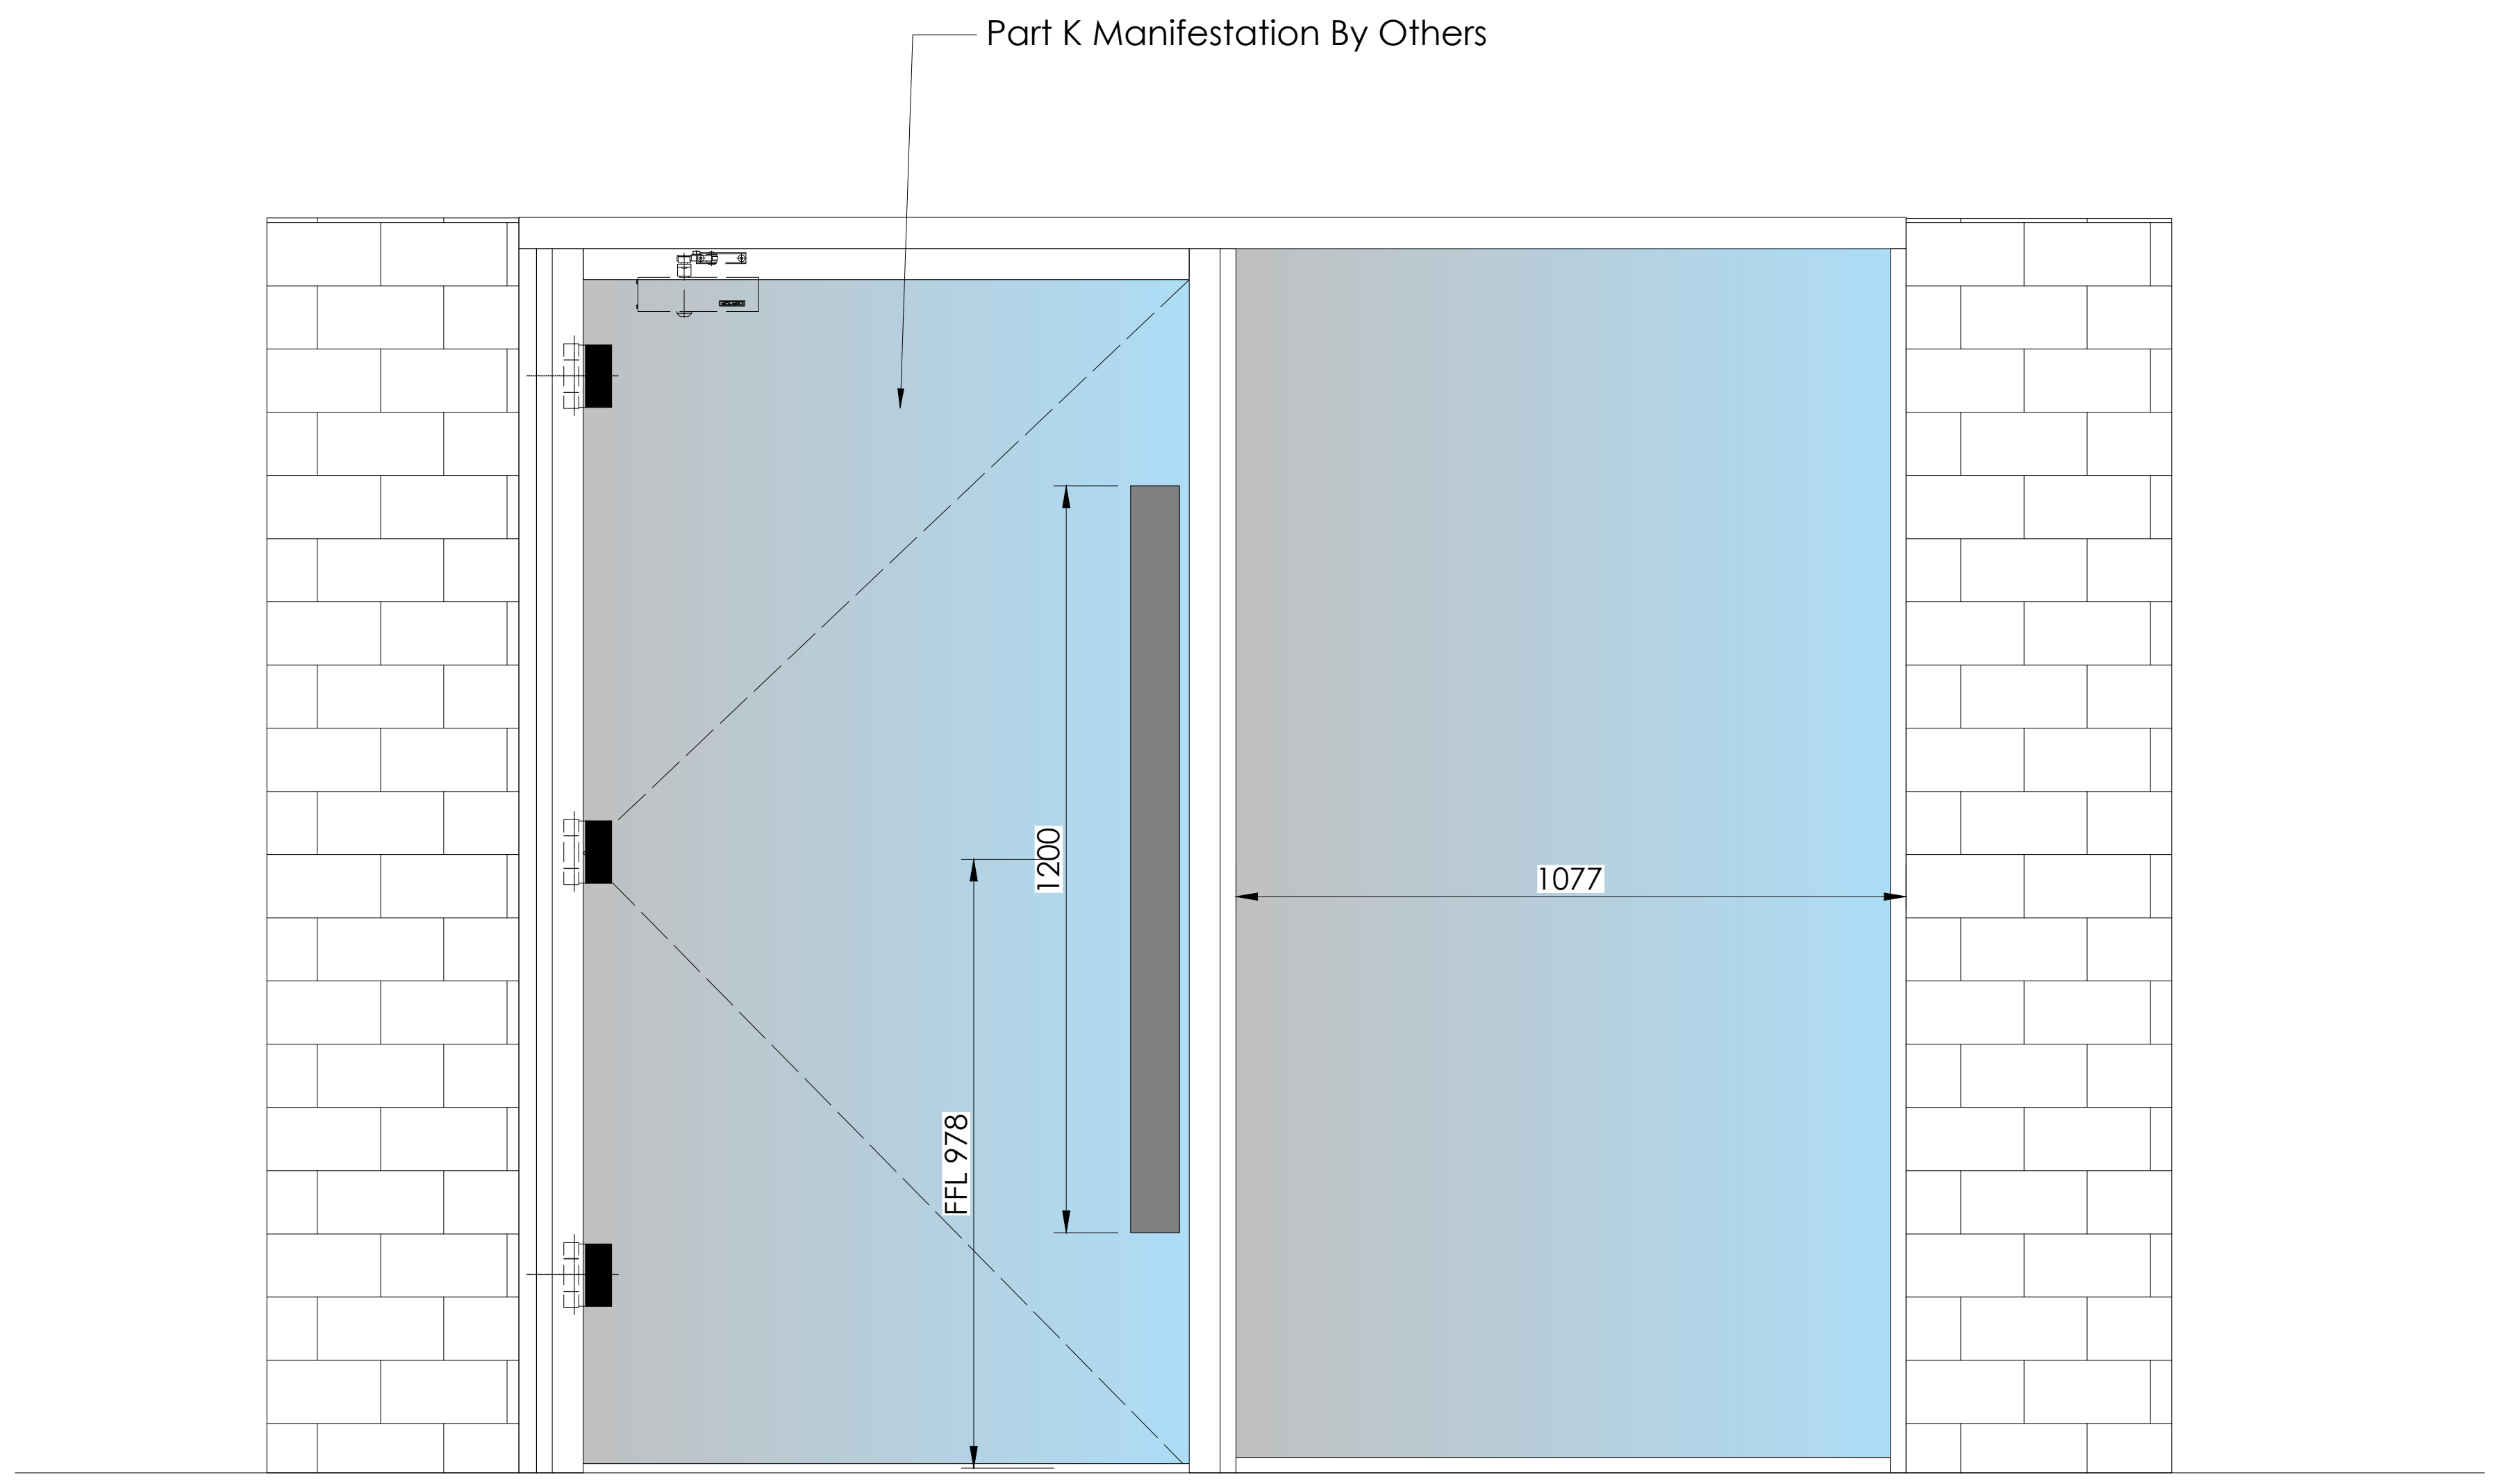

3 Elevation: Screen 8
Revolution 100 - Axile Clarity Door
Scale 1:10

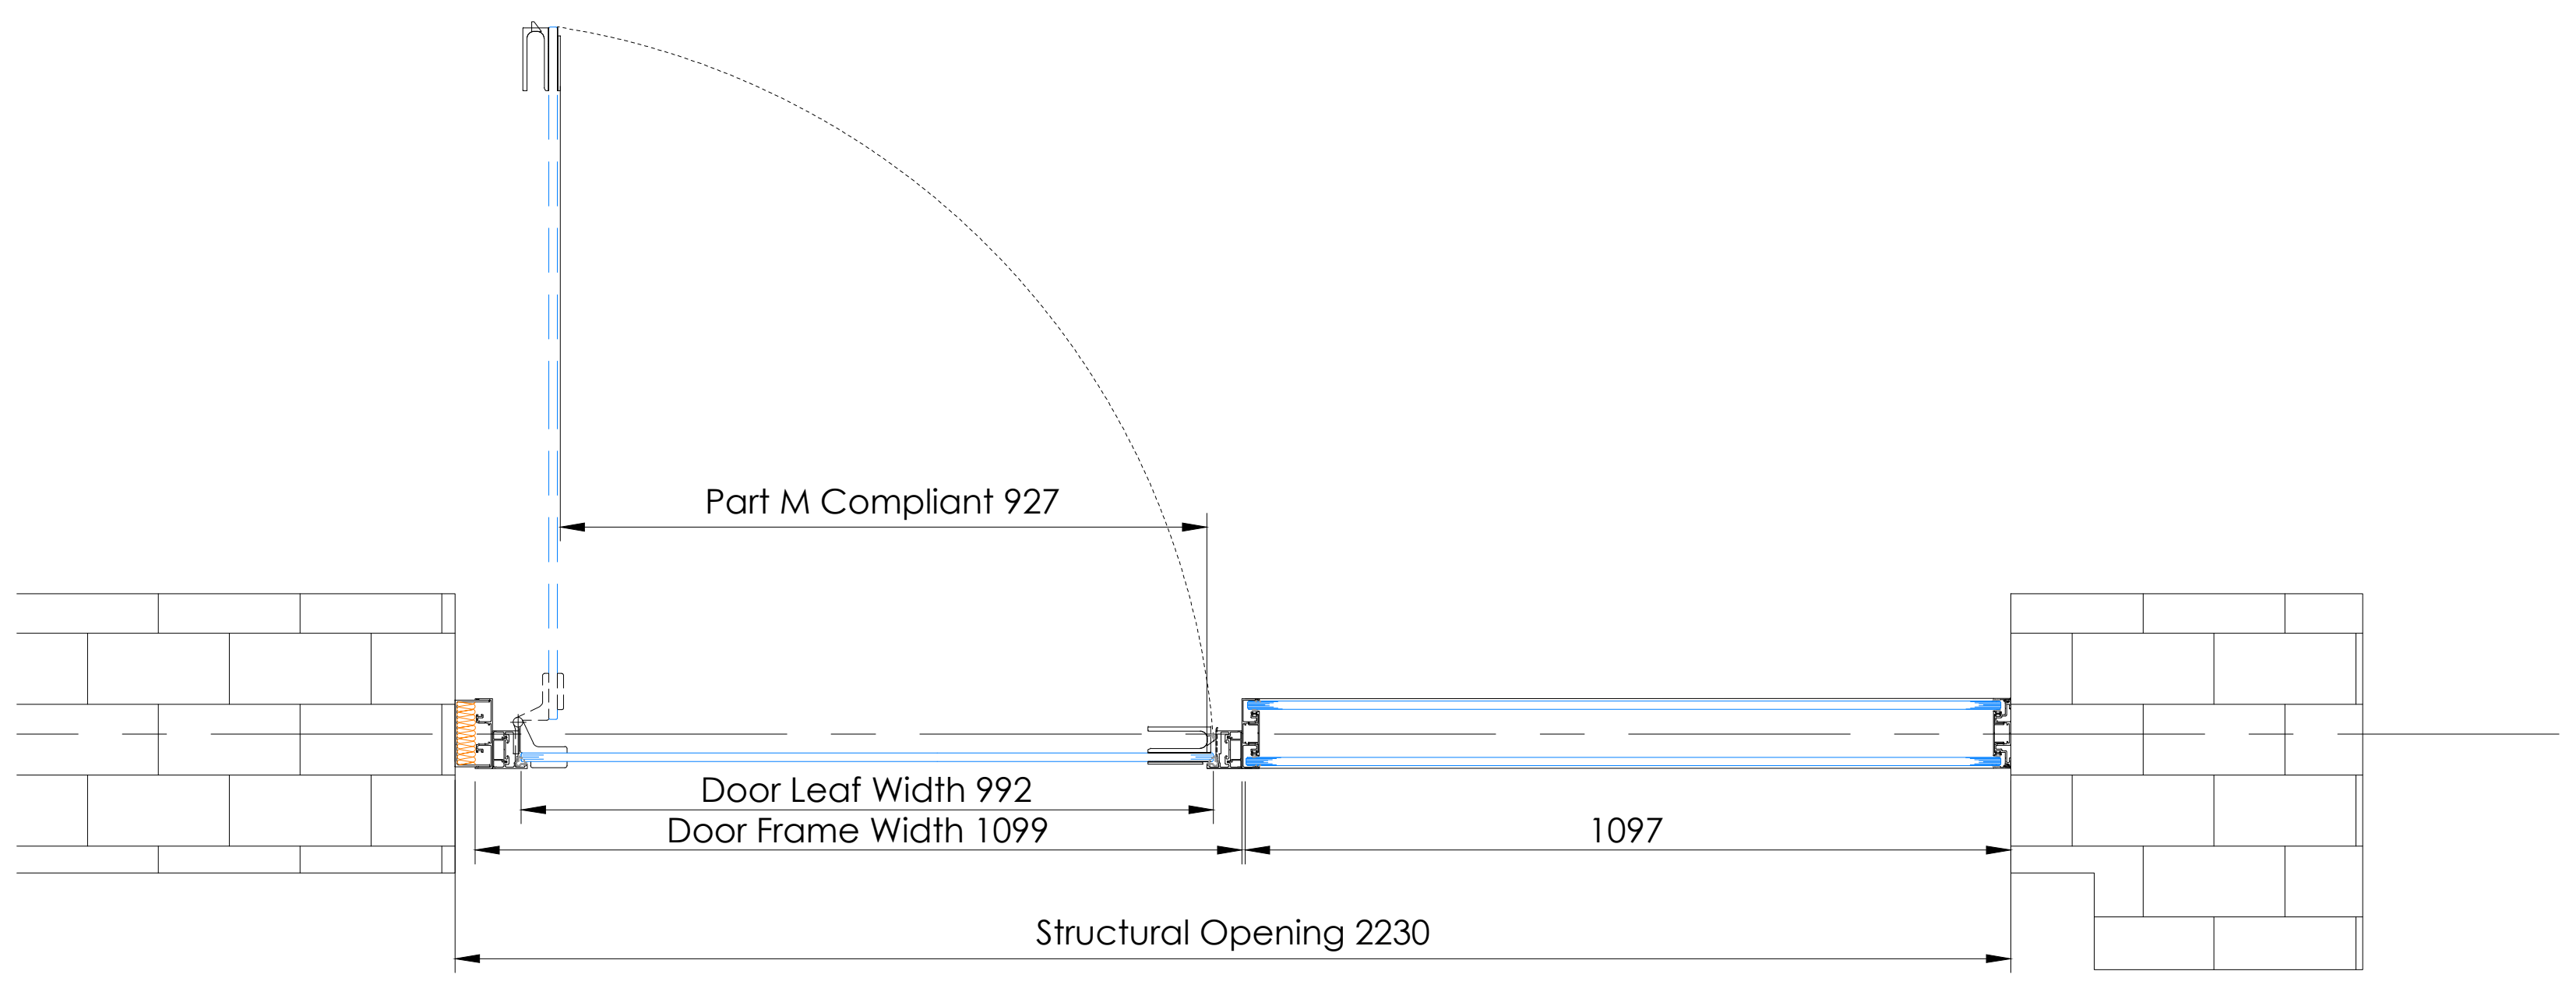

4 PLAN: Screen 8
Revolution 100 - Axile Clarity Door
Scale 1:10

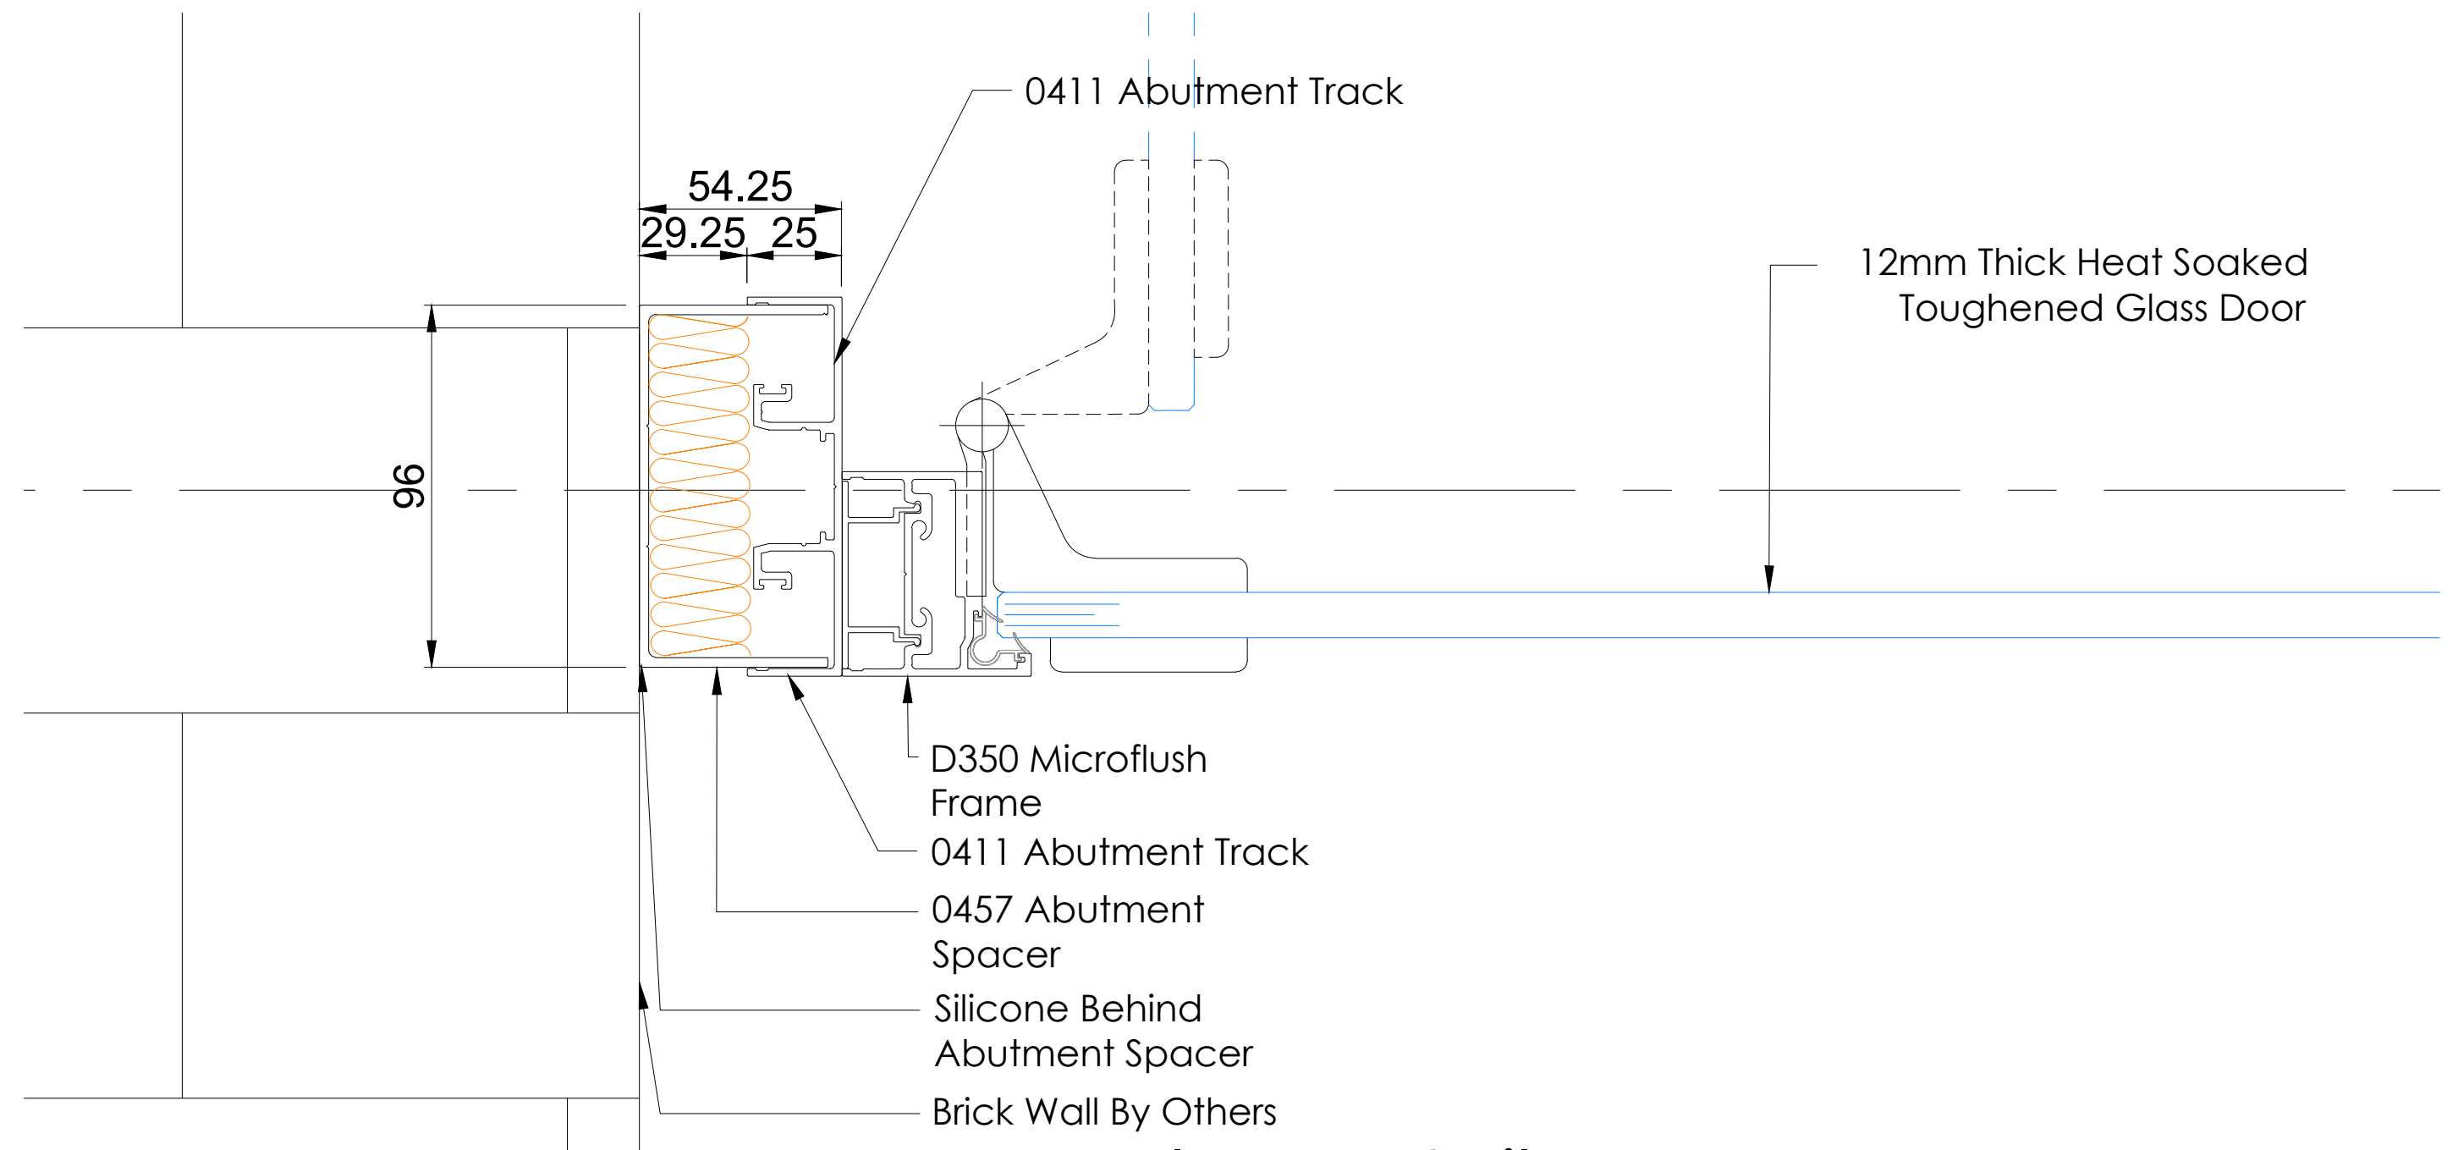

5 Plan Details:
Abutment Spacer
Scale 1:2

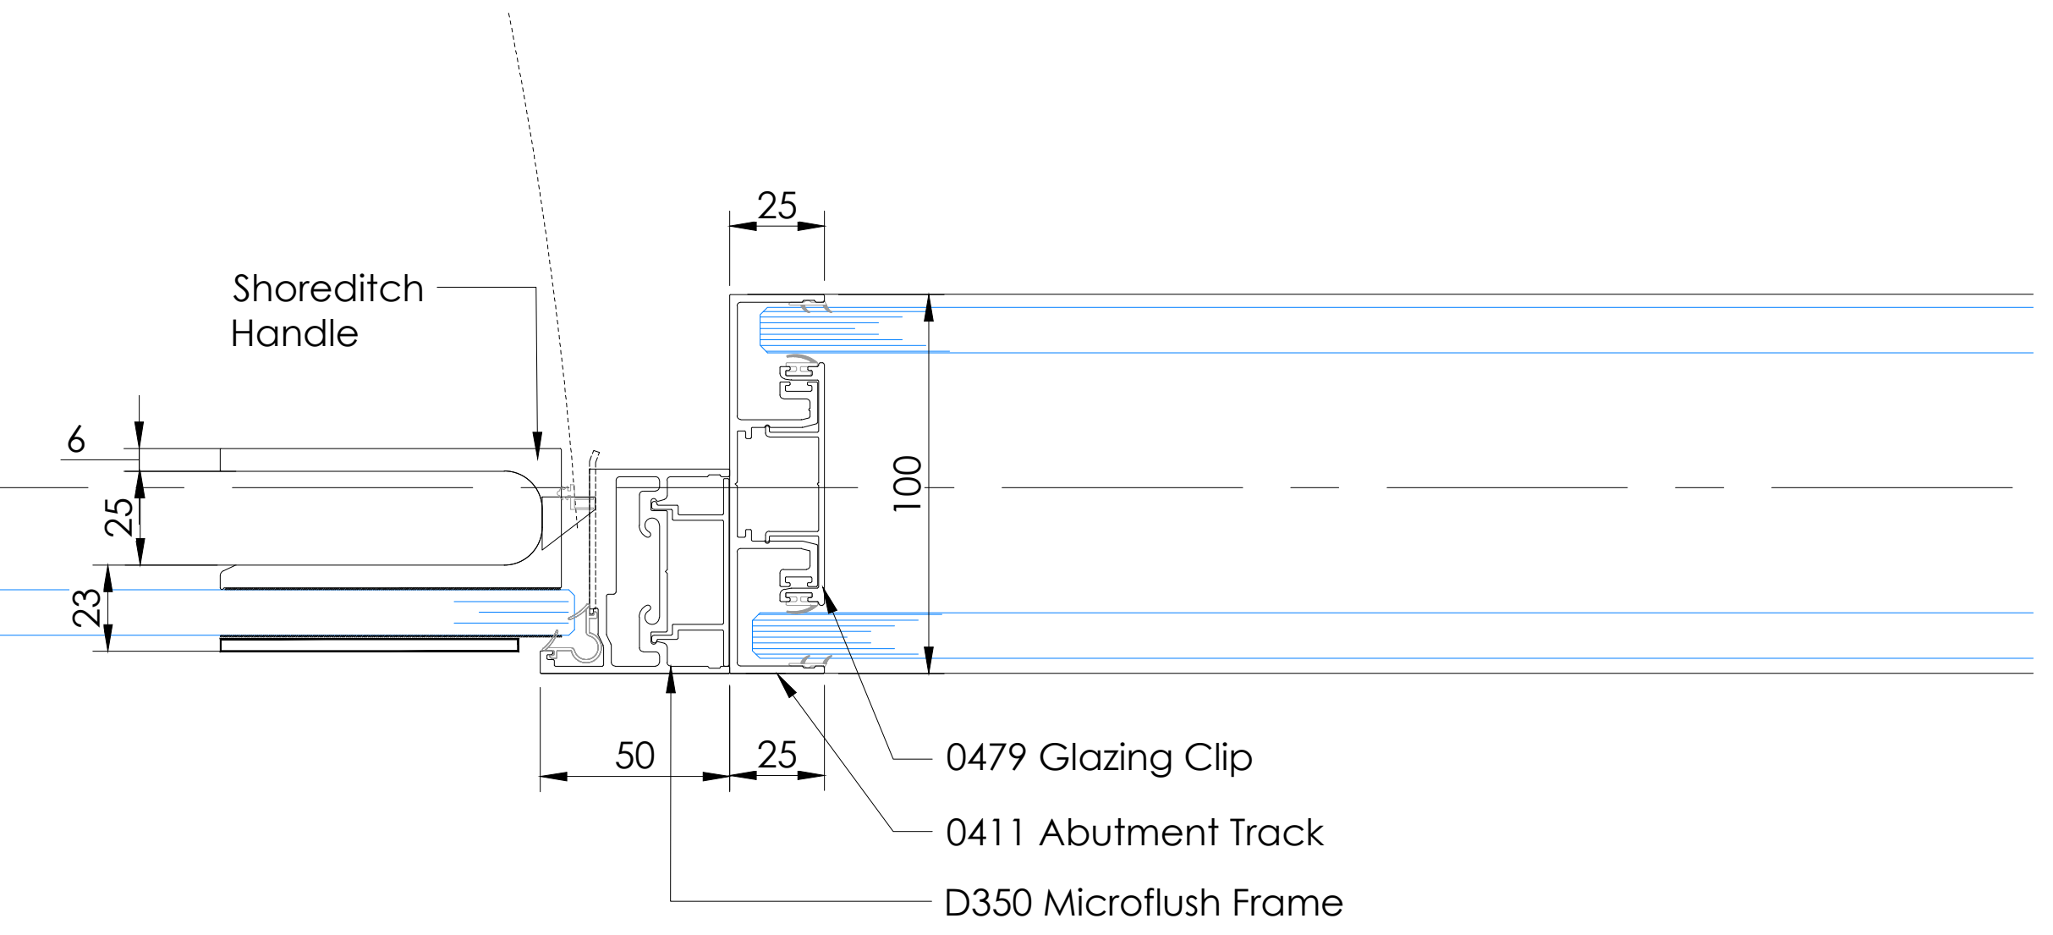

6 Plan Details:
Door Jamb
Scale 1:2

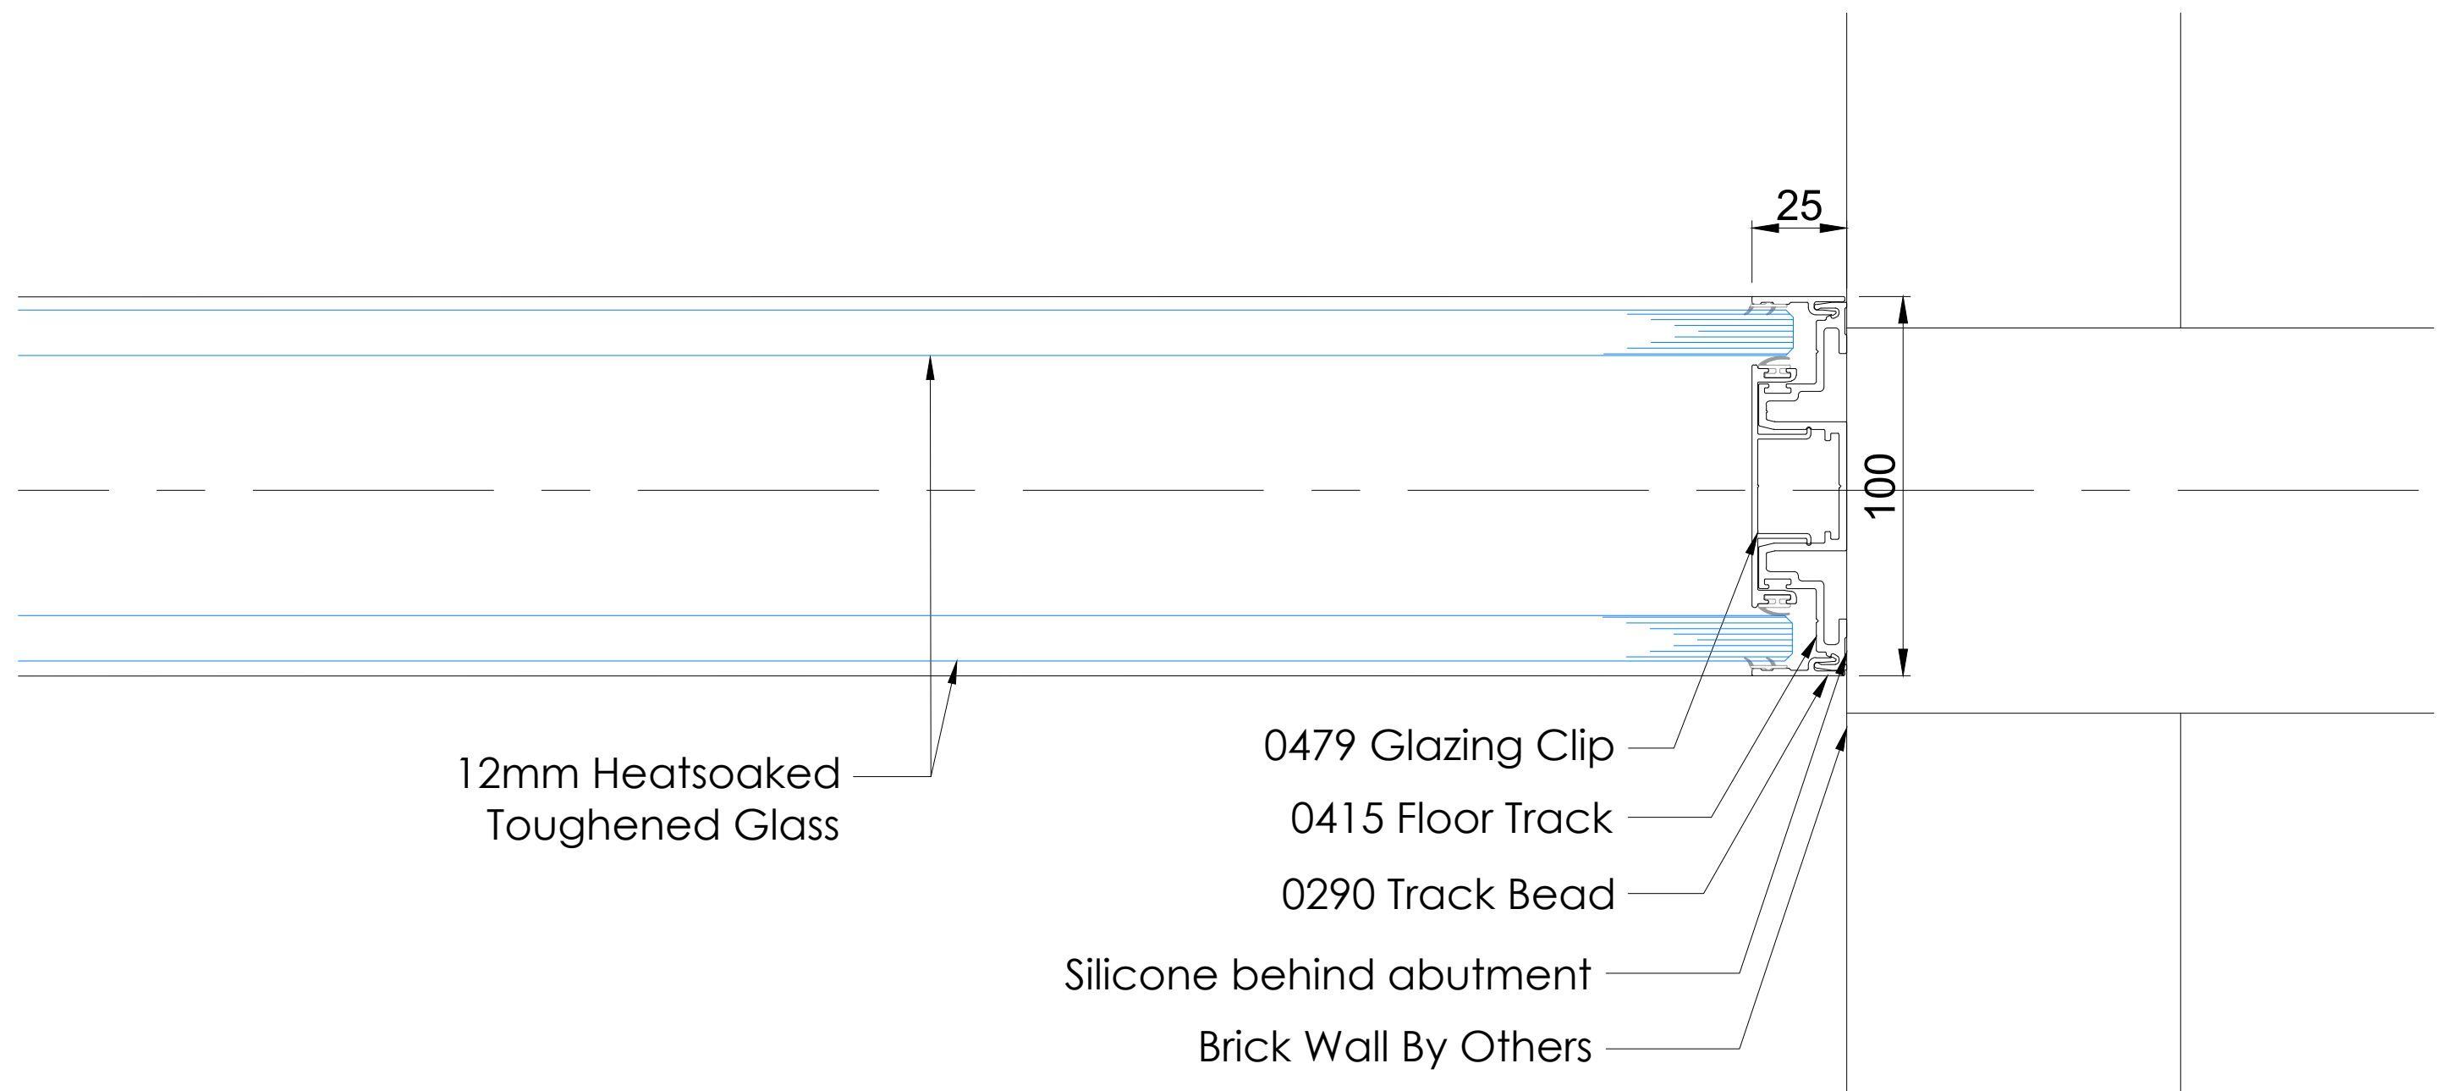

7 Plan Details:
Wall Abutment
Scale 1:2

A0 Layout (1189mm x 841mm)

Safety Health & Environmental Information Box

Construction Risks

This project uses only materials that have been used in this manner before. From a Designers viewpoint, Optima do not envisage any specific Construction issues to communicate.

Maintenance / Cleaning Risks

Optima, in the main, provide office partitioning. The components (specifically the glass are tested to the relevant national or international standards of the day). As such CLEANING and MAINTENANCE of this product reveal no specific risks. However, Optima would point out that all persons involved with maintenance and cleaning should themselves be subject to their own employer's specific risk assessment process. Special care should be taken if working at height. In such cases the regulations of the day apply. Optima do not recommend any loadings against its products.

Demolition / Adaptation Risks

From the viewpoint of a Designer, Optima have identified no significant risks for demolition and adaptation. However, the usual risk assessments are presumed as implemented by the company proposing demolition and/or adaptation.

Environmental / Recycling

Much of the Optima range of project is relocate- able. See original terms and conditions for clarification. Environmental issues are subject to the law of the day.

In addition to the hazards / risks normally associated with the types of work detailed on this drawing take note of the above. It is assumed that all works on this drawing will be carried out by a competent contractor working where appropriate, to an approved method statement.

General Information Table 1007

Door/Partition

Door/Partition Type	*Revolution 100 - Screen 8/ Axile Clarity Door*
Floors	*2*
Acoustic Rating	*Screen: Rw45dB/ Door: N/A*
Ironmongery Set	*Shoreditch Pull Handles/ Door Closer/ patch fittings RAL 9005*
Door Finish	*N/A*
Frame Finish	*RAL 9005*
Deflection	*N/A*
Glass	*12mm thick heat soaked toughened/ X2 12mm thick heat soaked toughened*

Structural Openings To Be Checked On Site

ISSUED
31/03/20 Rev: Rev 00
AS BUILT

AB	31.03.20	As Built	CC	CT	GM
Rev	Date	Description	Dr	App	Ck

Status:
As Built

Optima

© Optima Products Ltd.

OPTIMA CONTRACTING LIMITED
COURTYARD HOUSE
WEST END ROAD
HIGH WYCOMBE
BUCKINGHAMSHIRE
HP11 2QB

PART OF THE OPTIMA GROUP

Tel: +44 (0) 1494 492600
Web: www.optimasystems.com

Project:
50195 Bonded Warehouse L2

Title:
Revolution 100
Screen 8 With Axile Clarity Door

Scale @ A0:	Drawing No.:	Revision:
VARIES	OPT-DRG-1007	AB