
DRAWING No. M1452/M03

REVISION E

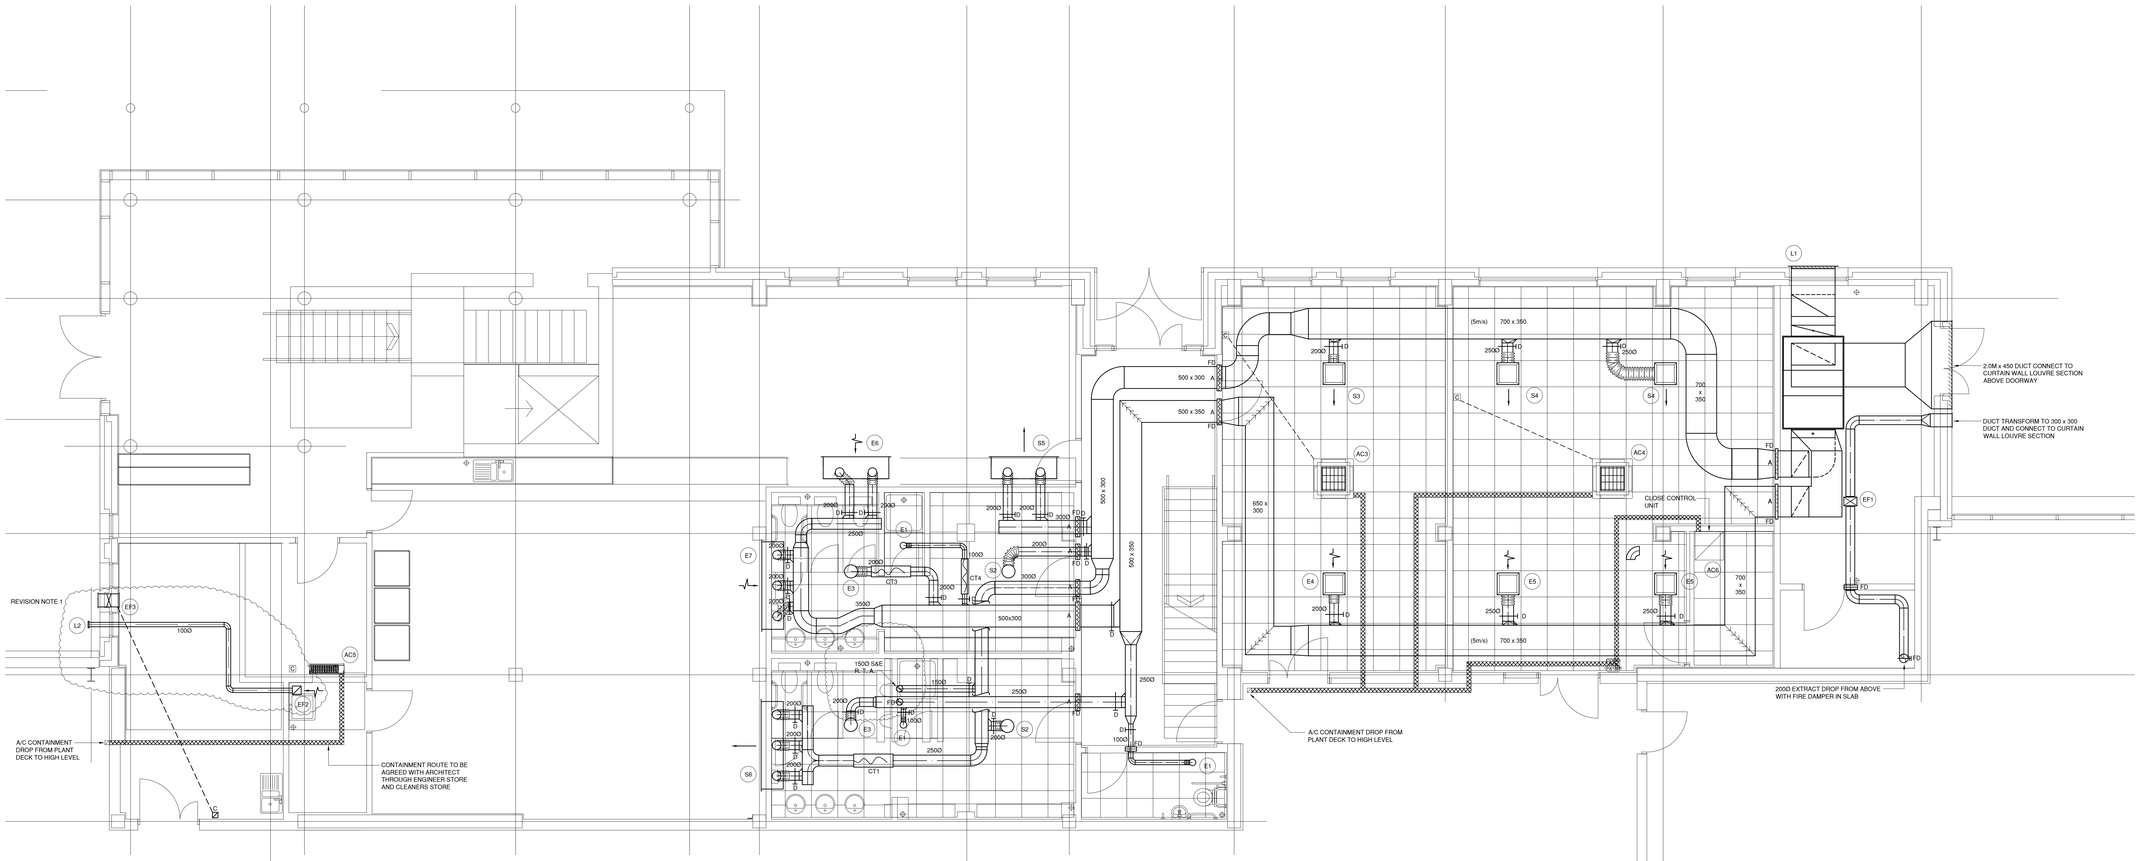

Health & Safety Comments - New Build
Electricity.
Other Trades.
Working at height.
Manual handling.
Working in confined spaces.
For further details refer to the Principal Designer's Health and Safety Information.

LEGEND

- CEILING SUPPLY / EXTRACT GRILLE
- VENTILATION GRILLE
- FLEXIBLE DUCTWORK (INSULATED)
- D VOLUME CONTROL DAMPER
- FD DUCTWORK FIRE DAMPER (WITH ACCESS)
- DUCT MOUNTED IN-LINE ATTENUATOR
- C WALL MOUNTED CONTROLLER
- AIR CONDITIONING CEILING CASSETTE
- PROPOSED ROUTE OF AIR CONDITIONING CONTAINMENT

GRILLE AND LOUVRE SCHEDULE

MANUFACTURER - GDL

REF	No. OFF	DUTY L/S	TYPE	SIZE	O/A SIZE	PLENUM BOX	THROW	GDL CODE
S1	2	35	AIR VALVE	200Ø	248Ø	N/A	-	96E00+1B
S2	2	90	SWIRL	250Ø	350Ø	REDUCED TO 200Ø	1.5	9505K+2B
S3	1	100	4-WAY BLOW	250 x 250	400 x 400	200Ø SIDE INLET	1.5	S442V+2C
S4	2	130	4-WAY BLOW	300 x 300	450 x 450	250Ø SIDE INLET	1.5	S442V+2C
S5	1	170	LINEAR BAR	1500 x 100	1540 x 140	G2 PLENUM 1500 x 100 2 OFF 200Ø SPIGOTS	2.0	S3600+1C
S6	1	230	LINEAR BAR	2000 x 100	2040 x 140	G2 PLENUM 2000 x 100 3 OFF 200Ø SPIGOTS	2.0	S3600+1C
S7	2	125	DOUBLE DEFLECTION	600L x 150H	N/A	DUCT MOUNTED SIDE ENTRY BOOT WITH DAMPER	3.0	S0201C
S8	2	125	DOUBLE DEFLECTION	600L x 150H	N/A	DUCT MOUNTED SIDE ENTRY BOOT WITH DAMPER	3.0	S0201C
S9	1	60	TO BE CONFIRMED.					
S10	1	120	TO BE CONFIRMED.					
E1	3	10	AIR VALVE	100Ø	137Ø	N/A	-	96E00+1B
E2	2	45	AIR VALVE	200Ø	248Ø	N/A	-	96E00+1B
E3	2	90	SWIRL	250Ø	350Ø	REDUCED TO 200Ø	1.5	9505K+2B
E4	1	100	4-WAY BLOW	250 x 250	400 x 400	200Ø SIDE INLET	1.5	S442V+2C
E5	2	140	4-WAY BLOW	300 x 300	450 x 450	250Ø SIDE INLET	1.5	S442V+2C
E6	1	200	LINEAR BAR	1500 x 100	1540 x 140	G2 PLENUM 1500 x 100 2 OFF 200Ø SPIGOTS	2.0	S3600+1C
E7	1	270	LINEAR BAR	2000 x 1000	2040 x 140	G2 PLENUM 1500 x 100 2 OFF 200Ø SPIGOTS	2.0	S3600+1C
E8	1	60	DOUBLE DEFLECTION	300 x 300	360 x 360	MOUNTED IN MEDIA WALL	N/A	S0201C
E9	1	120	DOUBLE DEFLECTION	300 x 300	360 x 360	MOUNTED IN MEDIA WALL	N/A	S0201C
E10	2	-	MULTI-CONE	450 x 450	495 x 495	N/A	N/A	E4100+6
E11	1	100	DOUBLE DEFLECTION	200 x 200	260 x 260	N/A	N/A	S0201C
L1	1	-	EXTERNAL LOUVRE	1000 x 1000	1061 x 1061	N/A	N/A	W505+0C
L2	1	-	EXTERNAL LOUVRE	150 x 150	210 x 210	N/A	N/A	W505+0C
L3	1	180	EXTERNAL LOUVRE	400 x 400	460 x 460	N/A	N/A	W505+0C
L4	1	180	EXTERNAL LOUVRE	400 x 400	460 x 460	N/A	N/A	W505+0C

COMFORT COOLING SCHEUDLE

MANUFACTURER - MITSUBISHI

SPECIALIST APPROVED INSTALLER - COOLAIR TEL: 0161 343 6000

SYSTEM REF	INDOOR UNIT	EXTERNAL UNIT	CONTROL'S	ANCILLARIES
AC1 - PR ROOM	SEZXD60 DUCTED	SUZKA60	WALL CONTROLLER	-
AC2 - BOARD ROOM	SEZXD50 DUCTED	SUZKA50	WALL CONTROLLER	-
AC3 - SAMPLES ROOM	PLARP60 CASSETTE	PUHZRP60	WALL CONTROLLER	-
AC4 - LABORATORY	PLARP71 CASSETTE	PUHZRP71	WALL CONTROLLER	-
AC5 - SERVER	PKARP50 WALL	PUHZRP50	WALL CONTROLLER	-
AC6 - TEST ROOM	AIREDALE V6X-EZRE UPFLOW UNIT COMPLETE WITH SUCTION THROTTLE DUTY REDUCTION VALVE AND INCREASE ELECTRICAL HEATER BATTERY	CR12	INTEGRAL ON UNIT	DISCHARGE PLENUM WITH 3 No. DOUBLE DEFLECTION GRILLES
HEU1 - PR / BOARD ROOMS	LGH45 VENTILATION UNIT DUTY 180 L/S @ 100 Pa	-	WALL CONTROLLER	-

INSTALLATION DETAILS
EACH SYSTEM SHALL BE COMPLETE WITH INTERCONNECTING REFRIGERATION PIPEWORK AND CONTROLS WIRING BETWEEN INDOOR AND EXTERNAL UNITS AND WIRING TO WALL CONTROLLERS.
ALL REFRIGERATION PIPEWORK AND INTERCONNECTING WIRING TO BE SUPPORTED ON GALVANISED CONTAINMENT.
ALL EQUIPMENT SHALL BE SUPPORTED USING UNISTRUT AND DROP ROD'S EXTERNAL UNITS SHALL BE SUPPORTED ON CANTILEVER WALL BRACKETS COMPLETE WITH DRIP PANS.
INDOOR UNITS SHALL BE COMPLETE WITH ABS PLASTIC CONDENSATE DRAIN PIPES DISCHARGE VIA TRAP INTO THE BUILDING DRAINAGE SYSTEM.
THE ON / OFF OPERATION OF THE A/C SYSTEMS WILL BE GOVERNED BY THE BUILDING BMS (TREND SYSTEM).

NOTE:- THE MECHANICAL CONTRACTOR SHALL INCLUDE THE INSTALLATION OF ALL DUCTWORK AND GRILLES GENERALLY AS DETAILED INCLUDING DUCTWORK INSULATION.
MAIN ELECTRICAL SUPPLIES TO EACH SYSTEM SHALL BE CARRIED OUT BY OTHERS.

ATTENUATOR SCHEDULE

MANUFACTURER - ALLAWAY ACOUSTICS LIMITED

REF	SYSTEM	CODE	SOFF/C	LENGTH	SIZE	VOLUME	PD
AT1	AHU BUILDING SUPPLY	SPY7	GJ	1200	600 x 400	1.090m³/s	30
AT2	AHU BUILDING EXTRACT	SPY7	GJ	1200	600 x 400	1.260m³/s	40
AT3	AHU BUILDING INTAKE	SP2035B	G	500 x 500	1000 x 400	1.090m³/s	31
AT4	AHU BUILDING EXHAUST	SPE6	GJ	600	1000 x 400	1.260m³/s	21
CT1	CANTEEN SUPPLY	PL	G	900	250Ø	0.230m³/s	5
~~CT2~~	~~FEMALE WC SUPPLY~~	PL	G	900	200Ø	0.080m³/s	5
CT3	FEMALE WC EXTRACT	PL	G	900	200Ø	0.090m³/s	5
CT4	FEMALE WC EXTRACT	PL	G	900	100Ø	0.010m³/s	5
CT5	BOARD ROOM EXTRACT	PL	G	900	200Ø	0.060m³/s	5
CT6	BOARD ROOM SUPPLY	PL	G	900	200Ø	0.060m³/s	5
CT7	VAM SUPPLY	PL	G	900	250Ø	0.180m³/s	5
CT8	VAM EXTRACT	PL	G	900	250Ø	0.180m³/s	5

EXTRACT FAN SCHEDULE

REF	No. OFF	MANUFACTUERER	MODEL	DUTY	CONTROLS	ANCILLARIES	ELECTRICAL	INSTALLATION DETAILS
EF1	1	VENT-AXIA	ACM 150	75/100 L/S @ 100Pa	VARIABLE SPEED CONTROLLER	FIXING BRACKETS	230V	IN-LINE DUCT MOUNTED AT HIGH LEVEL IN PLANTROOM
EF2	1	VENT-AXIA	SOLO PLUS T	-	WIRED VIA LIGHTING CIRCUIT	100Ø DUCT	230V	CEILING MOUNTED WITH 100Ø DUCT TO WALL LOUVRE
EF3	1	VENT-AXIA	TX6WL	-	T-SERIES	WALL SLEEVE	230V	IN EXTERNAL WALL AT HIGH LEVEL

Rev	Revision	Drn	Chk	Date
F	A/C CONDENSING UNITS RELOCATED TO PLANT DECK ABOVE OFFICES, REFER TO DRAWING M1452/M09 REVISION F FOR PROPOSED POSITIONS. GRILLE SCHEDULE AMENDED FOR GRILLES TO PR ROOM AND BOARDROOM.	MJSH	MJSH	10/08/2017
E	AIREDALE UNIT RE-SPECIFIED TO INCORPORATE SUCTION DUTY REDUCTION VALVE AND INCREASE ELECTRIC HEATER BATTERY. PLENUM TO INCLUDE 3 SEPARATE DOUBLE DEFLECTION GRILLES.	MJSH	MJSH	19/07/2017
D	DUCTWORK SIZES THROUGH SAMPLES AND LABORATORY REVISED FOLLOWING MEETING ON SITE ON 04/07/17 WITH JAMES MERCER AND FLEETWOOD SHEET METAL. DUCTWORK TO BENCH MOUNTED EXTRACT ALTERED IN LINE WITH ARCHITECTS REQUIREMENT.	MJSH	MJSH	12/07/2017
C	DUCTWORK ALTERATIONS TO ASSIST IN CO-ORDINATION FOLLOWING MEETINGS 29TH AND 30TH JUNE 2017 WITH MECHANICAL SERVICES CONTRACTOR AND ARCHITECT. BUILDING LAYOUT AMENDED TO SUIT ARCHITECTURAL DRAWINGS	MJSH	MJSH	3/07/2017
B	AT3 AHU INTAKE MODEL & TYPE CHANGED. GRILLES REFERENCES E8 & E9 TO BE CONFIRMED. GRILLES S9 & S10 ADDED TYPE'S TO BE CONFIRMED. E10 OMITTED ON SCHEDULE. REVISION TO DUCTWORK ROUTE NOTE 1. SETTING OUT DETAIL ADDED NOTE 2. DUCTWORK RISERS TO FIRST FLOOR TOILET AMENDED NOTE 3.	MJSH	MJSH	21/06/2017
A	UPDATED TO CONSTRUCTION ISSUE.	MJSH	MJSH	FEB 2017

STATUS Construction

DEVELOPMENT DESIGN ASSOCIATES
CONSULTING ENGINEERS
Hazel Terrace, 337 London Road
Hazel Grove,
Stockport,
SK7 4PS
Tel: 0161 483 2030
Fax: 0161 456 4884

CLIENT

The Little Greene Paint Company

PROJECT

Ashbury Works, New Office and Factory

DRAWING TITLE

Proposed Mechanical Supply & Extract Ventilation & Comfort Cooling Installation Ground Floor Office Building

DRAWN	DATE	CHECKED	DATE
MJSH	January 2016	MJSH	January 2016

SCALE	DRAWING No.	REVISION
1:50 @ A0	M1452/M03	F