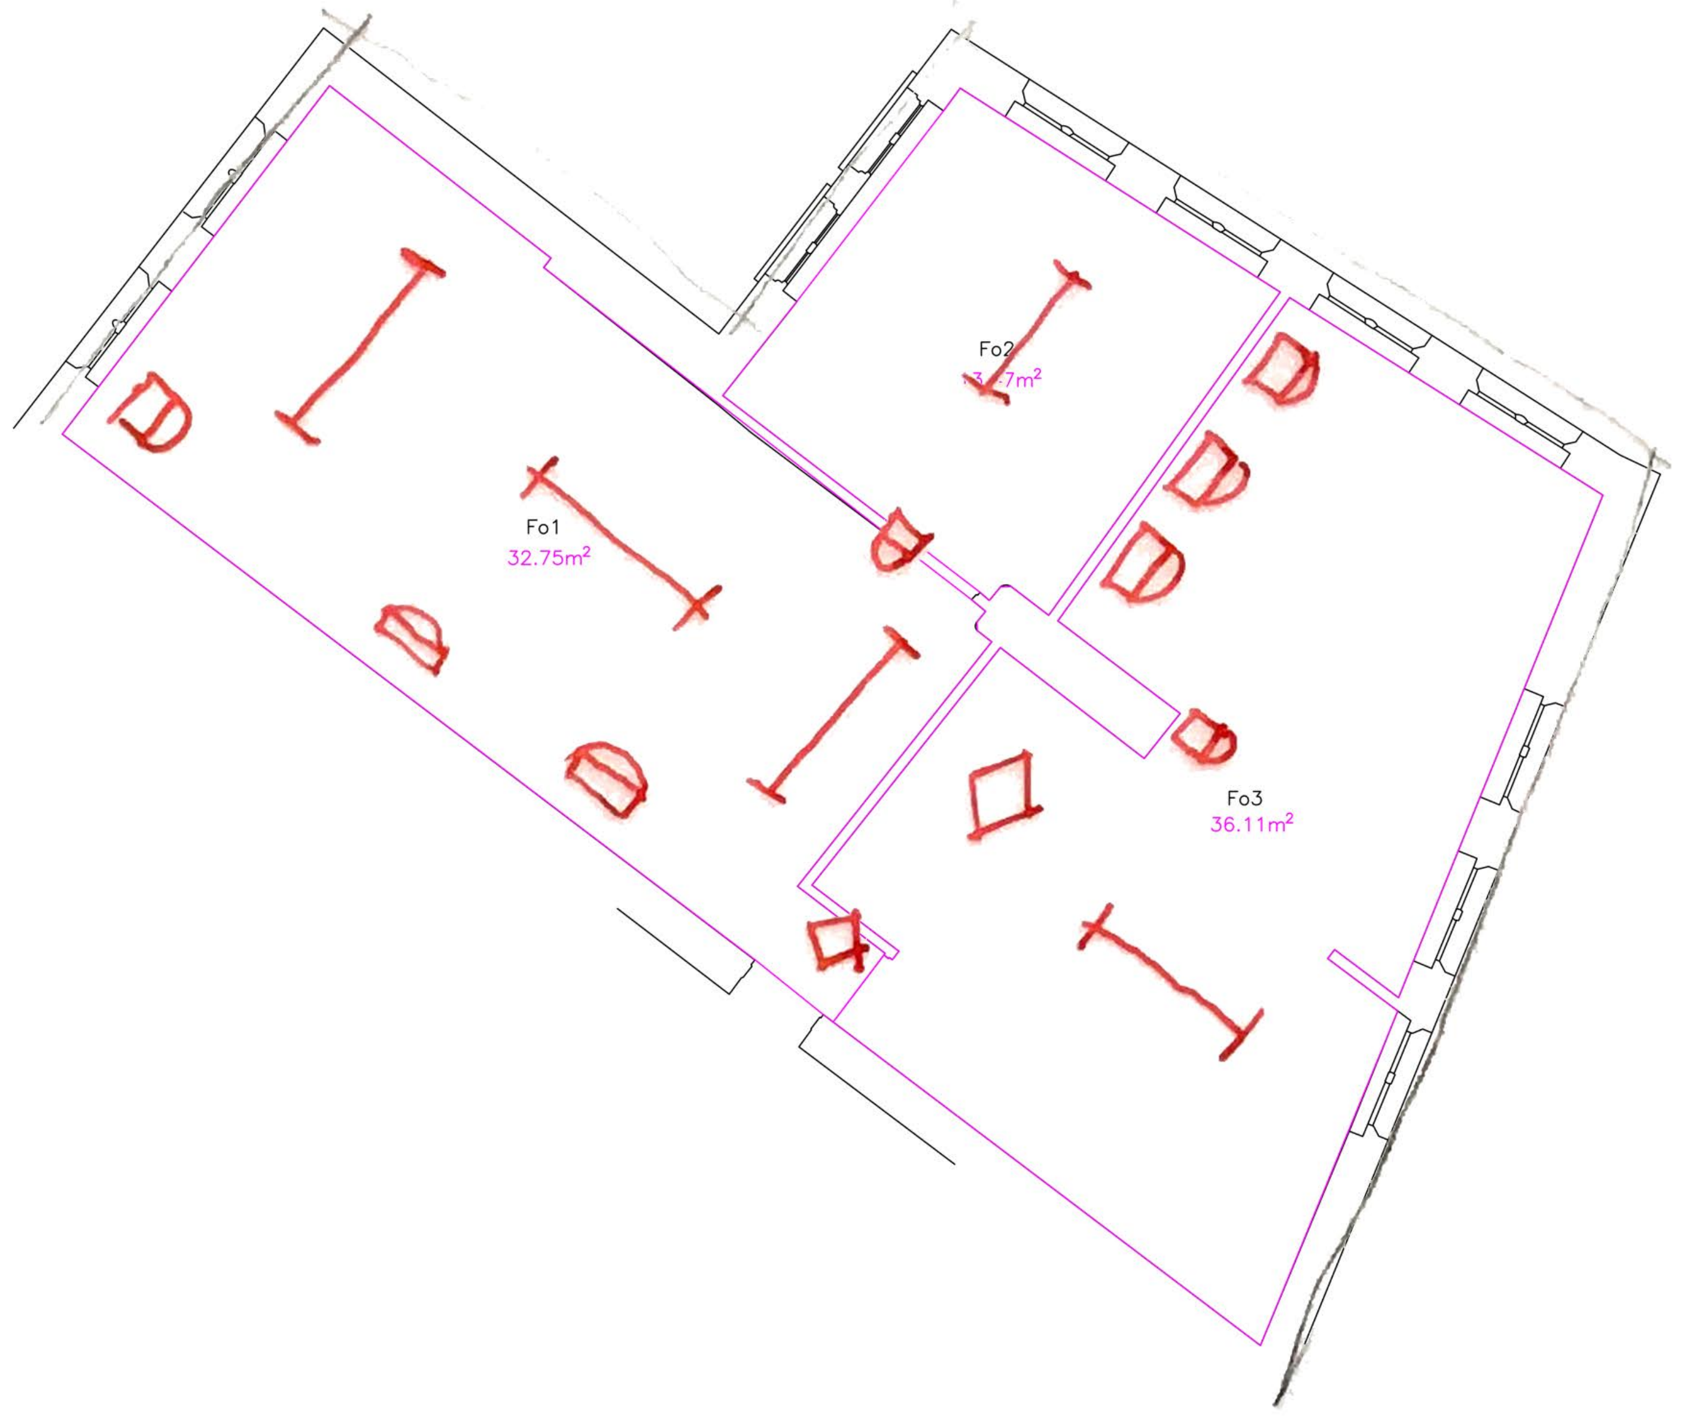

NOTE

- THE FOLLOWING ITEMS WERE ADVISED BY W. GROUP (NW) ON SITE ON 26.04.2022 AS 'REDUNDANT' ELECTRICAL ITEMS; PROPOSED TO BE REMOVED AS PART OF THE PROPOSED ELECTRICAL WORKS.
- ANY DAMAGE DURING REMOVAL WOULD BE MADE GOOD WITH LIKE-FOR-LIKE MATERIALS.
- SOME FUSE SPURS + SOCKETS PROPOSED FOR REMOVAL MAY BE REPLACED WITH A BLANK PLATE (IF BUILT INTO THE WALL).

KEY: ITEMS ADVISED TO BE REMOVED

├──┤ = STRIP LIGHT
⌓ = FUSE SPUR/POWER SOCKET
▭ = PLASTIC CONTAINMENT
—·—·— = CABLE
∘ = PULL CHORD
◇ = PENDANT LIGHT
▨ = HAND-DRYER
▭ = FIRE ALARM BREAK-GLASS + CONDUIT
◁ = SECURITY CAMERA
▣ = DISTRIBUTION BOARD
→ = ELECTRIC FIRE ESCAPE SIGNAGE
⊙ = FIRE ALARM BELL

INSALL
MARK-UP 26.04.22
- SHOWING REDUNDANT ITEMS TO BE REMOVED
- AS ADVISED BY W. GROUP (NW)

Notes:
1. This survey is related to a local grid system.
2. All levels are relative to Ordnance Datum Newlyn (ODN) by observations to OS Net via Network RTK GNSS technology.
3. All dimensions are in metres unless noted otherwise.
4. Scale factor for this survey drawing is 1.00000.

Jacobs U.K. Limited
This document has been prepared by a division, subsidiary or affiliate of Jacobs U.K. Limited ("Jacobs") in its professional capacity as consultants in accordance with the terms and conditions of Jacobs' contract with the commissioning party (the "Client"). Regard should be had to those terms and conditions when considering and/or placing any reliance on this document. No part of this document may be copied or reproduced by any means without prior written permission from Jacobs. If you have received this document in error, please destroy all copies in your possession or control and notify Jacobs.

Any advice, opinions, or recommendations within this document (a) should be read and relied upon only in the context of the document as a whole; (b) do not, in any way, purport to include any manner of legal advice or opinion; (c) are based upon the information made available to Jacobs at the date of this document and on current UK standards, codes, technology and construction practices as at the date of this document. It should be noted and it is expressly stated that no independent verification of any of the documents or information supplied to Jacobs has been made. No liability is accepted by Jacobs for any use of this document, other than for the purposes for which it was originally prepared and provided. Following final delivery of this document to the Client, Jacobs will have no further obligations or duty to advise the Client on any matters, including development affecting the information or advice provided in this document.

This document has been prepared for the exclusive use of the Client and unless otherwise agreed in writing by Jacobs, no other party may use, make use of or rely on the contents of this document. Should the Client wish to release this document to a third party, Jacobs may, at its discretion, agree to such release provided that (a) Jacobs' written agreement is obtained prior to such release; and (b) by release of the document to the third party, that third party does not acquire any rights, contractual or otherwise, whatsoever against Jacobs and Jacobs, accordingly, assume no duties, liabilities or obligations to that third party; and (c) Jacobs accepts no responsibility for any loss or damage incurred by the Client or for any conflict of Jacobs' interests arising out of the Client's release of this document to the third party.

B	24/01/17	Addition of Room Numbers & Areas	CS	GY	CS
A	13/01/17	Original Issue	CS	GY	IL
Rev	Rev. Date	Purpose of revision	Drawn	Checked	Approved

JACOBS
Stockton Office, Phoenix House, Surtees Business Park, Stockton on Tees, TS18 3HR
Tel: 01642 334000
www.jacobs.com

Client
Manchester City Council

Project
Charter St Ragged School

Drawing title
~~Measured Building Survey~~
Fourth Floor Plan

Drawing status
Final

Scale	1:50 @ A0	DO NOT SCALE
Jacobs No.	B094762B	
Client no.		

Drawing number
B094762B/MBS/2D/006

Rev
B

© Copyright 2015 Jacobs U.K. Limited. The concepts and information contained in this document are the property of Jacobs. Use or copying of this document in whole or in part without the written permission of Jacobs constitutes an infringement of copyright. Limitation: This drawing has been prepared on behalf of, and for the exclusive use of Jacobs' Client, and is subject to, and issued in accordance with, the provisions of the contract between Jacobs and the Client. Jacobs accepts no liability or responsibility whatsoever for, or in respect of, any use of, or reliance upon, this drawing by any third party.