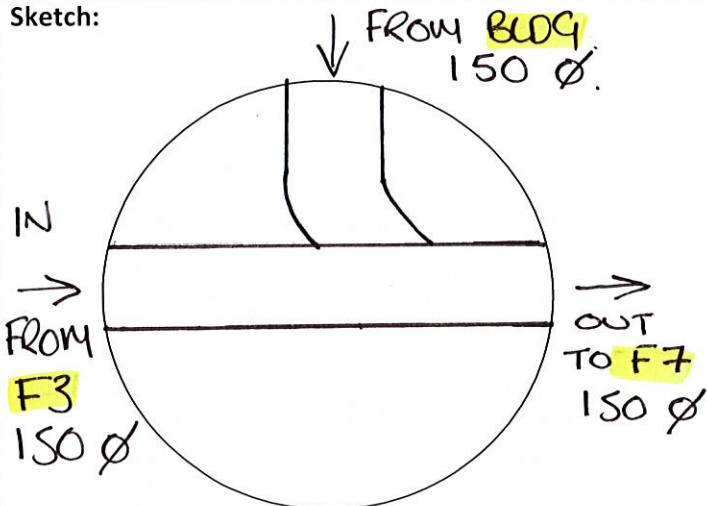


Installation of Manhole			Sheet No:	3.
Project	C376 WITHINGTON CDC		Date:	28/04/2025
Location: As built coordinates: Cover Level:	FW 4 383764.523 391996.478	Drawing No:	22182-CCS-WCH006-XX-DR-S-93000	
Manhole No: Invert:	FW 4 31.341 31.338 B.M.	Type: (circle as appropriate)	FOUL/SURFACE WATER/COMBINED	
Inverts and Diameter of pipes:	Upstream: Dia: 150 DIA Downstream: Dia: 150 DIA Inlet 1: 150 DIA Dia: Inlet 2: 150 DIA Dia: Inlet 3: Dia: Inlet 4: Dia: Inlet 5: Dia:	Sketch: 		
Chamber Details:	Dia. Size: 450 PPIC Overall depth: 1489 Cover Depth: 100 Biscuit Depth: 100 Reducing Slab: NA			
WORK TO BE INSPECTED	Accepted Yes/ No or N/a	Comments	MW Construction Eng/QA Signed as Checked:-	
Setting out to drawing	YES		B.H.S	
Trench excavation supported	YES		B.H.S	
Installation of concrete to channel	NA	PPIC	B.H.S	

QA Form - Manholes


Installation of drainage channel/first manhole ring	YES	PPIC	B.H.S
MWC Signature confirming invert/positioning check	B.H.S	Date	24/06/2025
Client Signature confirming invert/positioning check	Daniel Allen	Date	24/7/25

WORK TO BE INSPECTED	Accepted Yes/ No or N/A	Comments	MW Construction Eng/QA Signed as Checked:-
Installation of manhole rings to required levels	YES	Depths and No's of rings:	B.H.S
Installation of dropshafts/inlets above manhole invert	NA		B.H.S
Manhole Surround	YES	Details: CONCRETE	B.H.S
Backfilling to manhole to required level and layers as instructed in spec	YES		B.H.S
Biscuit Installation	NA	Type: PPIC	B.H.S
Benching/Water proofing to Manhole		NA PPIC	B.H.S
Installation of Step Irons	NA	Type & Numbers: PPIC	B.H.S
Brickwork		No of courses:	
Lid and Frame	YES	Cover Type: D400 600 X 600 X 100	B.H.S
Client Signature confirming Handover of Manhole:-	Daniel Allen	Date	18/9/25

**MWC Signature confirming
Handover of Manhole:-**

B.H.S

Date 24/06/2025

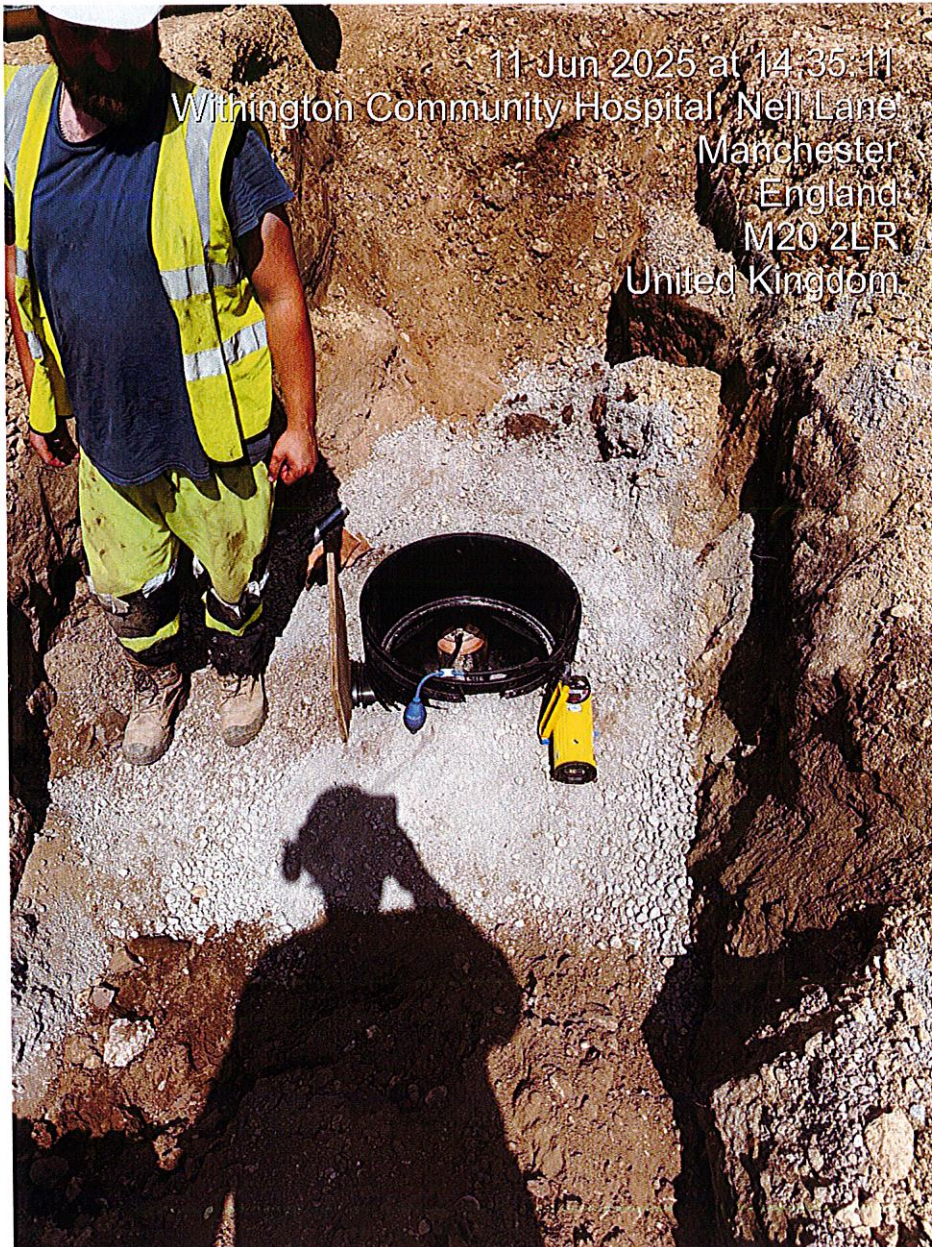



MURRAYWOOD
CONSTRUCTION LTD

QA Form - Manholes



Doc No:

QAF-061

Revision:

5

Issue Date:

10/11/17

Page:

4