

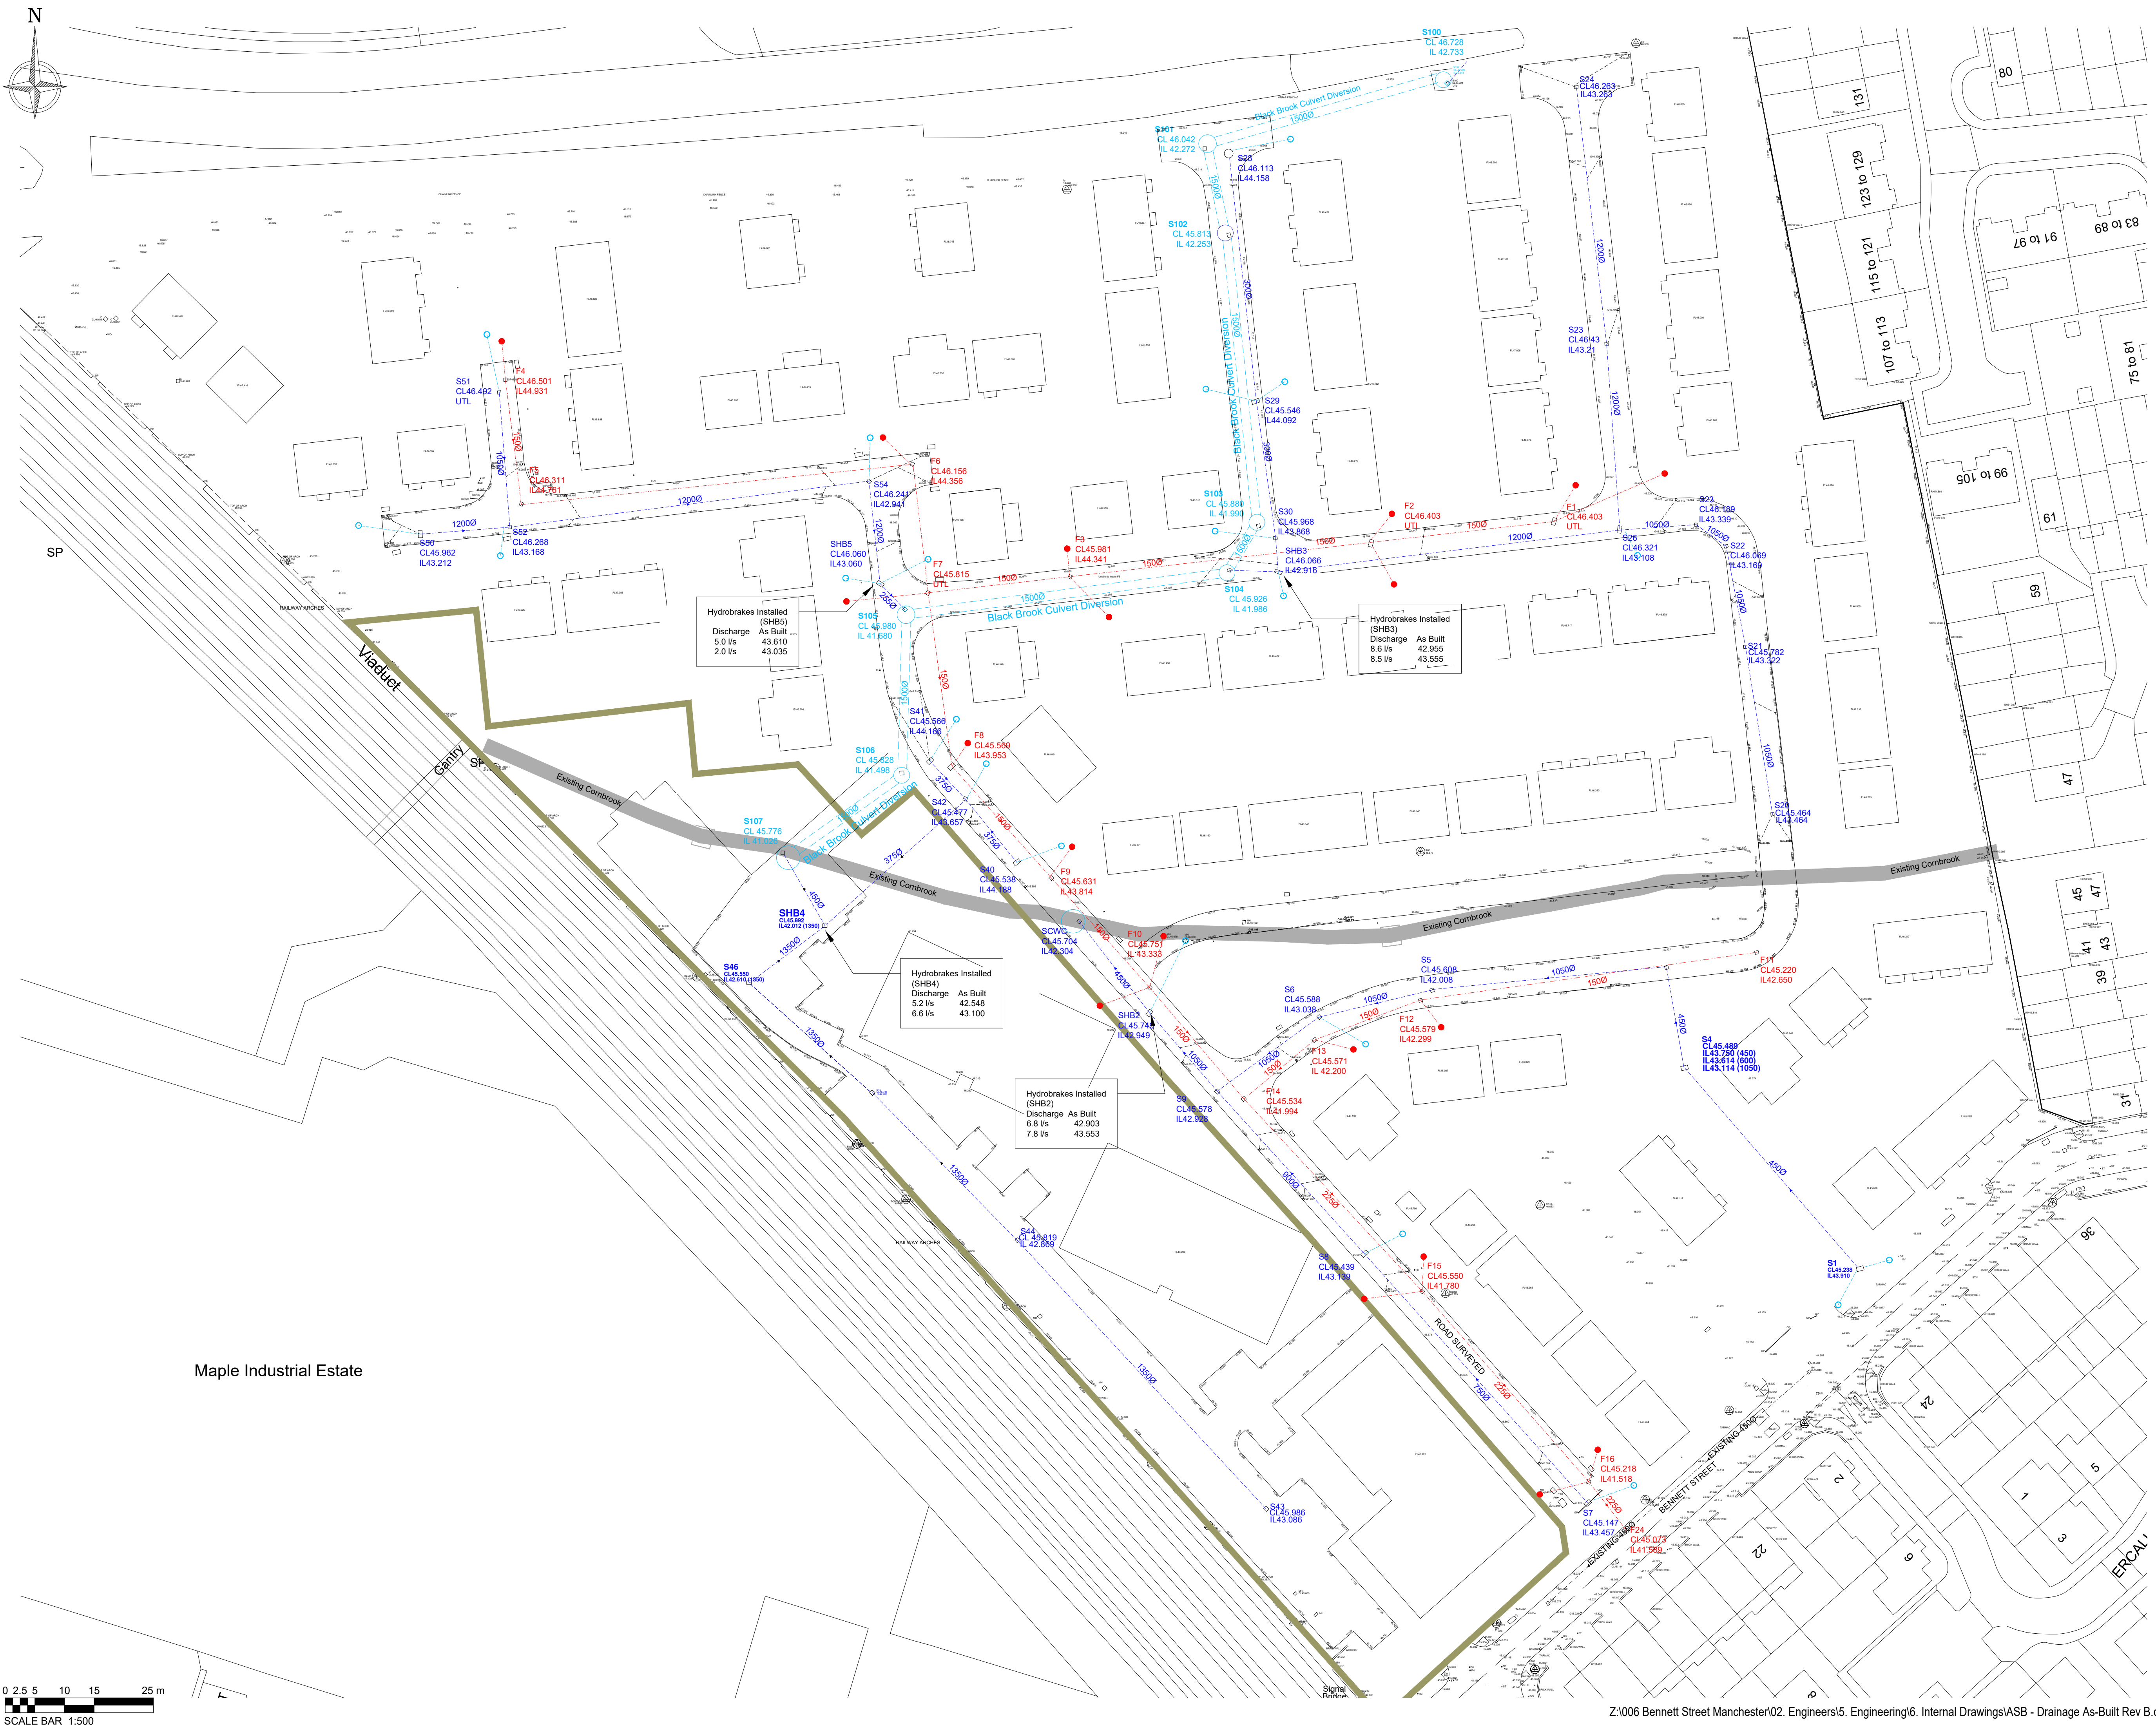


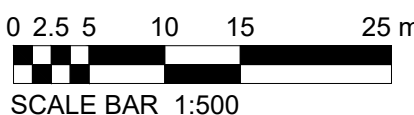

Maple Industrial Estate

Development		
Bennett Street		
Location		
Manchester		
Marketing Name		
-		
Drawing Title		
Drainage As-Built		
Job No.	Drawing No.	
006	77	
Revision	Scale @ A1	
B	-	
Drawn By	Date	
SE	7/7/2025	
Checked by	Date Checked	
-	-	

1st Floor, 103 Dalton Avenue, Birchwood Park,
Warrington WA3 6YE
T: 01925 363108 W: www.kellenhomes.com

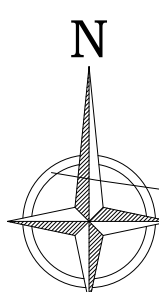