
Revised to reflect as-built development and privacy/daylight amendments.

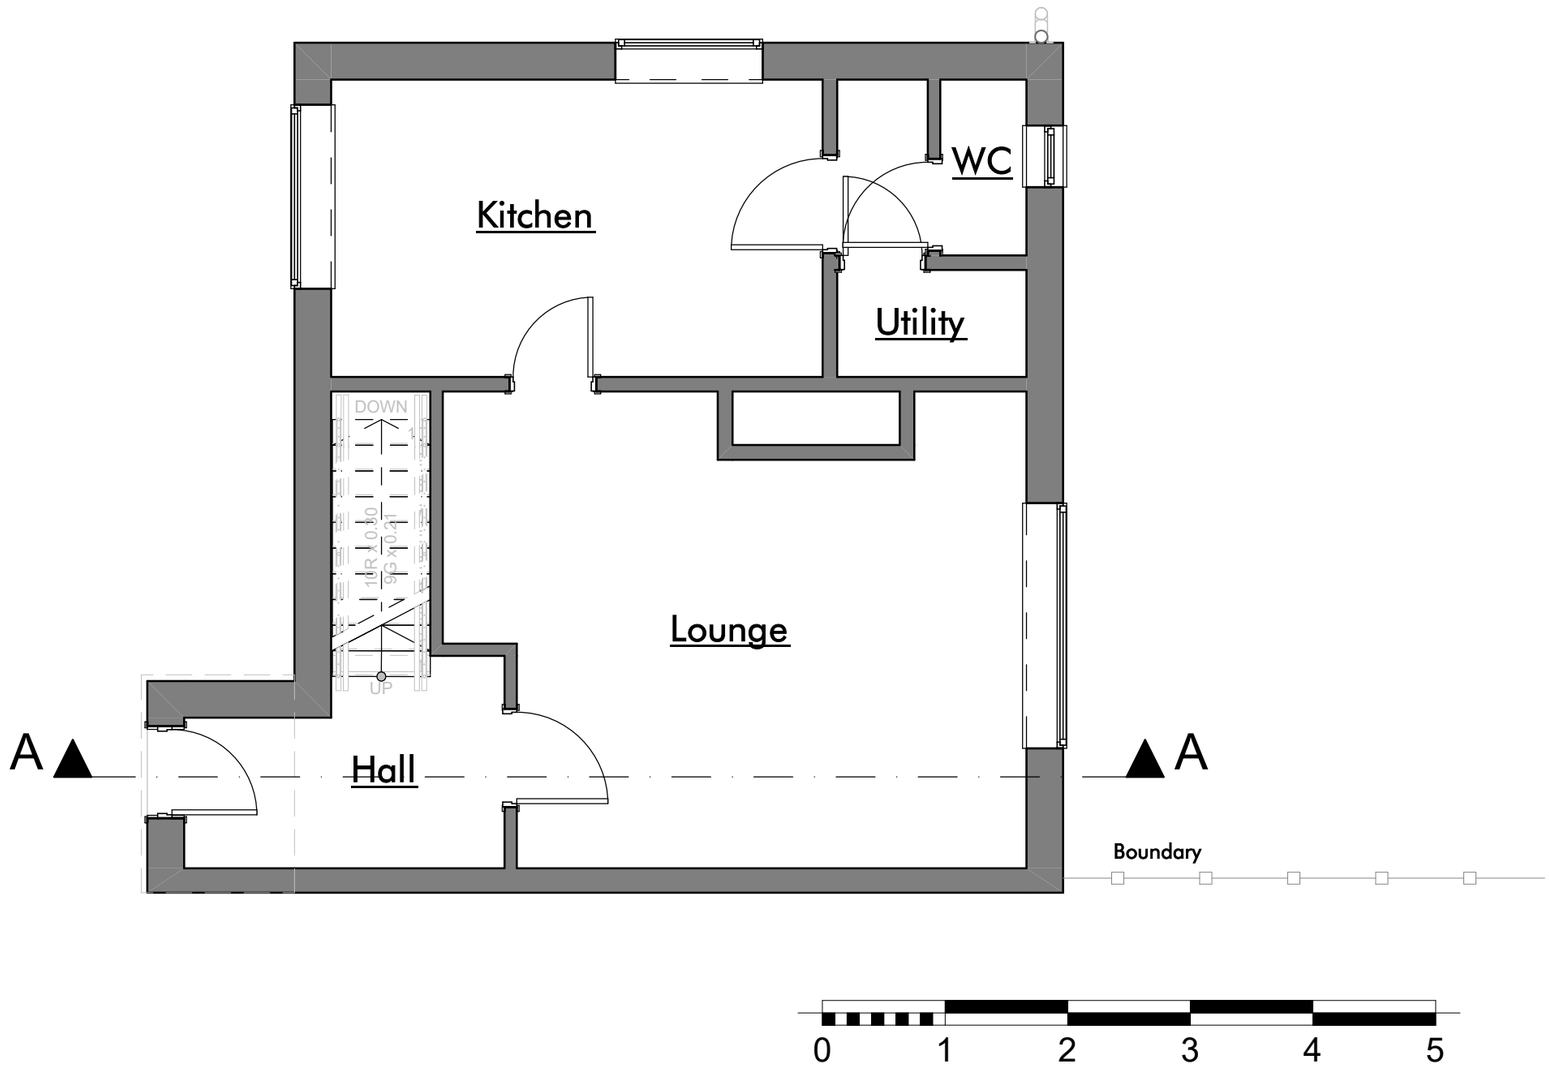

N

General Architectural Note

All drawings, dimensions, and specifications shown in these documents are provided as part of the architectural design intent. Contractors, consultants, and fabricators are responsible for verifying all dimensions and site conditions prior to commencing work. Any discrepancies between drawings, site conditions, or consultant information must be reported to the architect before proceeding.

Drawings are not to be scaled; only written dimensions are to be followed. Details indicated herein take precedence over general notes where conflicts may arise. Final construction shall comply with applicable building codes, regulations, and standards in force at the time of execution.

The contractor shall verify all existing site conditions, boundaries, and levels before commencing construction. Any discrepancies between drawings and actual site conditions must be reported already. The contractor is responsible for maintaining site safety, accessibility, and cleanliness throughout the construction process. All works must comply with local regulations, site access rules, and environmental protection requirements.

48 SOUTH CRESCENT EXTENSION DESIGN

Address

48 SOUTH CRESCENT, MANCHESTER

Document

Architectural drawings

Date

3/2/2026

Drawing

Existing – Pre-Extension Ground Floor Plan

Scale

1:50


Layout

A.01

Contact

Karimiconstrution4@gmail.com

Revised to reflect as-built development and privacy/daylight amendments.

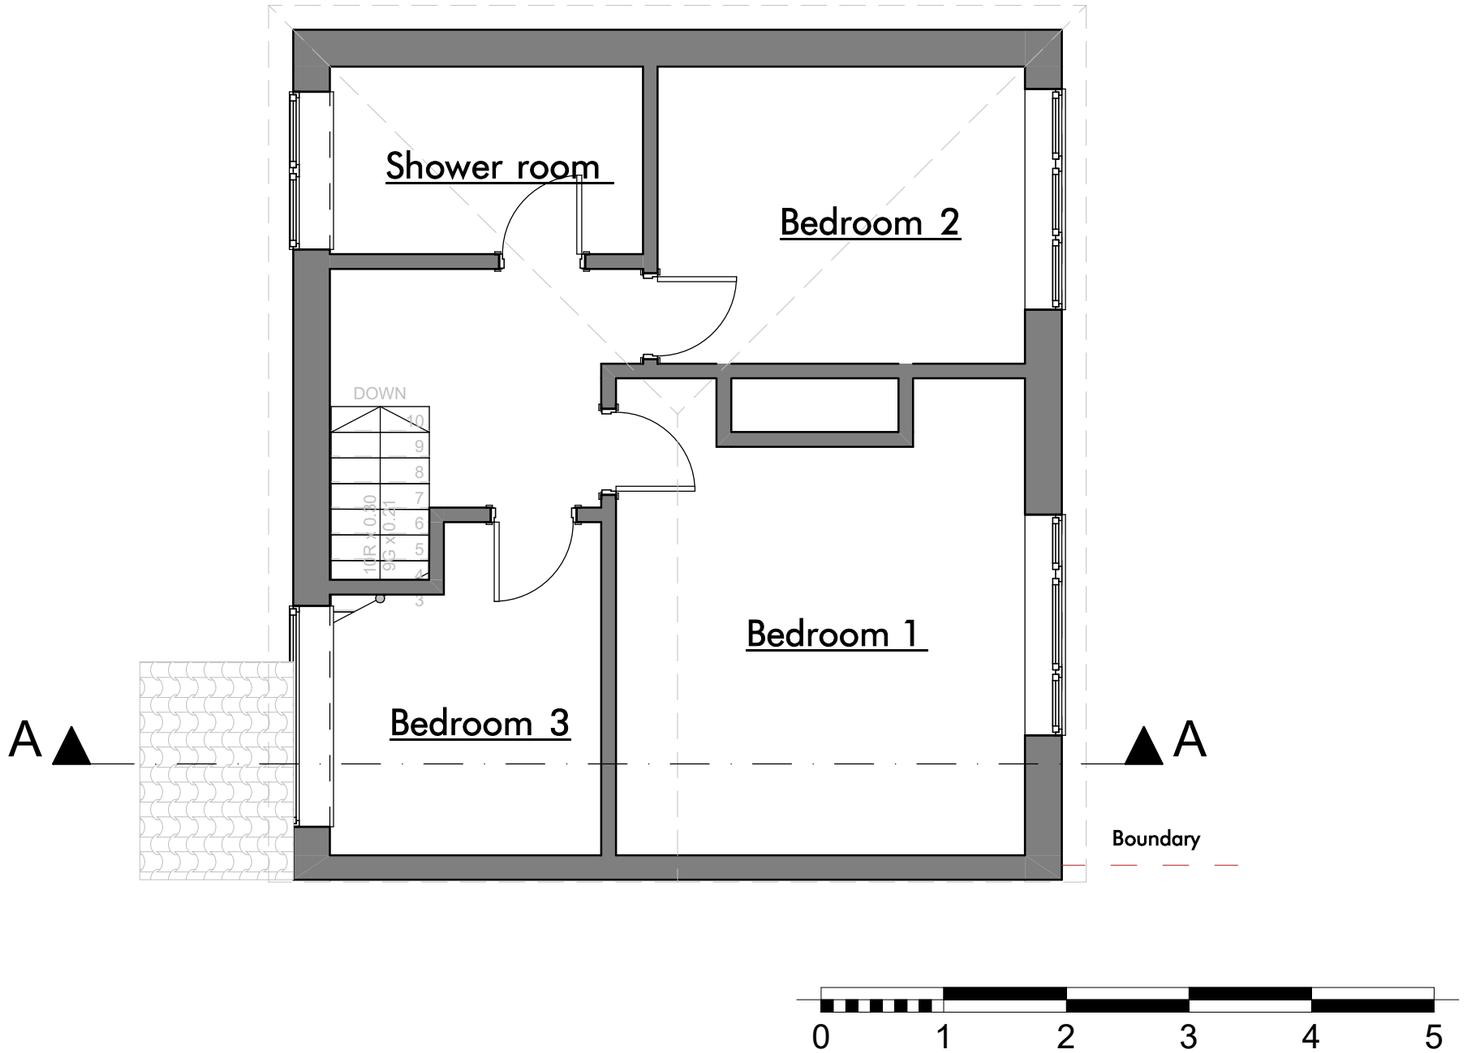

0 1 2 3 4 5

N

General Architectural Note

All drawings, dimensions, and specifications shown in these documents are provided as part of the architectural design intent. Contractors, consultants, and fabricators are responsible for verifying all dimensions and site conditions prior to commencing work. Any discrepancies between drawings, site conditions, or consultant information must be reported to the architect before proceeding.

Drawings are not to be scaled; only written dimensions are to be followed. Details indicated herein take precedence over general notes where conflicts may arise. Final construction shall comply with applicable building codes, regulations, and standards in force at the time of execution.

The contractor shall verify all existing site conditions, boundaries, and levels before commencing construction. Any discrepancies between drawings and actual site conditions must be reported already. The contractor is responsible for maintaining site safety, accessibility, and cleanliness throughout the construction process. All works must comply with local regulations, site access rules, and environmental protection requirements.

48 SOUTH CRESCENT EXTENSION DESIGN

Address
48 SOUTH CRESCENT, MANCHESTER

Document
Architectural drawings

Date
3/2/2026

Drawing
Existing – Pre-Extension Upper Floor Plan


Scale
1:50

Layout
A.02

Contact
Karimiconstrution4@gmail.com

Revised to reflect as-built development and privacy/daylight amendments.



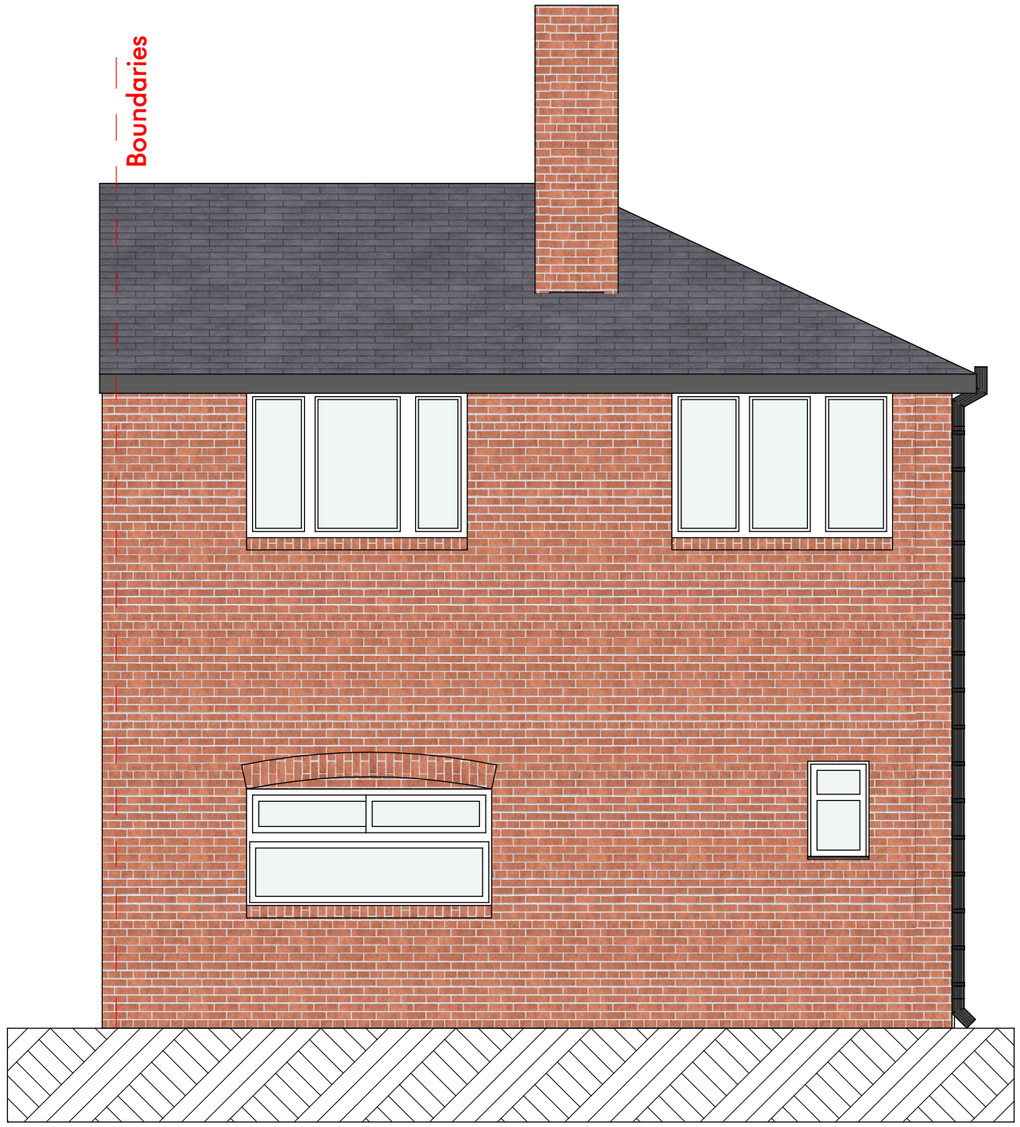

48 SOUTH CRESCENT EXTENSION DESIGN

General Architectural Note

All drawings, dimensions, and specifications shown in these documents are provided as part of the architectural design intent. Contractors, consultants, and fabricators are responsible for verifying all dimensions and site conditions prior to commencing work. Any discrepancies between drawings, site conditions, or consultant information must be reported to the architect before proceeding.

Drawings are not to be scaled; only written dimensions are to be followed. Details indicated herein take precedence over general notes where conflicts may arise. Final construction shall comply with applicable building codes, regulations, and standards in force at the time of execution.

The contractor shall verify all existing site conditions, boundaries, and levels before commencing construction. Any discrepancies between drawings and actual site conditions must be reported already. The contractor is responsible for maintaining site safety, accessibility, and cleanliness throughout the construction process. All works must comply with local regulations, site access rules, and environmental protection requirements.

Address

48 SOUTH CRESCENT, MANCHESTER

Document

Architectural drawings

Date

3/2/2026

Drawing

Existing – Pre-Extension Front and Back Elevation

Scale

1:50


Layout

A.03

Contact

Karimiconstrution4@gmail.com

Revised to reflect as-built development and privacy/daylight amendments.

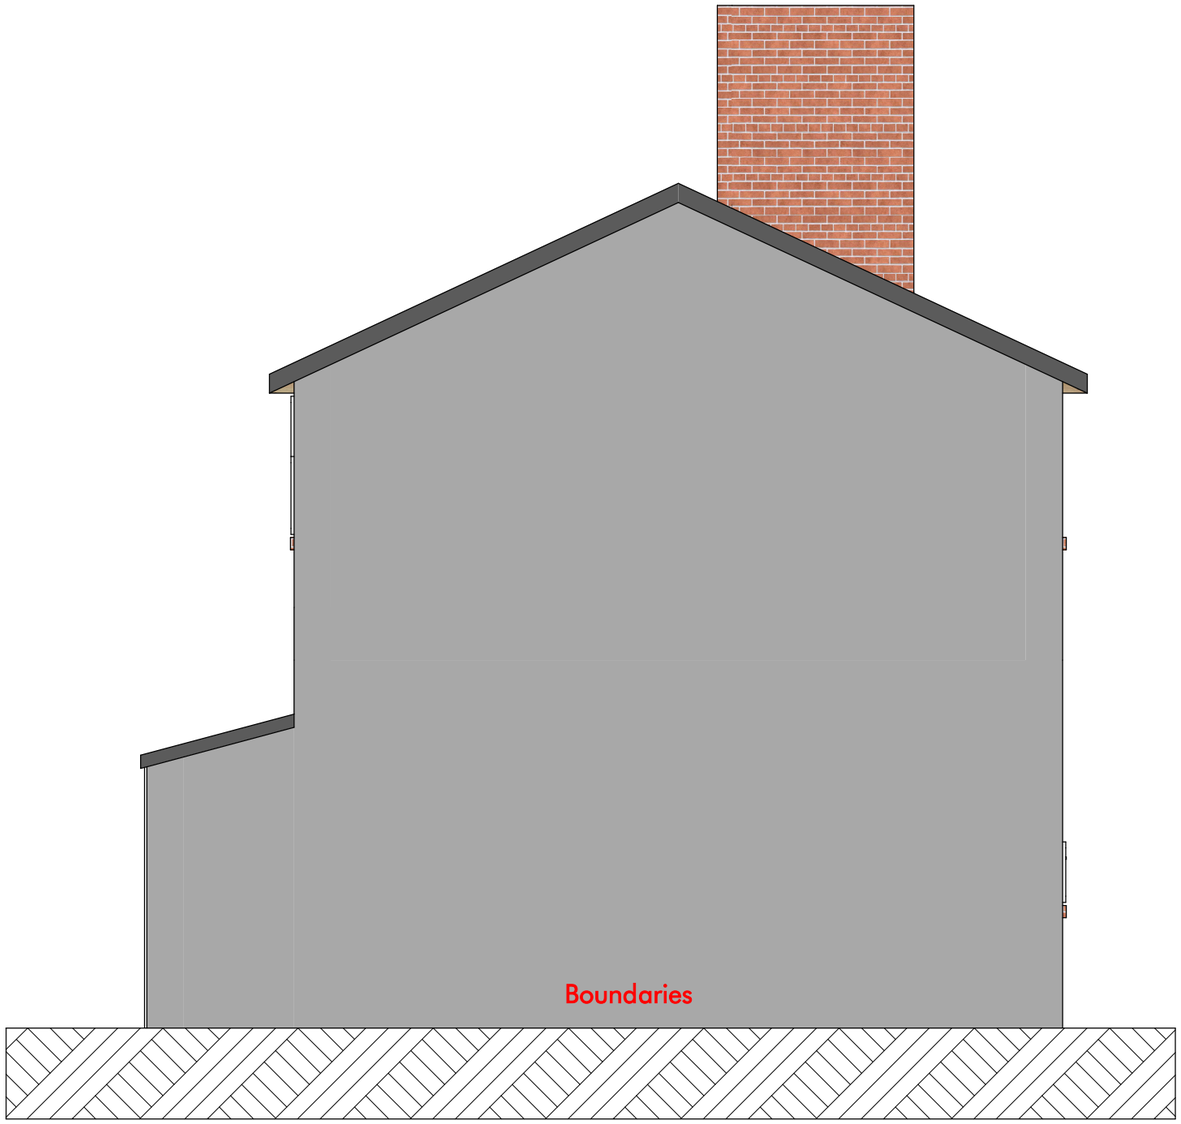

48 SOUTH CRESCENT EXTENSION DESIGN

General Architectural Note

All drawings, dimensions, and specifications shown in these documents are provided as part of the architectural design intent. Contractors, consultants, and fabricators are responsible for verifying all dimensions and site conditions prior to commencing work. Any discrepancies between drawings, site conditions, or consultant information must be reported to the architect before proceeding.

Drawings are not to be scaled; only written dimensions are to be followed. Details indicated herein take precedence over general notes where conflicts may arise. Final construction shall comply with applicable building codes, regulations, and standards in force at the time of execution.

The contractor shall verify all existing site conditions, boundaries, and levels before commencing construction. Any discrepancies between drawings and actual site conditions must be reported already. The contractor is responsible for maintaining site safety, accessibility, and cleanliness throughout the construction process. All works must comply with local regulations, site access rules, and environmental protection requirements.

Address

48 SOUTH CRESCENT, MANCHESTER

Document

Architectural drawings

Date

3/2/2026

Drawing

Existing – Pre-Extension Side Elevation 1

Scale

1:50


Layout

A.04

Contact

Karimiconstrution4@gmail.com

Revised to reflect as-built development and privacy/daylight amendments.

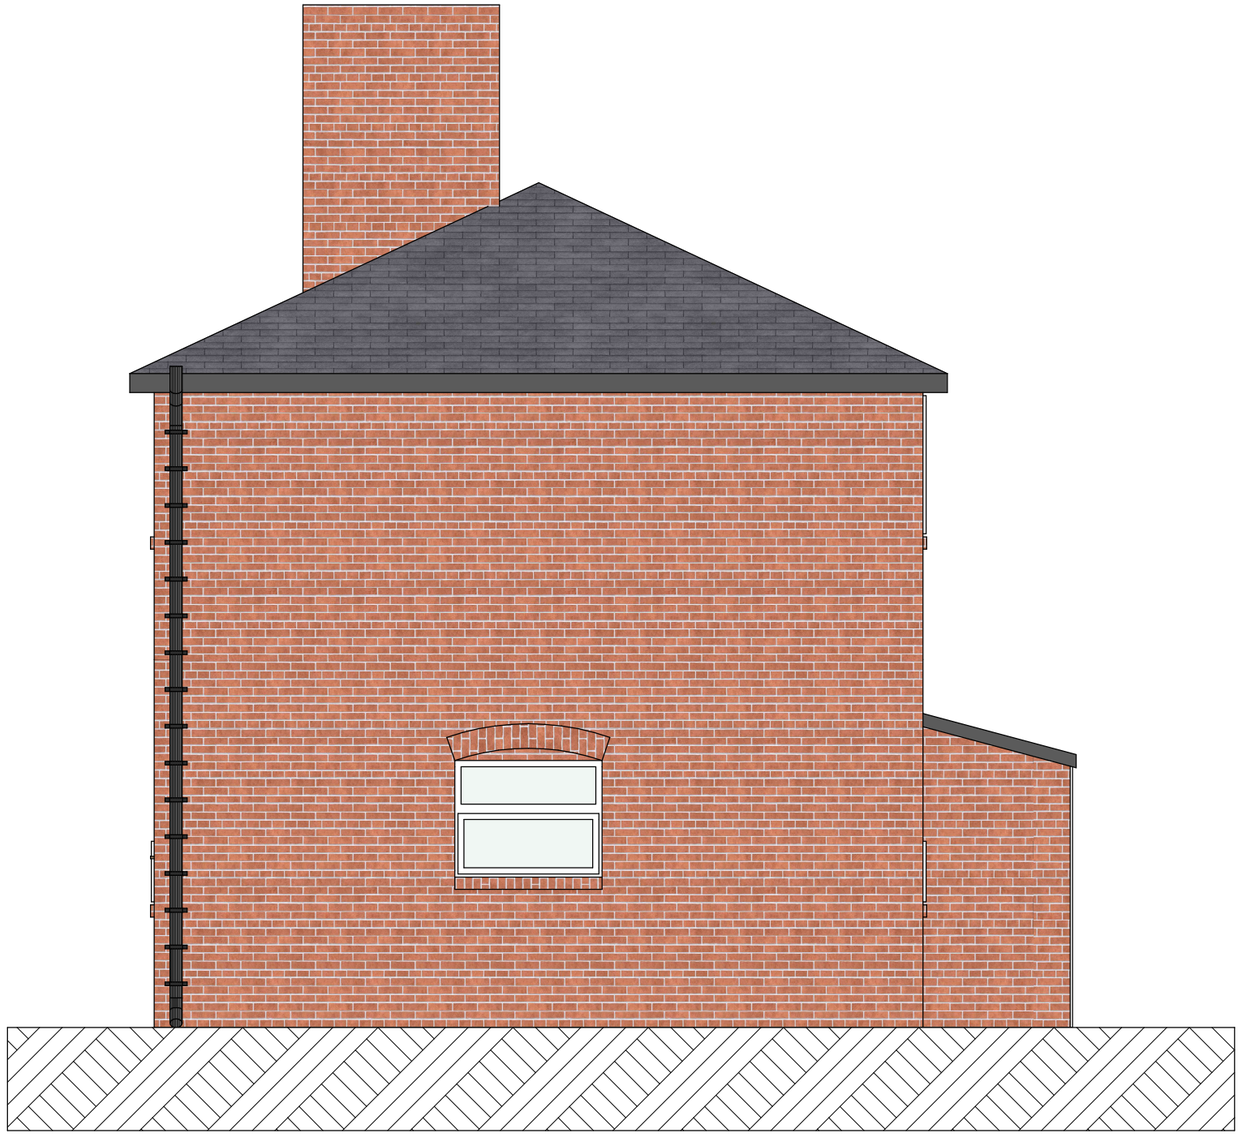

48 SOUTH CRESCENT
EXTENSION DESIGN

General Architectural Note

All drawings, dimensions, and specifications shown in these documents are provided as part of the architectural design intent. Contractors, consultants, and fabricators are responsible for verifying all dimensions and site conditions prior to commencing work. Any discrepancies between drawings, site conditions, or consultant information must be reported to the architect before proceeding.

Drawings are not to be scaled; only written dimensions are to be followed. Details indicated herein take precedence over general notes where conflicts may arise. Final construction shall comply with applicable building codes, regulations, and standards in force at the time of execution.

The contractor shall verify all existing site conditions, boundaries, and levels before commencing construction. Any discrepancies between drawings and actual site conditions must be reported already. The contractor is responsible for maintaining site safety, accessibility, and cleanliness throughout the construction process. All works must comply with local regulations, site access rules, and environmental protection requirements.

Address
48 SOUTH CRESCENT, MANCHESTER

Document
Architectural drawings

Date
3/2/2026


Drawing
Existing – Pre-Extension Side Elevation 2

Scale
1:50

Layout
A.05

Contact
Karimiconstrution4@gmail.com

Revised to reflect as-built development and privacy/daylight amendments.

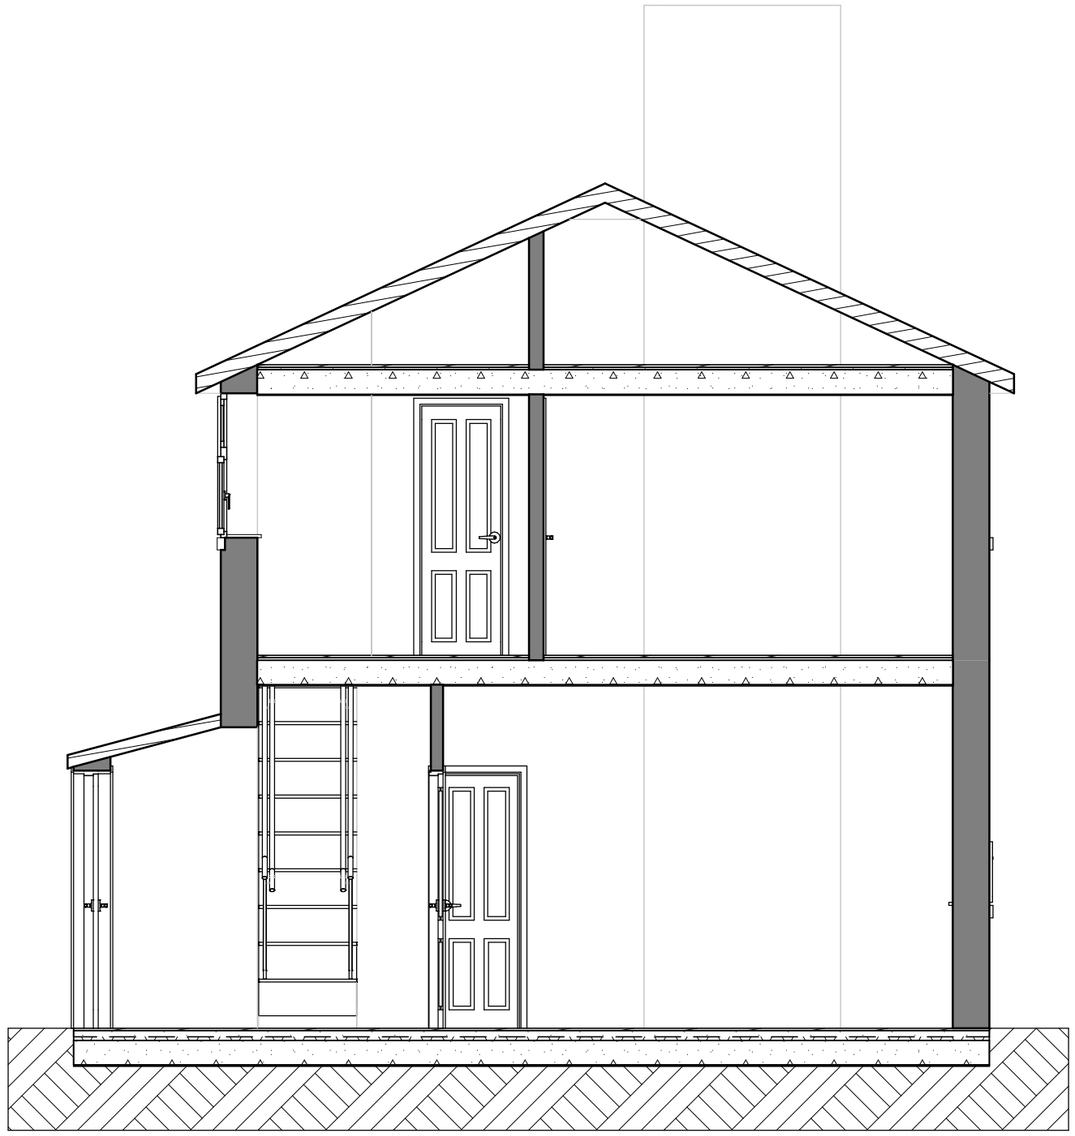

48 SOUTH CRESCENT EXTENSION DESIGN

General Architectural Note

All drawings, dimensions, and specifications shown in these documents are provided as part of the architectural design intent. Contractors, consultants, and fabricators are responsible for verifying all dimensions and site conditions prior to commencing work. Any discrepancies between drawings, site conditions, or consultant information must be reported to the architect before proceeding.

Drawings are not to be scaled; only written dimensions are to be followed. Details indicated herein take precedence over general notes where conflicts may arise. Final construction shall comply with applicable building codes, regulations, and standards in force at the time of execution.

The contractor shall verify all existing site conditions, boundaries, and levels before commencing construction. Any discrepancies between drawings and actual site conditions must be reported already. The contractor is responsible for maintaining site safety, accessibility, and cleanliness throughout the construction process. All works must comply with local regulations, site access rules, and environmental protection requirements.

Address

48 SOUTH CRESCENT, MANCHESTER

Document

Architectural drawings

Date

3/2/2026

Drawing

Existing – Pre-Extension Section AA

Scale

1:50


Layout

A.06

Contact

Karimiconstrution4@gmail.com

Revised to reflect as-built development and privacy/daylight amendments.

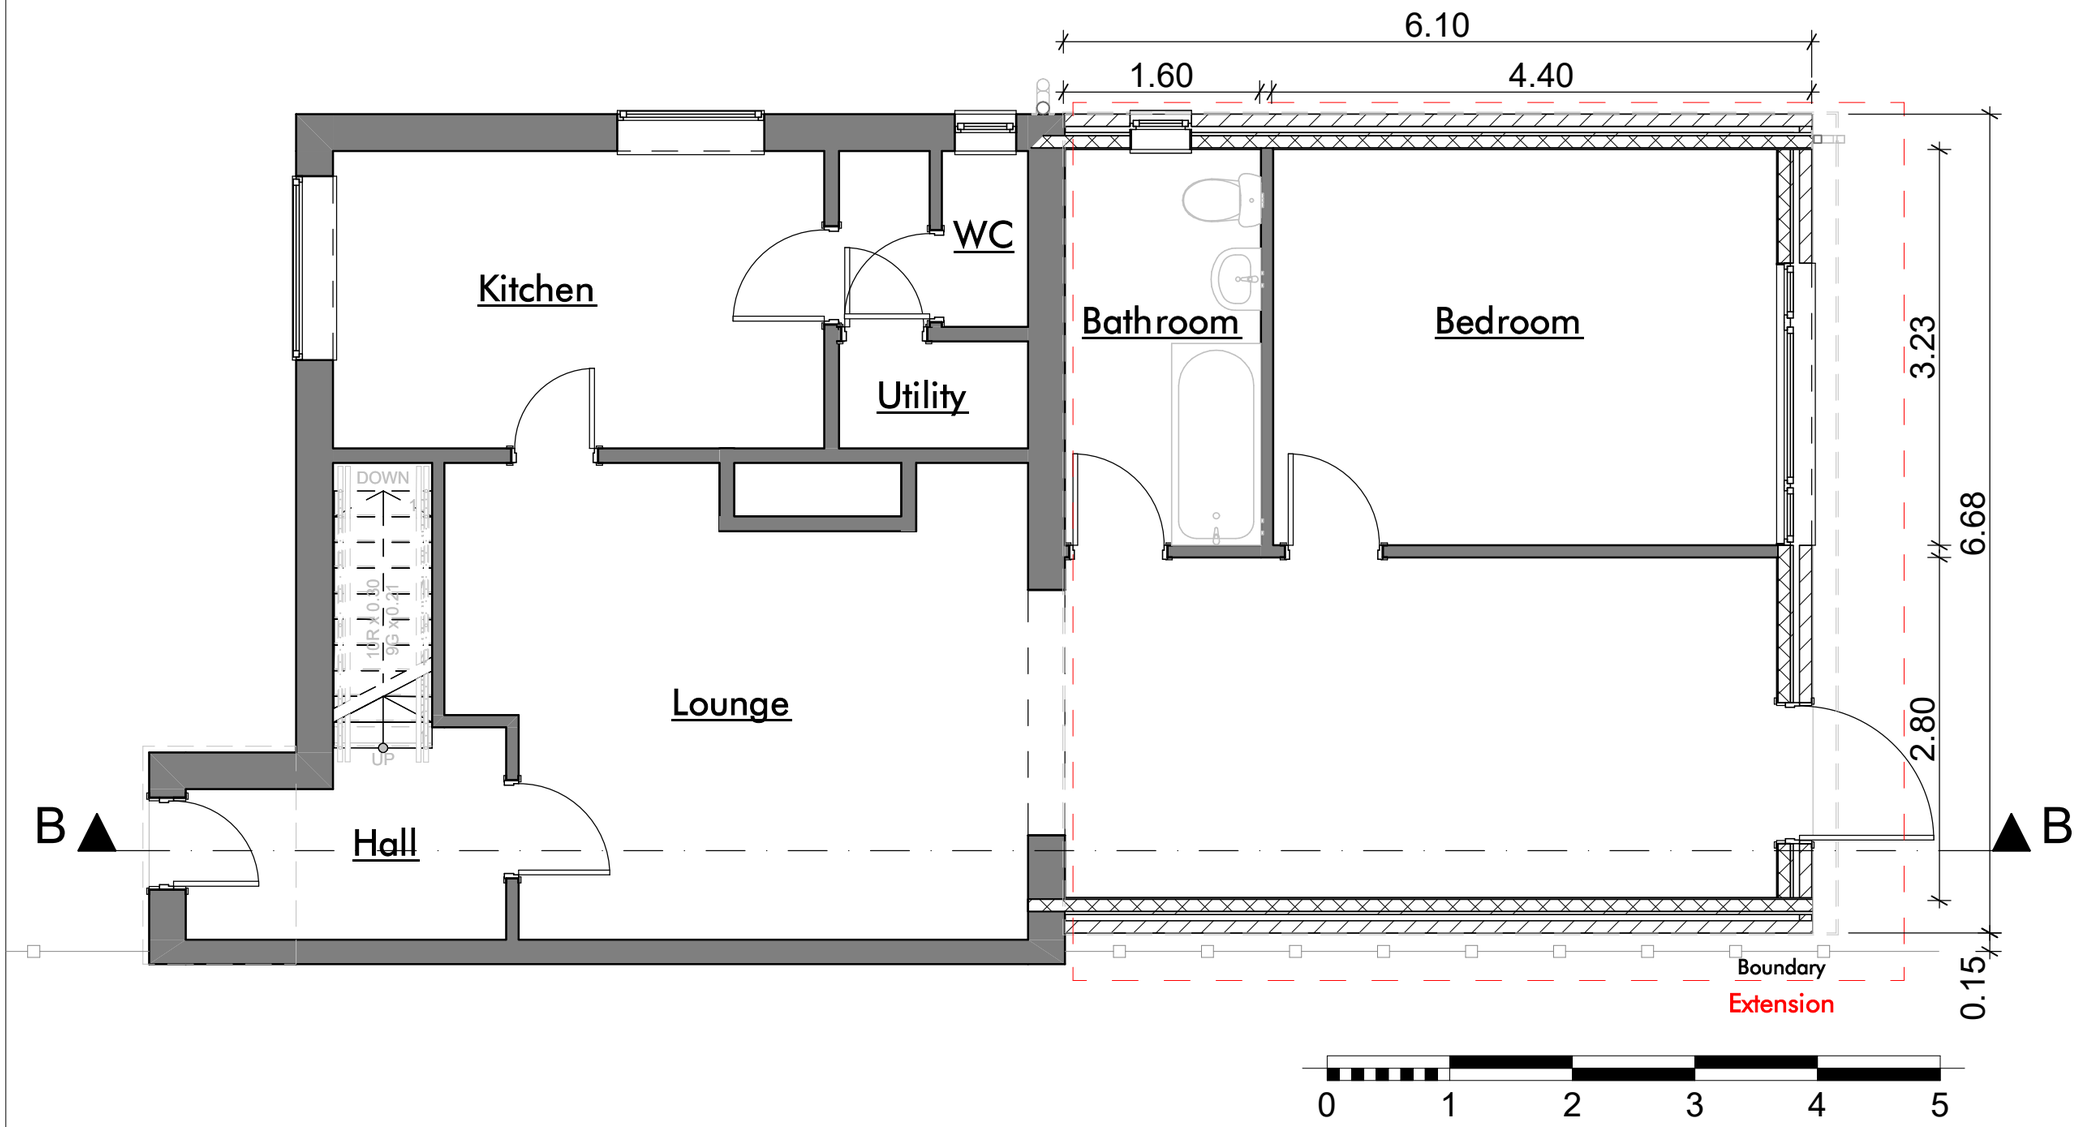

N

General Architectural Note

All drawings, dimensions, and specifications shown in these documents are provided as part of the architectural design intent. Contractors, consultants, and fabricators are responsible for verifying all dimensions and site conditions prior to commencing work. Any discrepancies between drawings, site conditions, or consultant information must be reported to the architect before proceeding.

Drawings are not to be scaled; only written dimensions are to be followed. Details indicated herein take precedence over general notes where conflicts may arise. Final construction shall comply with applicable building codes, regulations, and standards in force at the time of execution.

The contractor shall verify all existing site conditions, boundaries, and levels before commencing construction. Any discrepancies between drawings and actual site conditions must be reported already. The contractor is responsible for maintaining site safety, accessibility, and cleanliness throughout the construction process. All works must comply with local regulations, site access rules, and environmental protection requirements.

48 SOUTH CRESCENT EXTENSION DESIGN

Address
48 SOUTH CRESCENT, MANCHESTER

Document
Architectural drawings

Date
3/2/2026


Drawing
Existing – As Built Ground Floor plan

Scale
1:50

Layout
A.07

Contact
Karimiconstrution4@gmail.com

Revised to reflect as-built development and privacy/daylight amendments.

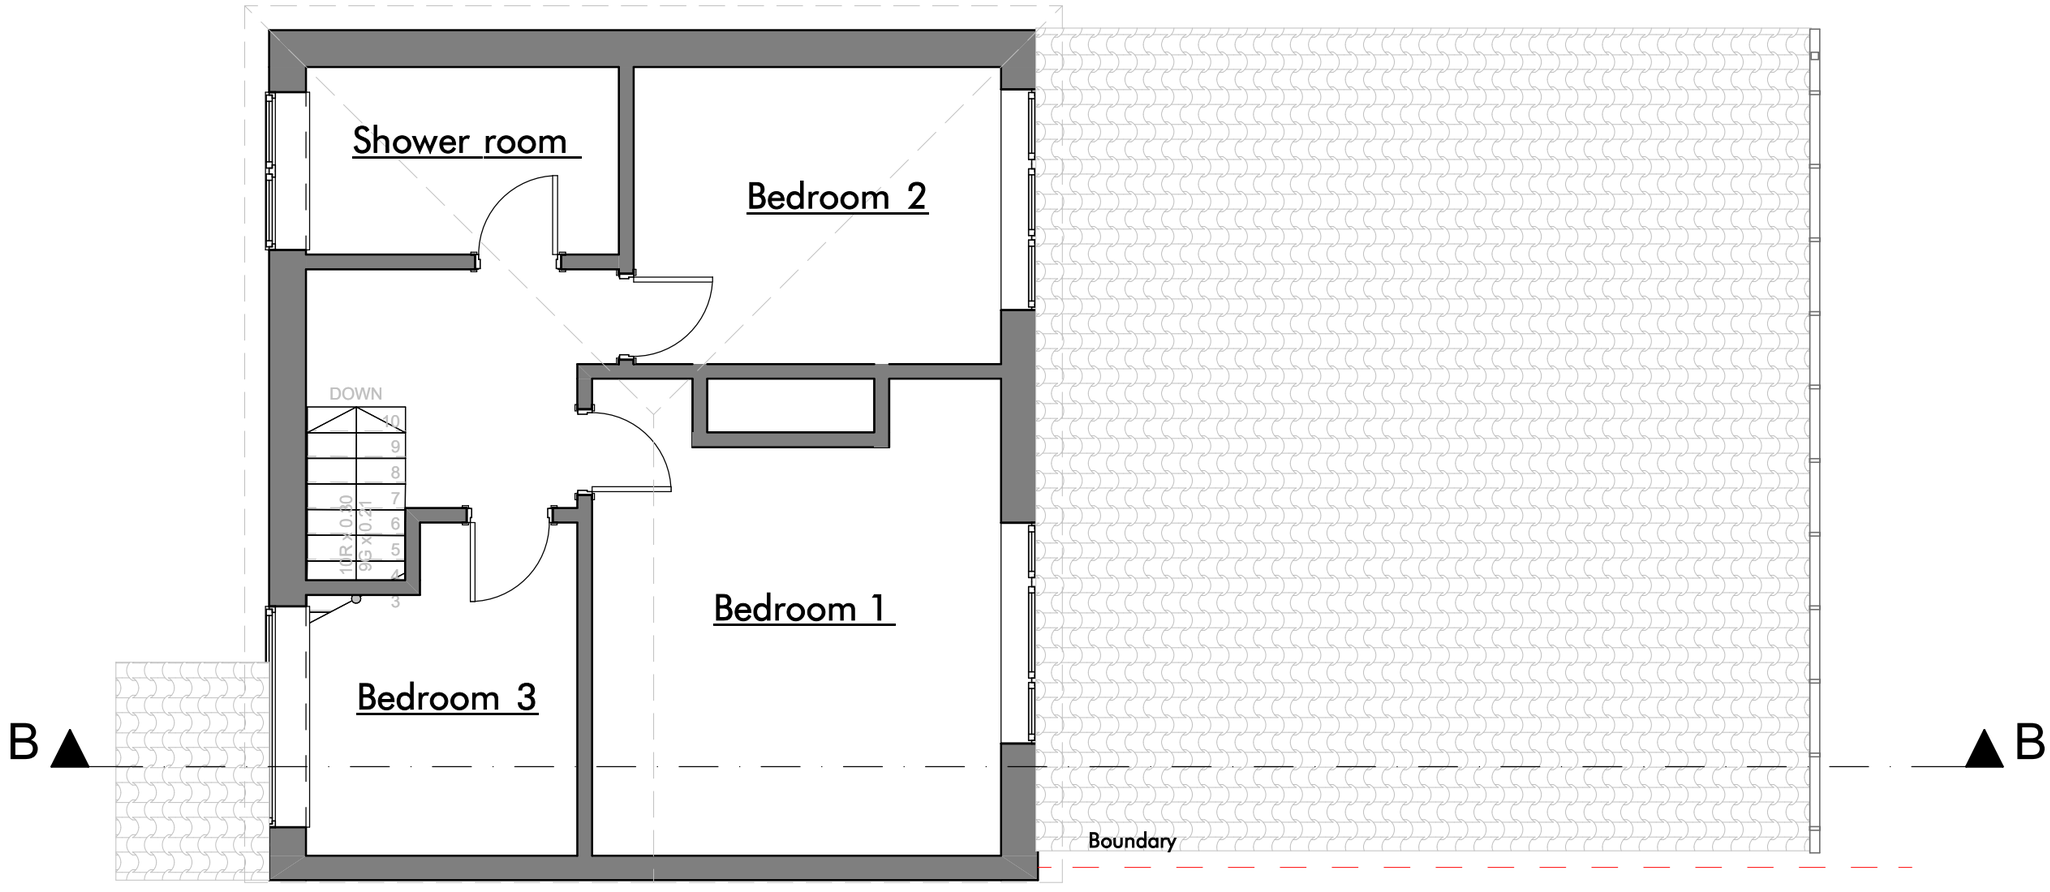

0 1 2 3 4 5

N

48 SOUTH CRESCENT EXTENSION DESIGN

General Architectural Note

All drawings, dimensions, and specifications shown in these documents are provided as part of the architectural design intent. Contractors, consultants, and fabricators are responsible for verifying all dimensions and site conditions prior to commencing work. Any discrepancies between drawings, site conditions, or consultant information must be reported to the architect before proceeding.

Drawings are not to be scaled; only written dimensions are to be followed. Details indicated herein take precedence over general notes where conflicts may arise. Final construction shall comply with applicable building codes, regulations, and standards in force at the time of execution.

The contractor shall verify all existing site conditions, boundaries, and levels before commencing construction. Any discrepancies between drawings and actual site conditions must be reported already. The contractor is responsible for maintaining site safety, accessibility, and cleanliness throughout the construction process. All works must comply with local regulations, site access rules, and environmental protection requirements.

Address
48 SOUTH CRESCENT, MANCHESTER

Document
Architectural drawings

Date
3/2/2026

Drawing
Existing – As Built Upper Floor Plan

Scale
1:50

Layout
A.08

Contact
Karimiconstrution4@gmail.com

Revised to reflect as-built development and privacy/daylight amendments.





48 SOUTH CRESCENT EXTENSION DESIGN

General Architectural Note

All drawings, dimensions, and specifications shown in these documents are provided as part of the architectural design intent. Contractors, consultants, and fabricators are responsible for verifying all dimensions and site conditions prior to commencing work. Any discrepancies between drawings, site conditions, or consultant information must be reported to the architect before proceeding.

Drawings are not to be scaled; only written dimensions are to be followed. Details indicated herein take precedence over general notes where conflicts may arise. Final construction shall comply with applicable building codes, regulations, and standards in force at the time of execution.

The contractor shall verify all existing site conditions, boundaries, and levels before commencing construction. Any discrepancies between drawings and actual site conditions must be reported already. The contractor is responsible for maintaining site safety, accessibility, and cleanliness throughout the construction process. All works must comply with local regulations, site access rules, and environmental protection requirements.

Address

48 SOUTH CRESCENT, MANCHESTER

Document

Architectural drawings

Date

3/2/2026

Drawing

Existing – As Built Front and Back Elevation

Scale

1:50


Layout

A.09

Contact

Karimiconstrution4@gmail.com

Revised to reflect as-built development and privacy/daylight amendments.

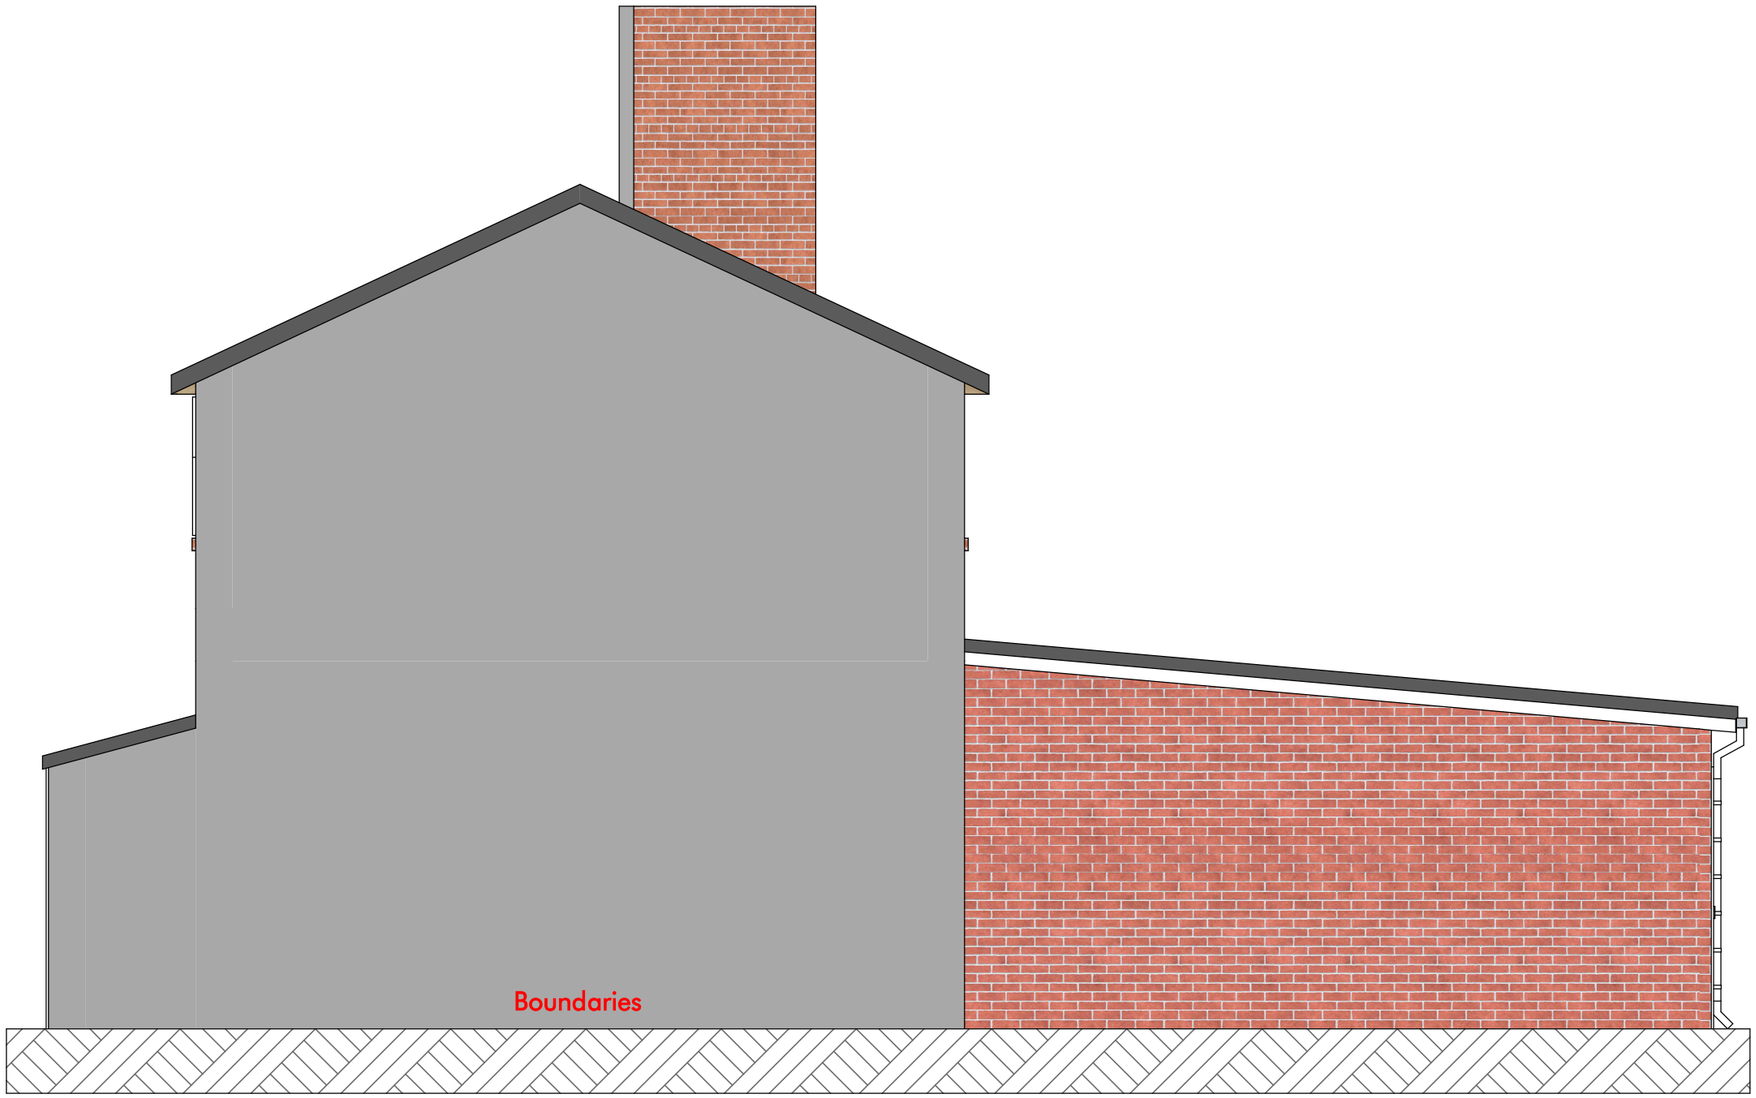

48 SOUTH CRESCENT
EXTENSION DESIGN

General Architectural Note

All drawings, dimensions, and specifications shown in these documents are provided as part of the architectural design intent. Contractors, consultants, and fabricators are responsible for verifying all dimensions and site conditions prior to commencing work. Any discrepancies between drawings, site conditions, or consultant information must be reported to the architect before proceeding.

Drawings are not to be scaled; only written dimensions are to be followed. Details indicated herein take precedence over general notes where conflicts may arise. Final construction shall comply with applicable building codes, regulations, and standards in force at the time of execution.

The contractor shall verify all existing site conditions, boundaries, and levels before commencing construction. Any discrepancies between drawings and actual site conditions must be reported already. The contractor is responsible for maintaining site safety, accessibility, and cleanliness throughout the construction process. All works must comply with local regulations, site access rules, and environmental protection requirements.

Address
48 SOUTH CRESCENT, MANCHESTER

Document
Architectural drawings

Date
3/2/2026


Drawing
Existing – As Built Side Elevation 1

Scale
1:50

Layout
A.10

Contact
Karimiconstrution4@gmail.com

Revised to reflect as-built development and privacy/daylight amendments.

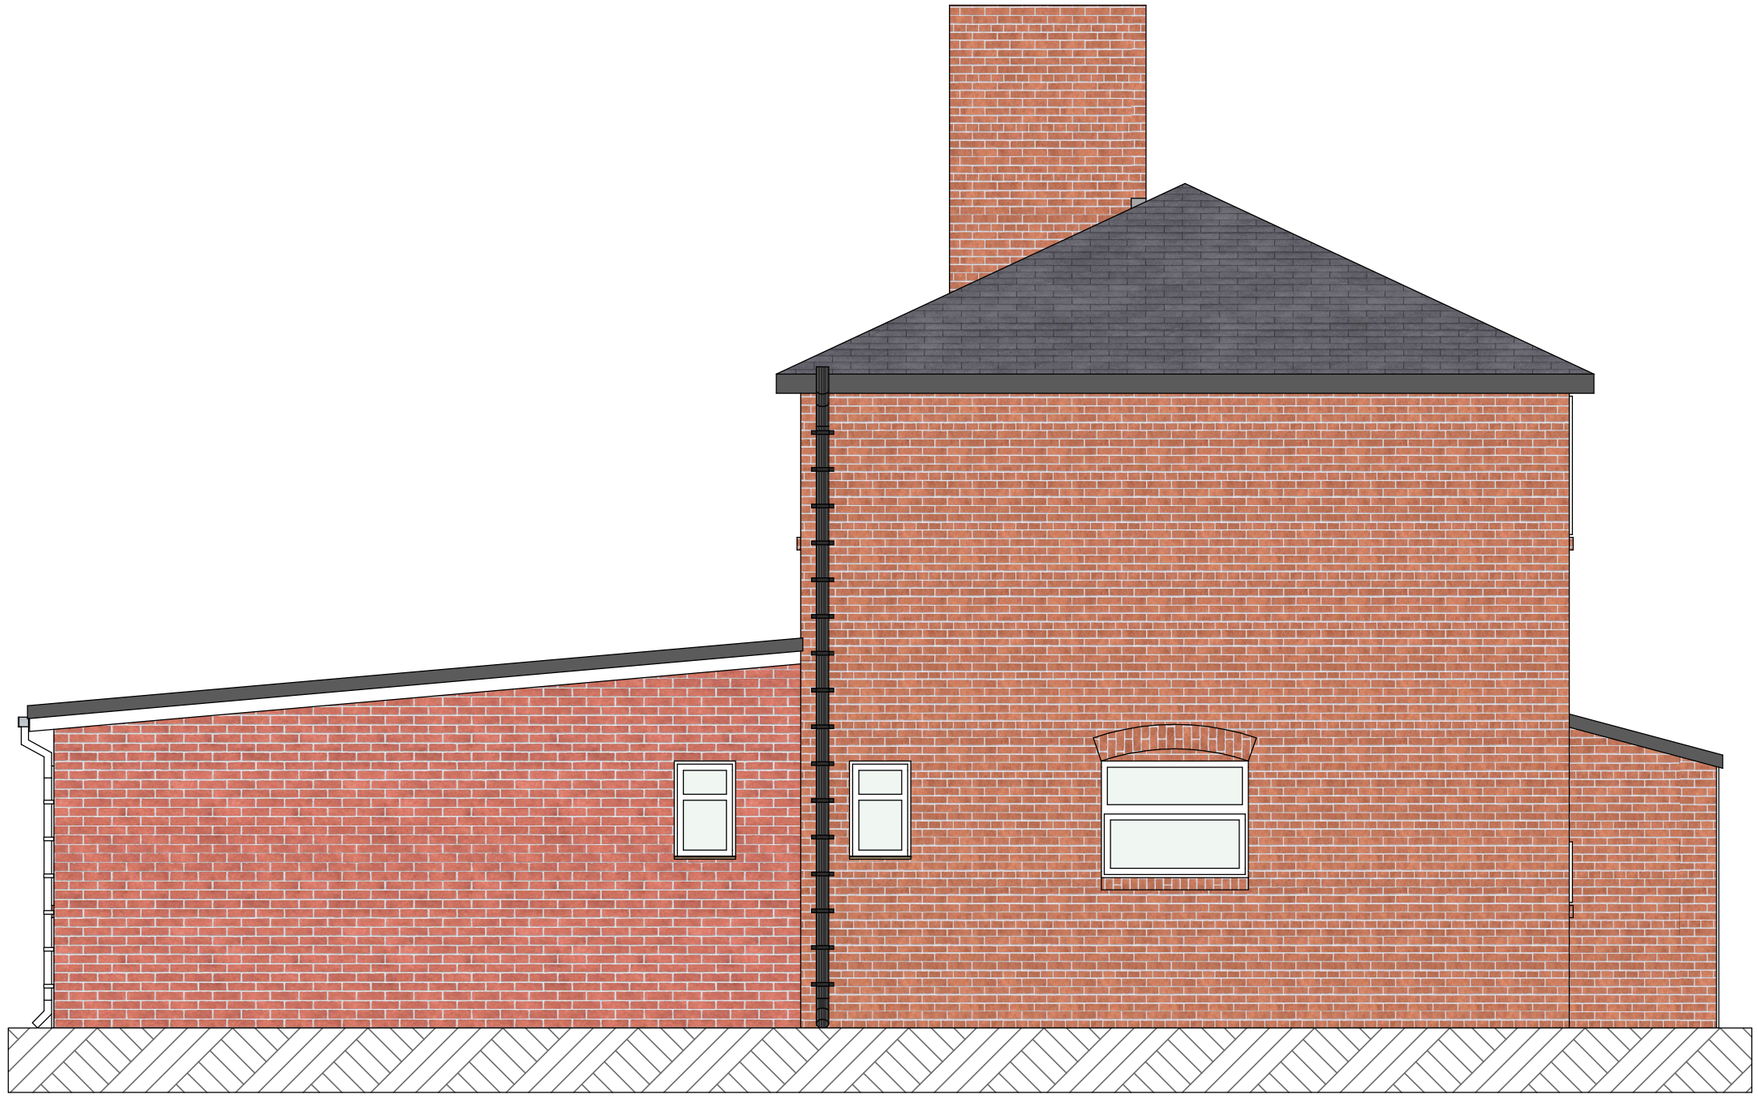

48 SOUTH CRESCENT
EXTENSION DESIGN

General Architectural Note

All drawings, dimensions, and specifications shown in these documents are provided as part of the architectural design intent. Contractors, consultants, and fabricators are responsible for verifying all dimensions and site conditions prior to commencing work. Any discrepancies between drawings, site conditions, or consultant information must be reported to the architect before proceeding.

Drawings are not to be scaled; only written dimensions are to be followed. Details indicated herein take precedence over general notes where conflicts may arise. Final construction shall comply with applicable building codes, regulations, and standards in force at the time of execution.

The contractor shall verify all existing site conditions, boundaries, and levels before commencing construction. Any discrepancies between drawings and actual site conditions must be reported already. The contractor is responsible for maintaining site safety, accessibility, and cleanliness throughout the construction process. All works must comply with local regulations, site access rules, and environmental protection requirements.

Address
48 SOUTH CRESCENT, MANCHESTER

Document
Architectural drawings

Date
3/2/2026


Drawing
Existing – As Built Side Elevation 2

Scale
1:50

Layout
A.11

Contact
Karimiconstrution4@gmail.com

Revised to reflect as-built development and privacy/daylight amendments.

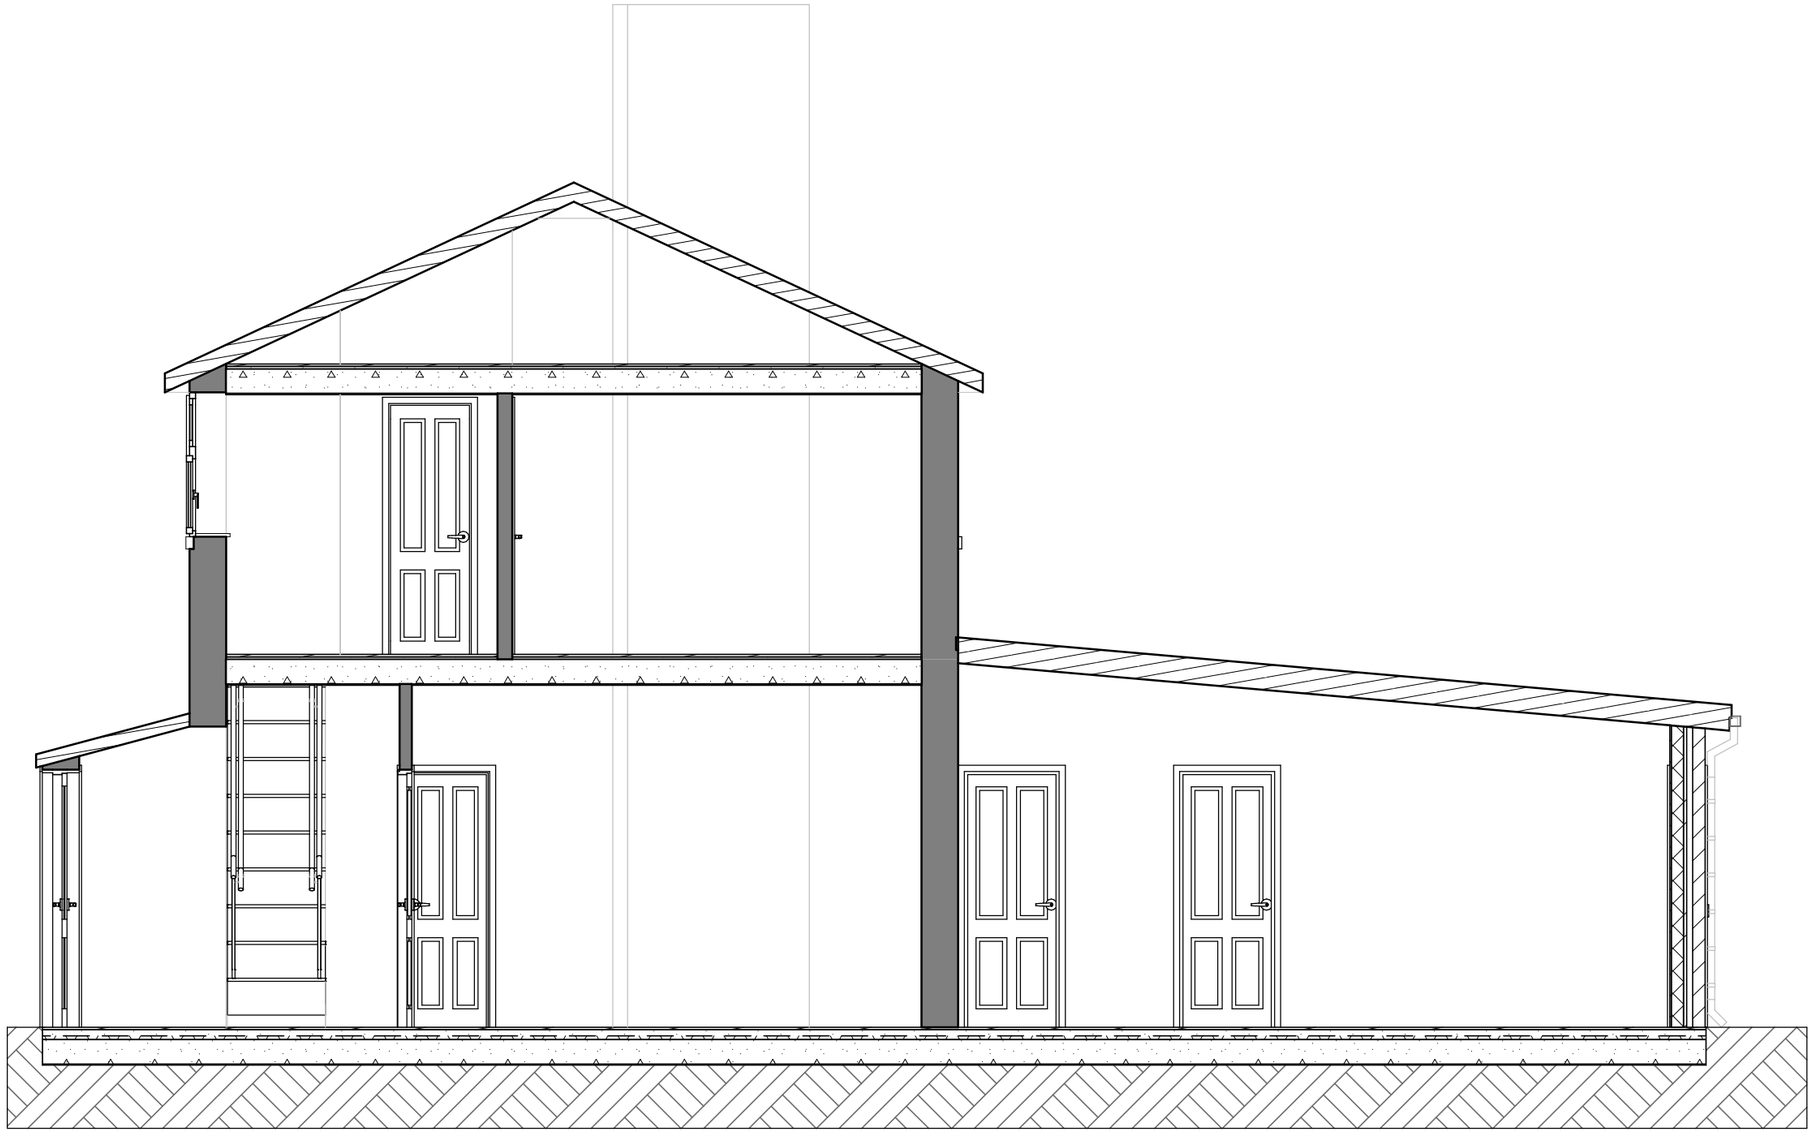

48 SOUTH CRESCENT
EXTENSION DESIGN

General Architectural Note

All drawings, dimensions, and specifications shown in these documents are provided as part of the architectural design intent. Contractors, consultants, and fabricators are responsible for verifying all dimensions and site conditions prior to commencing work. Any discrepancies between drawings, site conditions, or consultant information must be reported to the architect before proceeding.

Drawings are not to be scaled; only written dimensions are to be followed. Details indicated herein take precedence over general notes where conflicts may arise. Final construction shall comply with applicable building codes, regulations, and standards in force at the time of execution.

The contractor shall verify all existing site conditions, boundaries, and levels before commencing construction. Any discrepancies between drawings and actual site conditions must be reported already. The contractor is responsible for maintaining site safety, accessibility, and cleanliness throughout the construction process. All works must comply with local regulations, site access rules, and environmental protection requirements.

Address
48 SOUTH CRESCENT, MANCHESTER

Document
Architectural drawings

Date
3/2/2026


Drawing
Existing – As Built Section BB

Scale
1:50

Layout
A.12

Contact
Karimiconstrution4@gmail.com

Revised to reflect as-built development and privacy/daylight amendments.

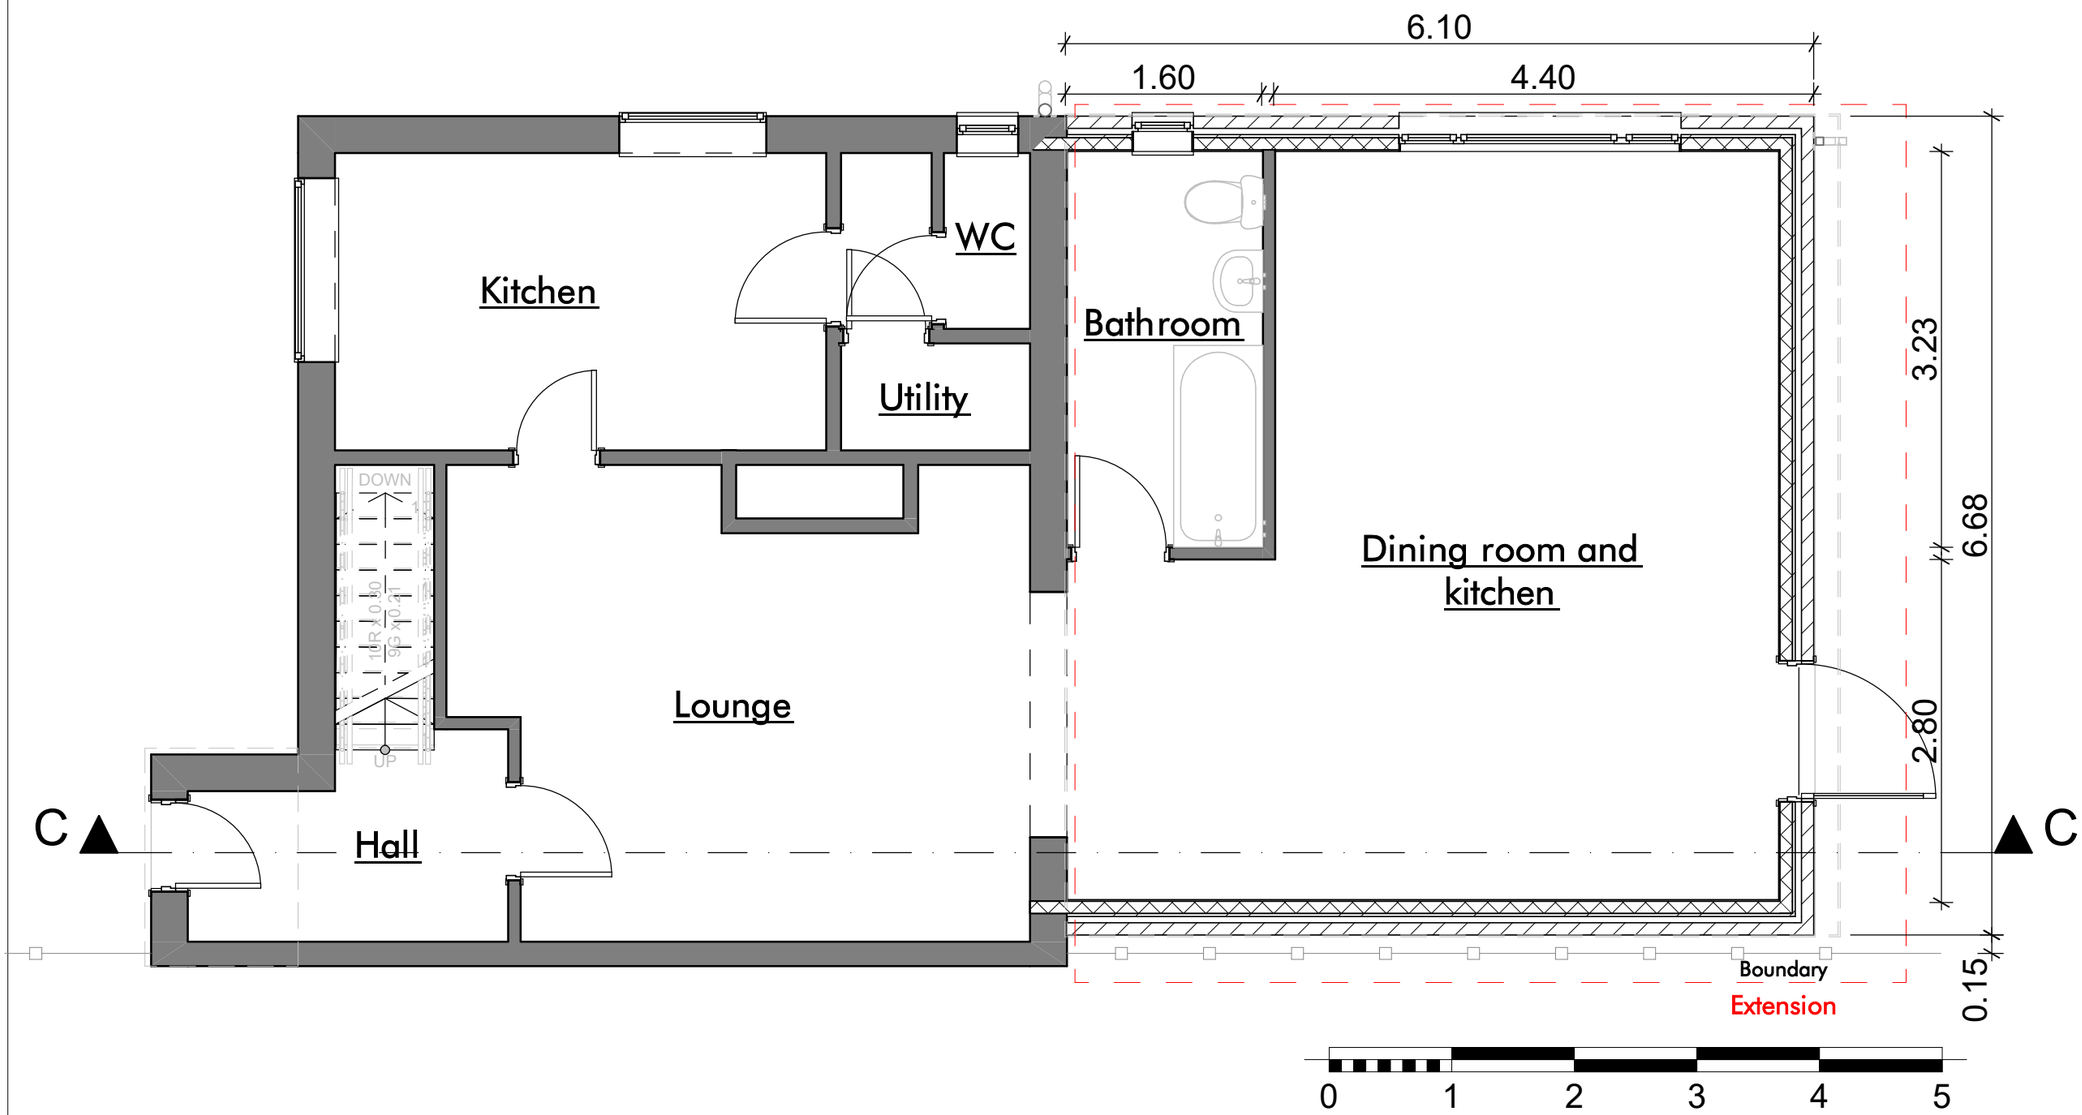

N

General Architectural Note

All drawings, dimensions, and specifications shown in these documents are provided as part of the architectural design intent. Contractors, consultants, and fabricators are responsible for verifying all dimensions and site conditions prior to commencing work. Any discrepancies between drawings, site conditions, or consultant information must be reported to the architect before proceeding.

Drawings are not to be scaled; only written dimensions are to be followed. Details indicated herein take precedence over general notes where conflicts may arise. Final construction shall comply with applicable building codes, regulations, and standards in force at the time of execution.

The contractor shall verify all existing site conditions, boundaries, and levels before commencing construction. Any discrepancies between drawings and actual site conditions must be reported already. The contractor is responsible for maintaining site safety, accessibility, and cleanliness throughout the construction process. All works must comply with local regulations, site access rules, and environmental protection requirements.

48 SOUTH CRESCENT EXTENSION DESIGN

Address
48 SOUTH CRESCENT, MANCHESTER

Document
Architectural drawings

Date
3/2/2026


Drawing
Proposed – Revised Scheme Ground Floor Plan

Scale
1:50

Layout
A.13

Contact
Karimiconstrution4@gmail.com

Revised to reflect as-built development and privacy/daylight amendments.

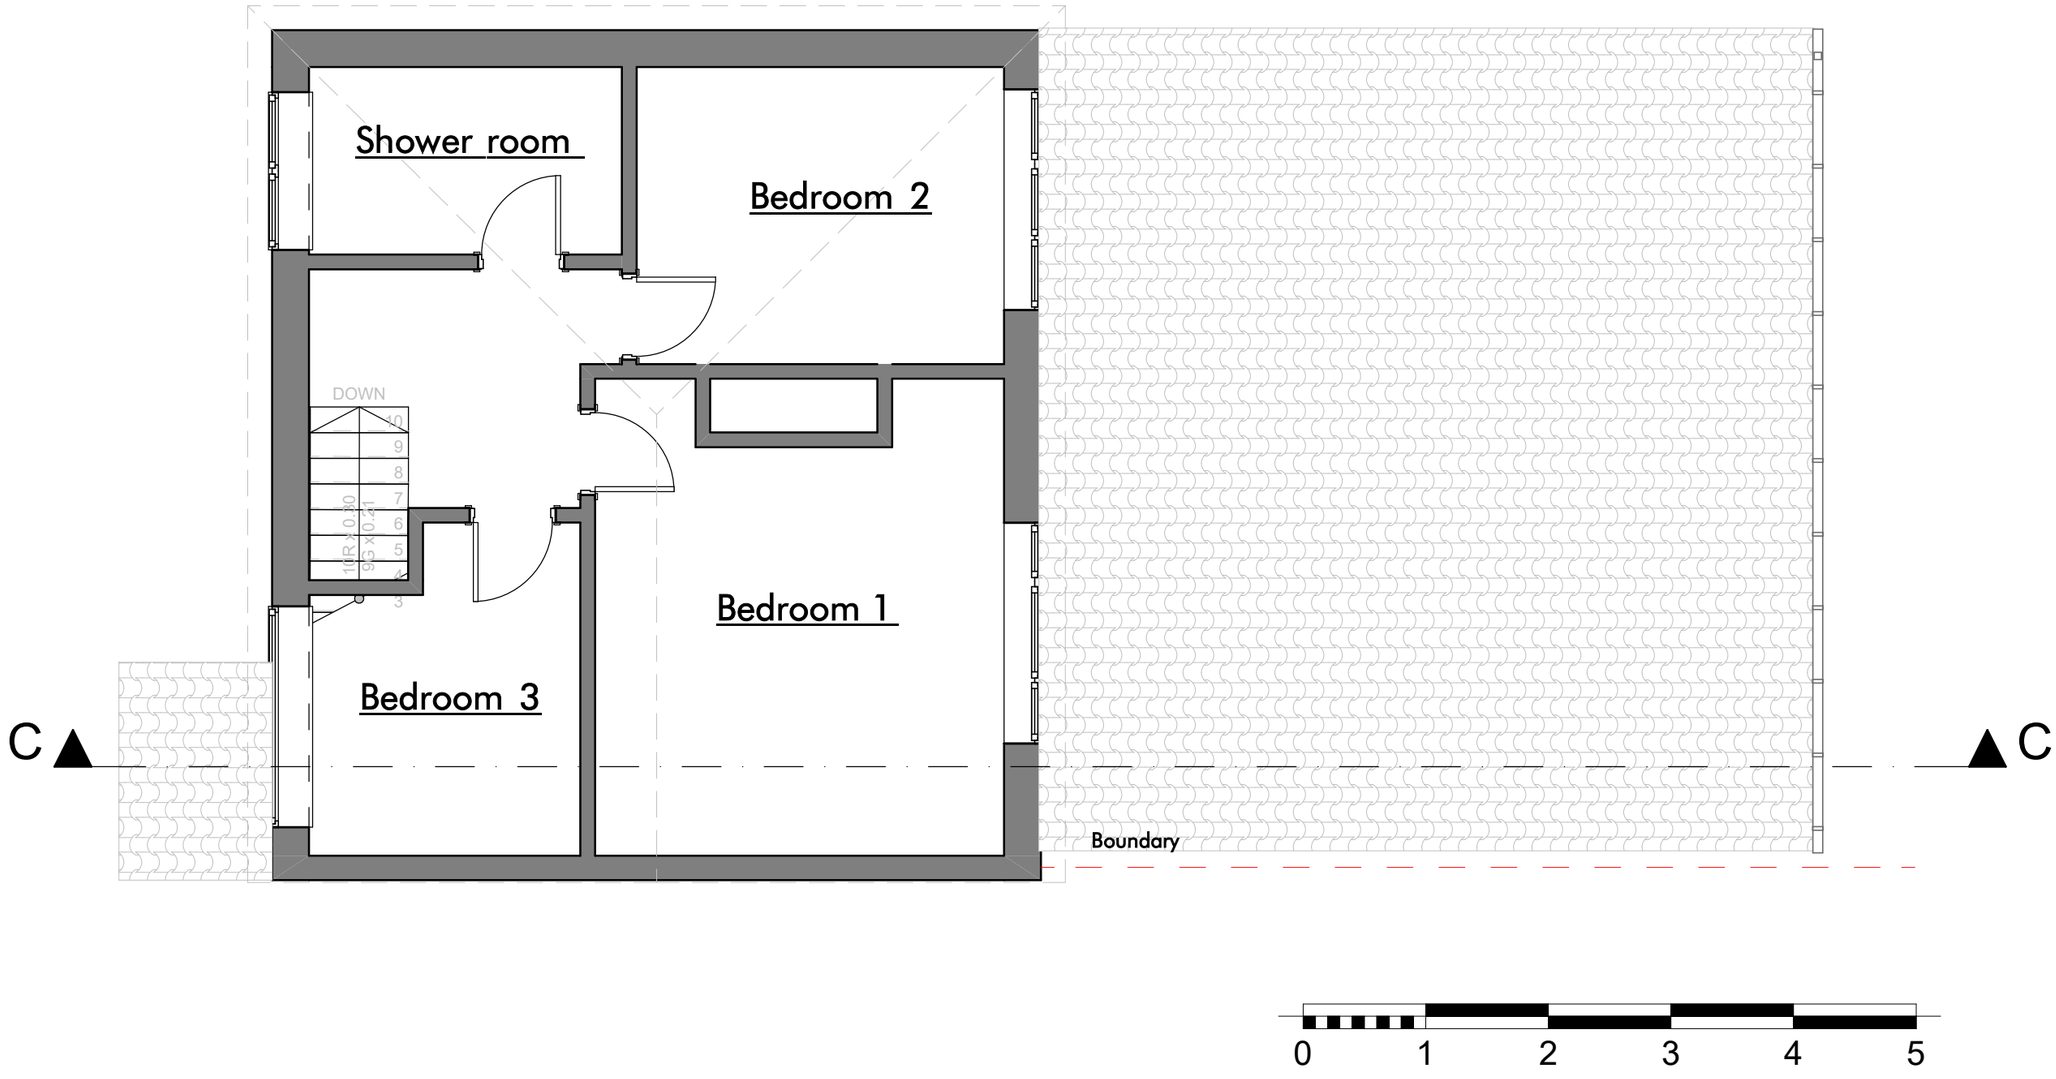

N

General Architectural Note

All drawings, dimensions, and specifications shown in these documents are provided as part of the architectural design intent. Contractors, consultants, and fabricators are responsible for verifying all dimensions and site conditions prior to commencing work. Any discrepancies between drawings, site conditions, or consultant information must be reported to the architect before proceeding.

Drawings are not to be scaled; only written dimensions are to be followed. Details indicated herein take precedence over general notes where conflicts may arise. Final construction shall comply with applicable building codes, regulations, and standards in force at the time of execution.

The contractor shall verify all existing site conditions, boundaries, and levels before commencing construction. Any discrepancies between drawings and actual site conditions must be reported already. The contractor is responsible for maintaining site safety, accessibility, and cleanliness throughout the construction process. All works must comply with local regulations, site access rules, and environmental protection requirements.

48 SOUTH CRESCENT EXTENSION DESIGN

Address

48 SOUTH CRESCENT, MANCHESTER

Document

Architectural drawings

Date

3/2/2026

Drawing

Proposed – Revised Scheme Upper Floor Plan

Scale

1:50

Layout


A.14

Contact

Karimiconstrution4@gmail.com

Revised to reflect as-built development and privacy/daylight amendments.



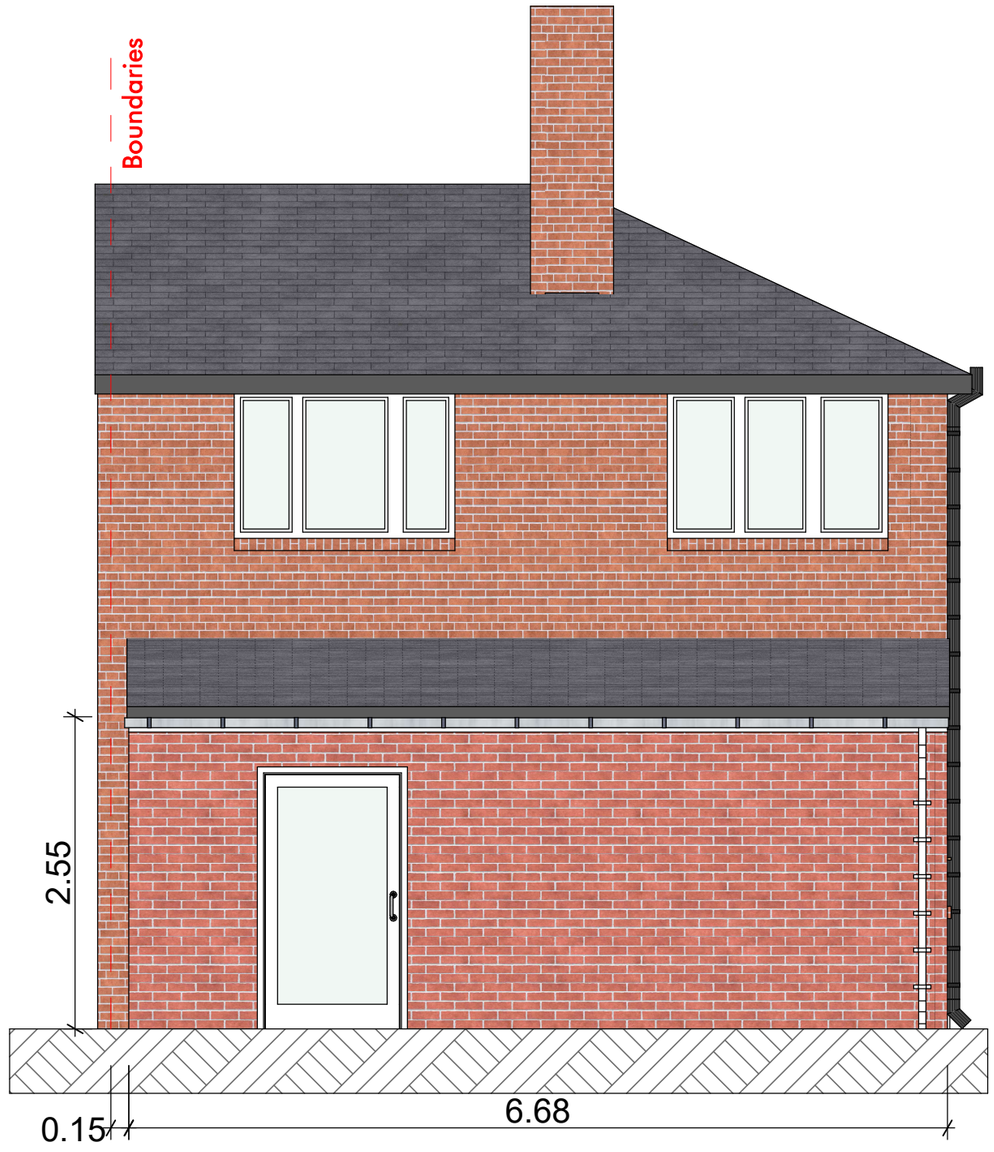

General Architectural Note

All drawings, dimensions, and specifications shown in these documents are provided as part of the architectural design intent. Contractors, consultants, and fabricators are responsible for verifying all dimensions and site conditions prior to commencing work. Any discrepancies between drawings, site conditions, or consultant information must be reported to the architect before proceeding.

Drawings are not to be scaled; only written dimensions are to be followed. Details indicated herein take precedence over general notes where conflicts may arise. Final construction shall comply with applicable building codes, regulations, and standards in force at the time of execution.

The contractor shall verify all existing site conditions, boundaries, and levels before commencing construction. Any discrepancies between drawings and actual site conditions must be reported already. The contractor is responsible for maintaining site safety, accessibility, and cleanliness throughout the construction process. All works must comply with local regulations, site access rules, and environmental protection requirements.

48 SOUTH CRESCENT EXTENSION DESIGN

Address

48 SOUTH CRESCENT, MANCHESTER

Document

Architectural drawings

Date

3/2/2026

Drawing

Proposed – Revised Scheme Front and Back Elevation

Scale

1:50

Layout

A.15

Contact

Karimiconstrution4@gmail.com

Revised to reflect as-built development and privacy/daylight amendments.



48 SOUTH CRESCENT EXTENSION DESIGN

General Architectural Note

All drawings, dimensions, and specifications shown in these documents are provided as part of the architectural design intent. Contractors, consultants, and fabricators are responsible for verifying all dimensions and site conditions prior to commencing work. Any discrepancies between drawings, site conditions, or consultant information must be reported to the architect before proceeding.

Drawings are not to be scaled; only written dimensions are to be followed. Details indicated herein take precedence over general notes where conflicts may arise. Final construction shall comply with applicable building codes, regulations, and standards in force at the time of execution.

The contractor shall verify all existing site conditions, boundaries, and levels before commencing construction. Any discrepancies between drawings and actual site conditions must be reported already. The contractor is responsible for maintaining site safety, accessibility, and cleanliness throughout the construction process. All works must comply with local regulations, site access rules, and environmental protection requirements.

Address
48 SOUTH CRESCENT, MANCHESTER

Document
Architectural drawings

Date
3/2/2026


Drawing
Proposed – Revised Scheme Side elevation 1

Scale
1:50

Layout
A.16

Contact
Karimiconstrution4@gmail.com

Revised to reflect as-built development and privacy/daylight amendments.

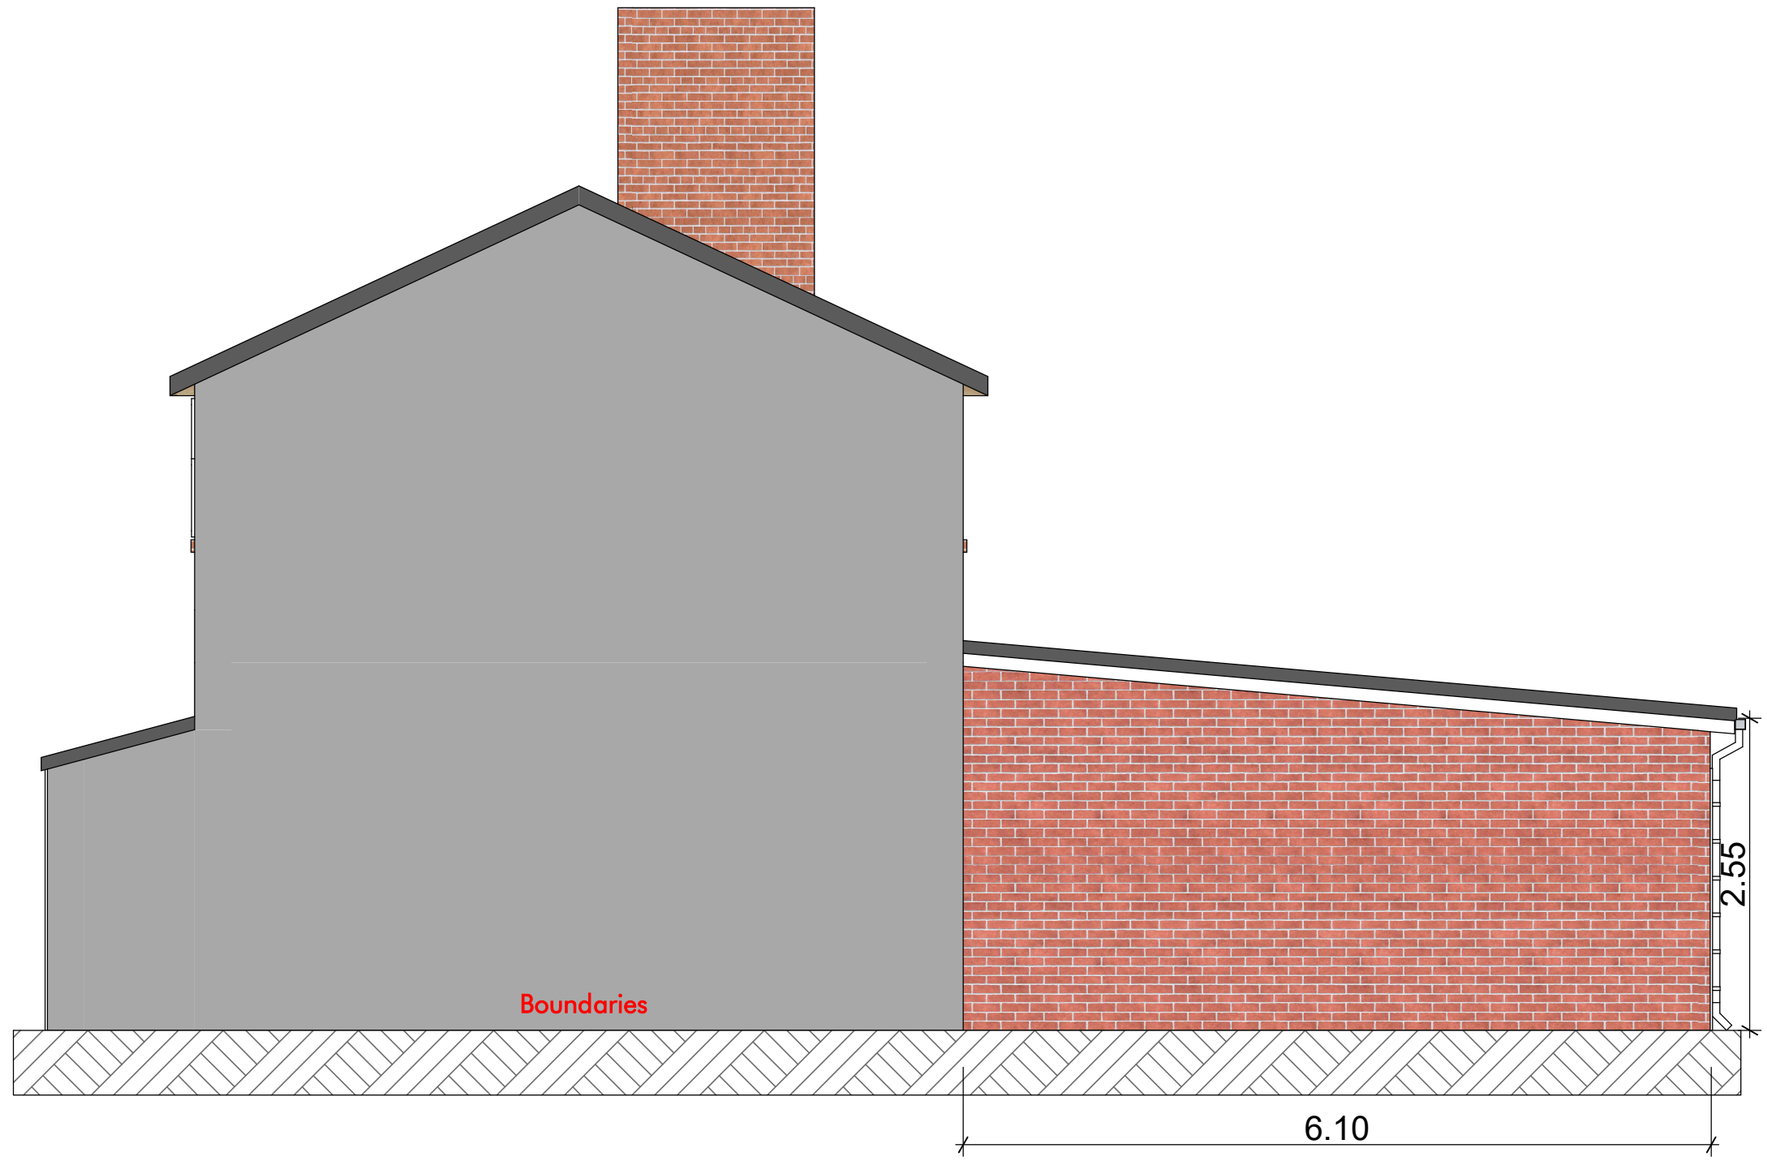

48 SOUTH CRESCENT
EXTENSION DESIGN

General Architectural Note

All drawings, dimensions, and specifications shown in these documents are provided as part of the architectural design intent. Contractors, consultants, and fabricators are responsible for verifying all dimensions and site conditions prior to commencing work. Any discrepancies between drawings, site conditions, or consultant information must be reported to the architect before proceeding.

Drawings are not to be scaled; only written dimensions are to be followed. Details indicated herein take precedence over general notes where conflicts may arise. Final construction shall comply with applicable building codes, regulations, and standards in force at the time of execution.

The contractor shall verify all existing site conditions, boundaries, and levels before commencing construction. Any discrepancies between drawings and actual site conditions must be reported already. The contractor is responsible for maintaining site safety, accessibility, and cleanliness throughout the construction process. All works must comply with local regulations, site access rules, and environmental protection requirements.

Address
48 SOUTH CRESCENT, MANCHESTER

Document
Architectural drawings

Date
3/2/2026


Drawing
Proposed – Revised Scheme Side Elevation 2

Scale
1:50

Layout
A.17

Contact
Karimiconstrution4@gmail.com

Revised to reflect as-built development and privacy/daylight amendments.

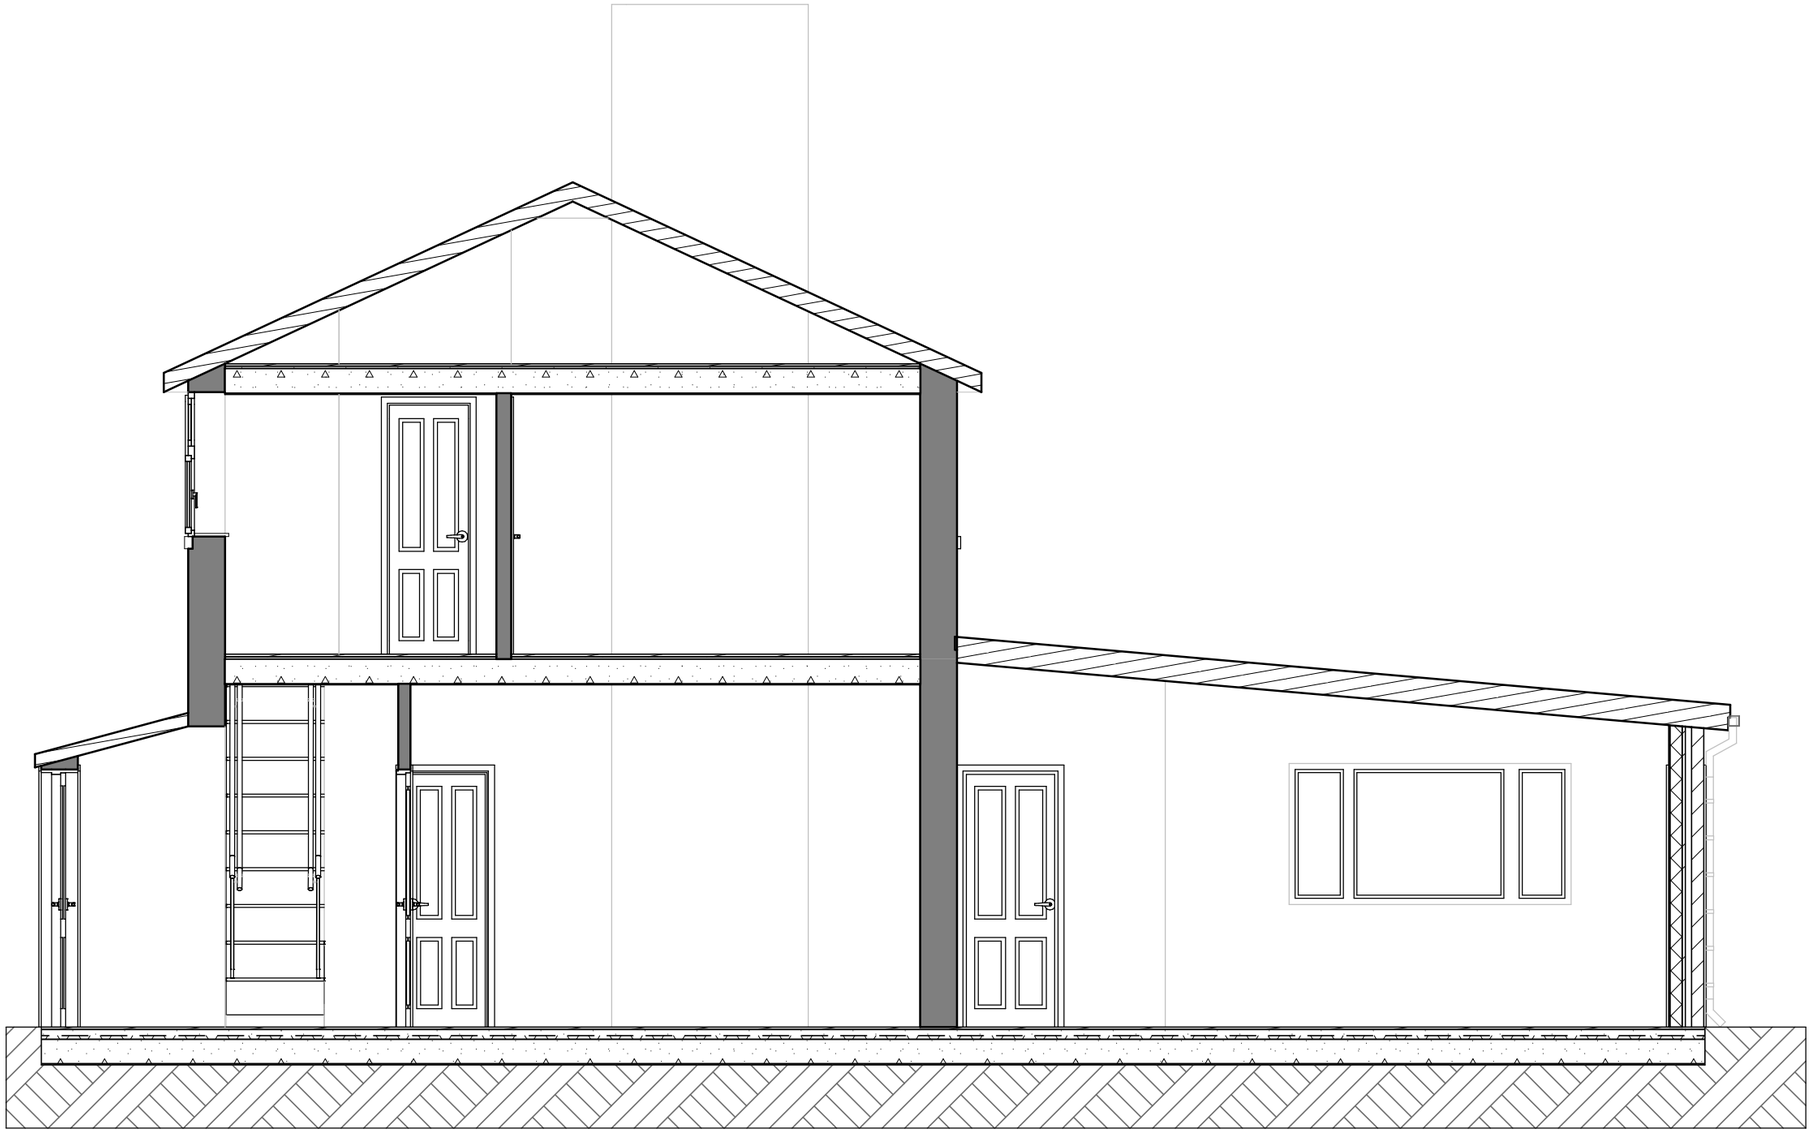

48 SOUTH CRESCENT
EXTENSION DESIGN

General Architectural Note

All drawings, dimensions, and specifications shown in these documents are provided as part of the architectural design intent. Contractors, consultants, and fabricators are responsible for verifying all dimensions and site conditions prior to commencing work. Any discrepancies between drawings, site conditions, or consultant information must be reported to the architect before proceeding.

Drawings are not to be scaled; only written dimensions are to be followed. Details indicated herein take precedence over general notes where conflicts may arise. Final construction shall comply with applicable building codes, regulations, and standards in force at the time of execution.

The contractor shall verify all existing site conditions, boundaries, and levels before commencing construction. Any discrepancies between drawings and actual site conditions must be reported already. The contractor is responsible for maintaining site safety, accessibility, and cleanliness throughout the construction process. All works must comply with local regulations, site access rules, and environmental protection requirements.

Address
48 SOUTH CRESCENT, MANCHESTER

Document
Architectural drawings


Date
3/2/2026

Drawing
Proposed – Revised Scheme Section CC


Scale
1:50

Layout
A.18

Contact
Karimiconstrution4@gmail.com

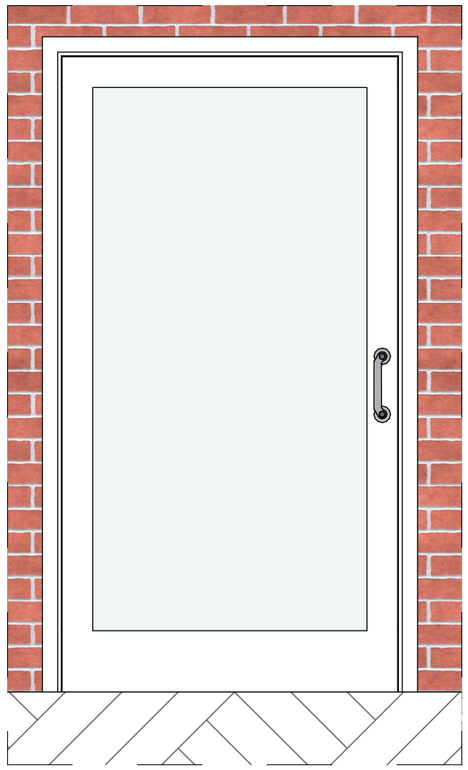

External Door: Upgraded from a solid panel to a single-glazed configuration to improve internal daylight levels.

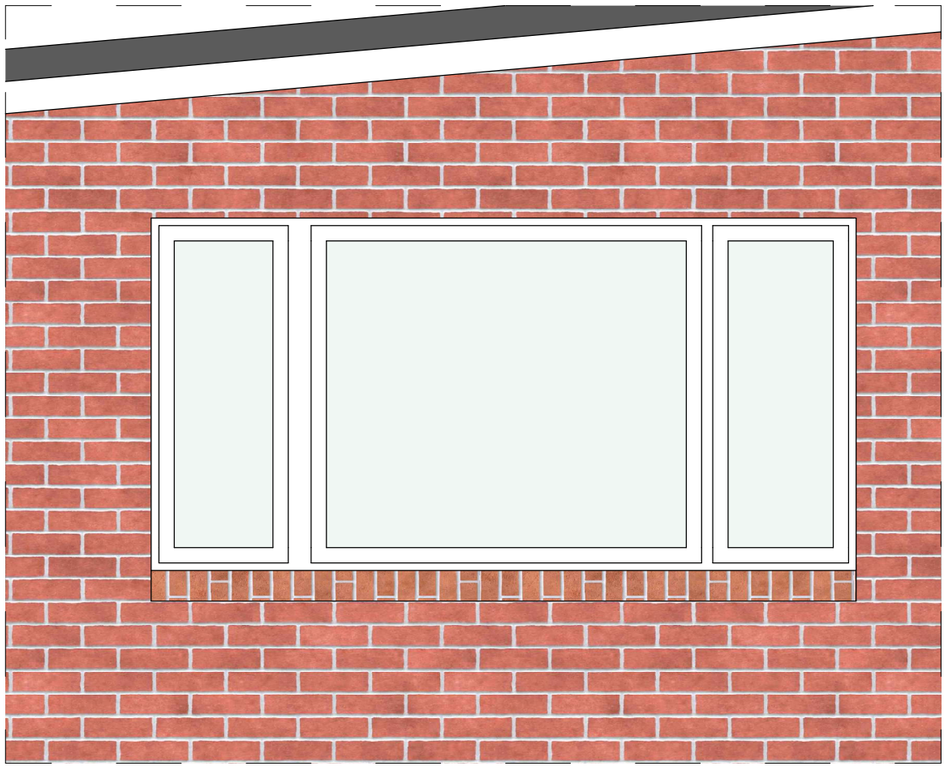

Proposed Window

48 SOUTH CRESCENT
EXTENSION DESIGN

General Architectural Note

All drawings, dimensions, and specifications shown in these documents are provided as part of the architectural design intent. Contractors, consultants, and fabricators are responsible for verifying all dimensions and site conditions prior to commencing work. Any discrepancies between drawings, site conditions, or consultant information must be reported to the architect before proceeding.

Drawings are not to be scaled; only written dimensions are to be followed. Details indicated herein take precedence over general notes where conflicts may arise. Final construction shall comply with applicable building codes, regulations, and standards in force at the time of execution.

The contractor shall verify all existing site conditions, boundaries, and levels before commencing construction. Any discrepancies between drawings and actual site conditions must be reported already. The contractor is responsible for maintaining site safety, accessibility, and cleanliness throughout the construction process. All works must comply with local regulations, site access rules, and environmental protection requirements.

Address
48 SOUTH CRESCENT, MANCHESTER

Document
Architectural drawings

Date
3/2/2026

Drawing
Proposed – Revised Scheme amended openings details

Scale
1:20

Layout
A.19

Contact
Karimiconstrution4@gmail.com