
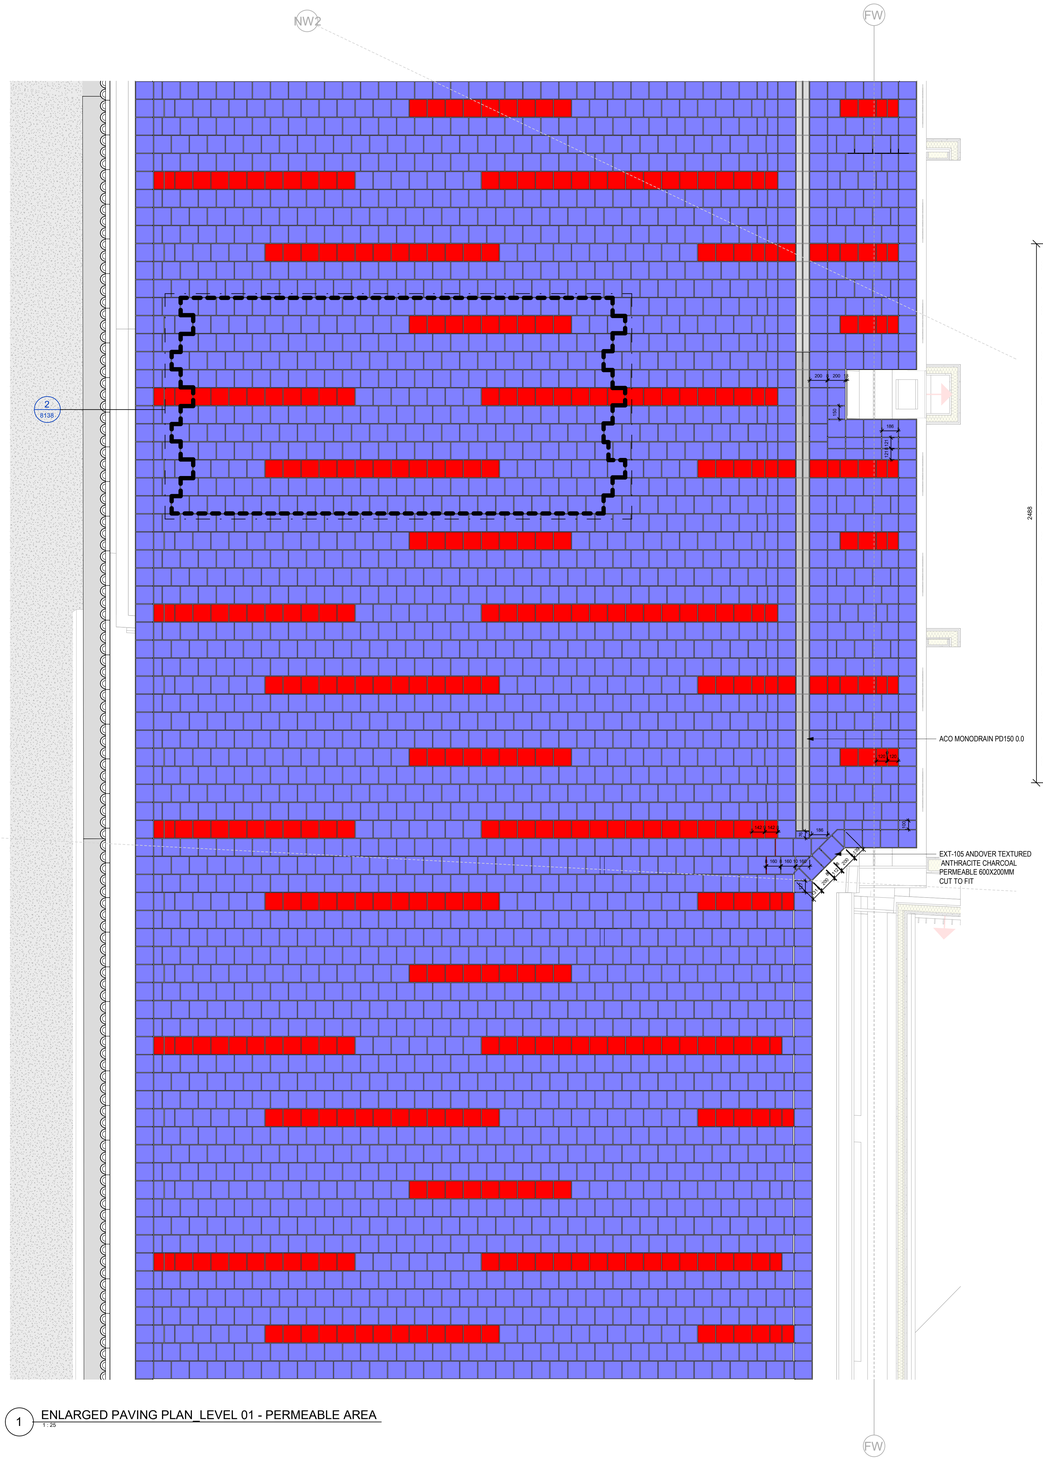


1 ENLARGED PAVING PLAN_LEVEL 01 - PERMEABLE AREA
1 : 25

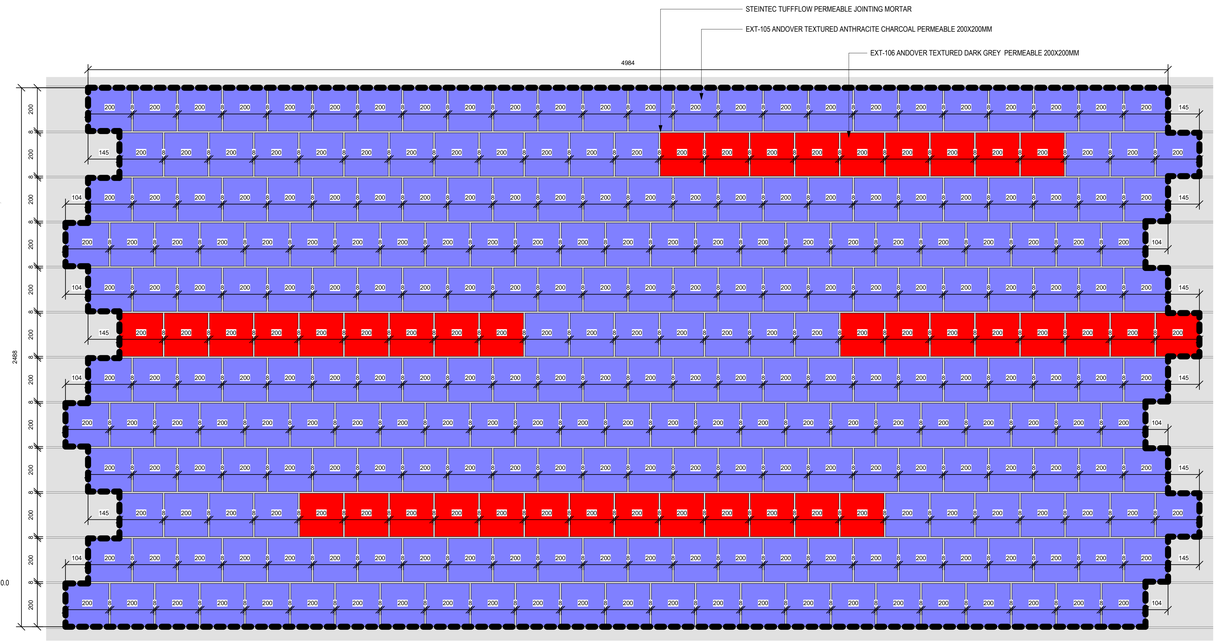

2 PAVING MODULE_PERMEABLE
1 : 10

Suitability Code (as defined in ISO 19650-2:2018)

Work in Progress (WIP)
S0 - Initial Status

Shared (Non- Contractual)
S1 - Suitable for co-ordination
S2 - Suitable for information
S3 - Suitable for review & comment
S4 - Suitable for stage approval
S5 - Withdrawn
S6 - Suitable for PIM authorisation
S7 - Suitable for AIM authorisation

Published (Contractual)
A1, A2, A3, Etc - Authorised and accepted
B1,B2,B3, Etc. - Partial sign-off (with comments)

Published (AIM Acceptance)
CR - As constructed record document

KEY PLAN

KEY

EXT-105 ANDOVER TEXTURED ANTHRACITE CHARCOAL PERMEABLE 200X200MM

EXT-106 ANDOVER TEXTURED DARK GREY PERMEABLE 200X200MM

NOTES:

1. PAVING MODULE TO BE STRICTLY FOLLOWED TO ACHIEVE THE REQUIRED PAVING DESIGN.

2. NO PAVER TO BE CUT BEYOND 1/3 OF ITS SIZE (LENGTH OR WIDTH) ENLARGED PAVING IS TO BE USED.

3. ALL PERMEABLE PAVING MUST USE 8MM STEINTEC TUFFFLOW PERMEABLE JOINTING MORTAR.

4. LONG CONTINUOUS JOINTS PERPENDICULAR TO PATH DIRECTION.

DRAWING REPRESENTS A RECORD OF THE LAST CONSTRUCTION DESIGN AT DATE STATED. AND IS NOT AN AS-BUILT DRAWING. INFORMATION SHOULD BE READ IN CONJUNCTION WITH ALL SUB-CONTRACTOR 'AS-BUILT' INFORMATION. THERE MIGHT HAVE BEEN CHANGES THE DESIGN TEAM WAS NOT INFORMED ABOUT. THEREFORE SITE SURVEYS ARE RECOMMENDED TO ESTABLISH AS-BUILT CONDITIONS.

client

OVG INTERNATIONAL

© COPYRIGHT. ALL RIGHTS RESERVED

THIS WORK IS COPYRIGHT AND CANNOT BE REPRODUCED OR COPIED IN ANY FORM OR BY ANY OTHER MEANS (GRAPHIC, ELECTRONIC OR MECHANICAL INCLUDING PHOTOCOPYING) WITHOUT THE WRITTEN PERMISSION OF POPULOUS. ANY LICENSE, EXPRESS OR IMPLIED, TO USE THIS DOCUMENT FOR ANY PURPOSE WHATSOEVER IS RESTRICTED BY THE TERMS OF THE AGREEMENT OR IMPLIED AGREEMENT BETWEEN POPULOUS AND THE INSTRUCTING PARTY.

USE FIGURED DIMENSIONS IN PREFERENCE TO SCALED. CHECK ALL DIMENSIONS ON SITE BEFORE FABRICATION OR SETTING OUT

architect

POPULOUS®

14 BLADES COURT | DEODAR ROAD | LONDON | SW15 2NU | UNITED KINGDOM
TELEPHONE +44 (0)20 8874 7666 FACSIMILE +44 (0)20 8874 7470
ALL PRODUCTION & INTELLECTUAL PROPERTY RIGHTS RESERVED © POPULOUS 2009

REVISIONS

REV	DATE	DESCRIPTION
C01	24.10.2023	ISSUED FOR CONSTRUCTION
C02	19.01.2024	LANDSCAPE UPDATE SUBJECT TO DCR #0155
CR01	12.04.2024	CONSTRUCTION RECORD

project name **Co-op Live**

title LANDSCAPE
PAVING PATTERN
PERMEABLE AREA

purpose of issue **CONSTRUCTION RECORD**

scale As indicated @ A0 drawn SA Project no. 4933 Suitability **CR**

date 23/10/23 checked TJ

reference **BRA-POP-ZZ-01-DR-L-8138** rev. **CR01**

project code originator volume level type role number