


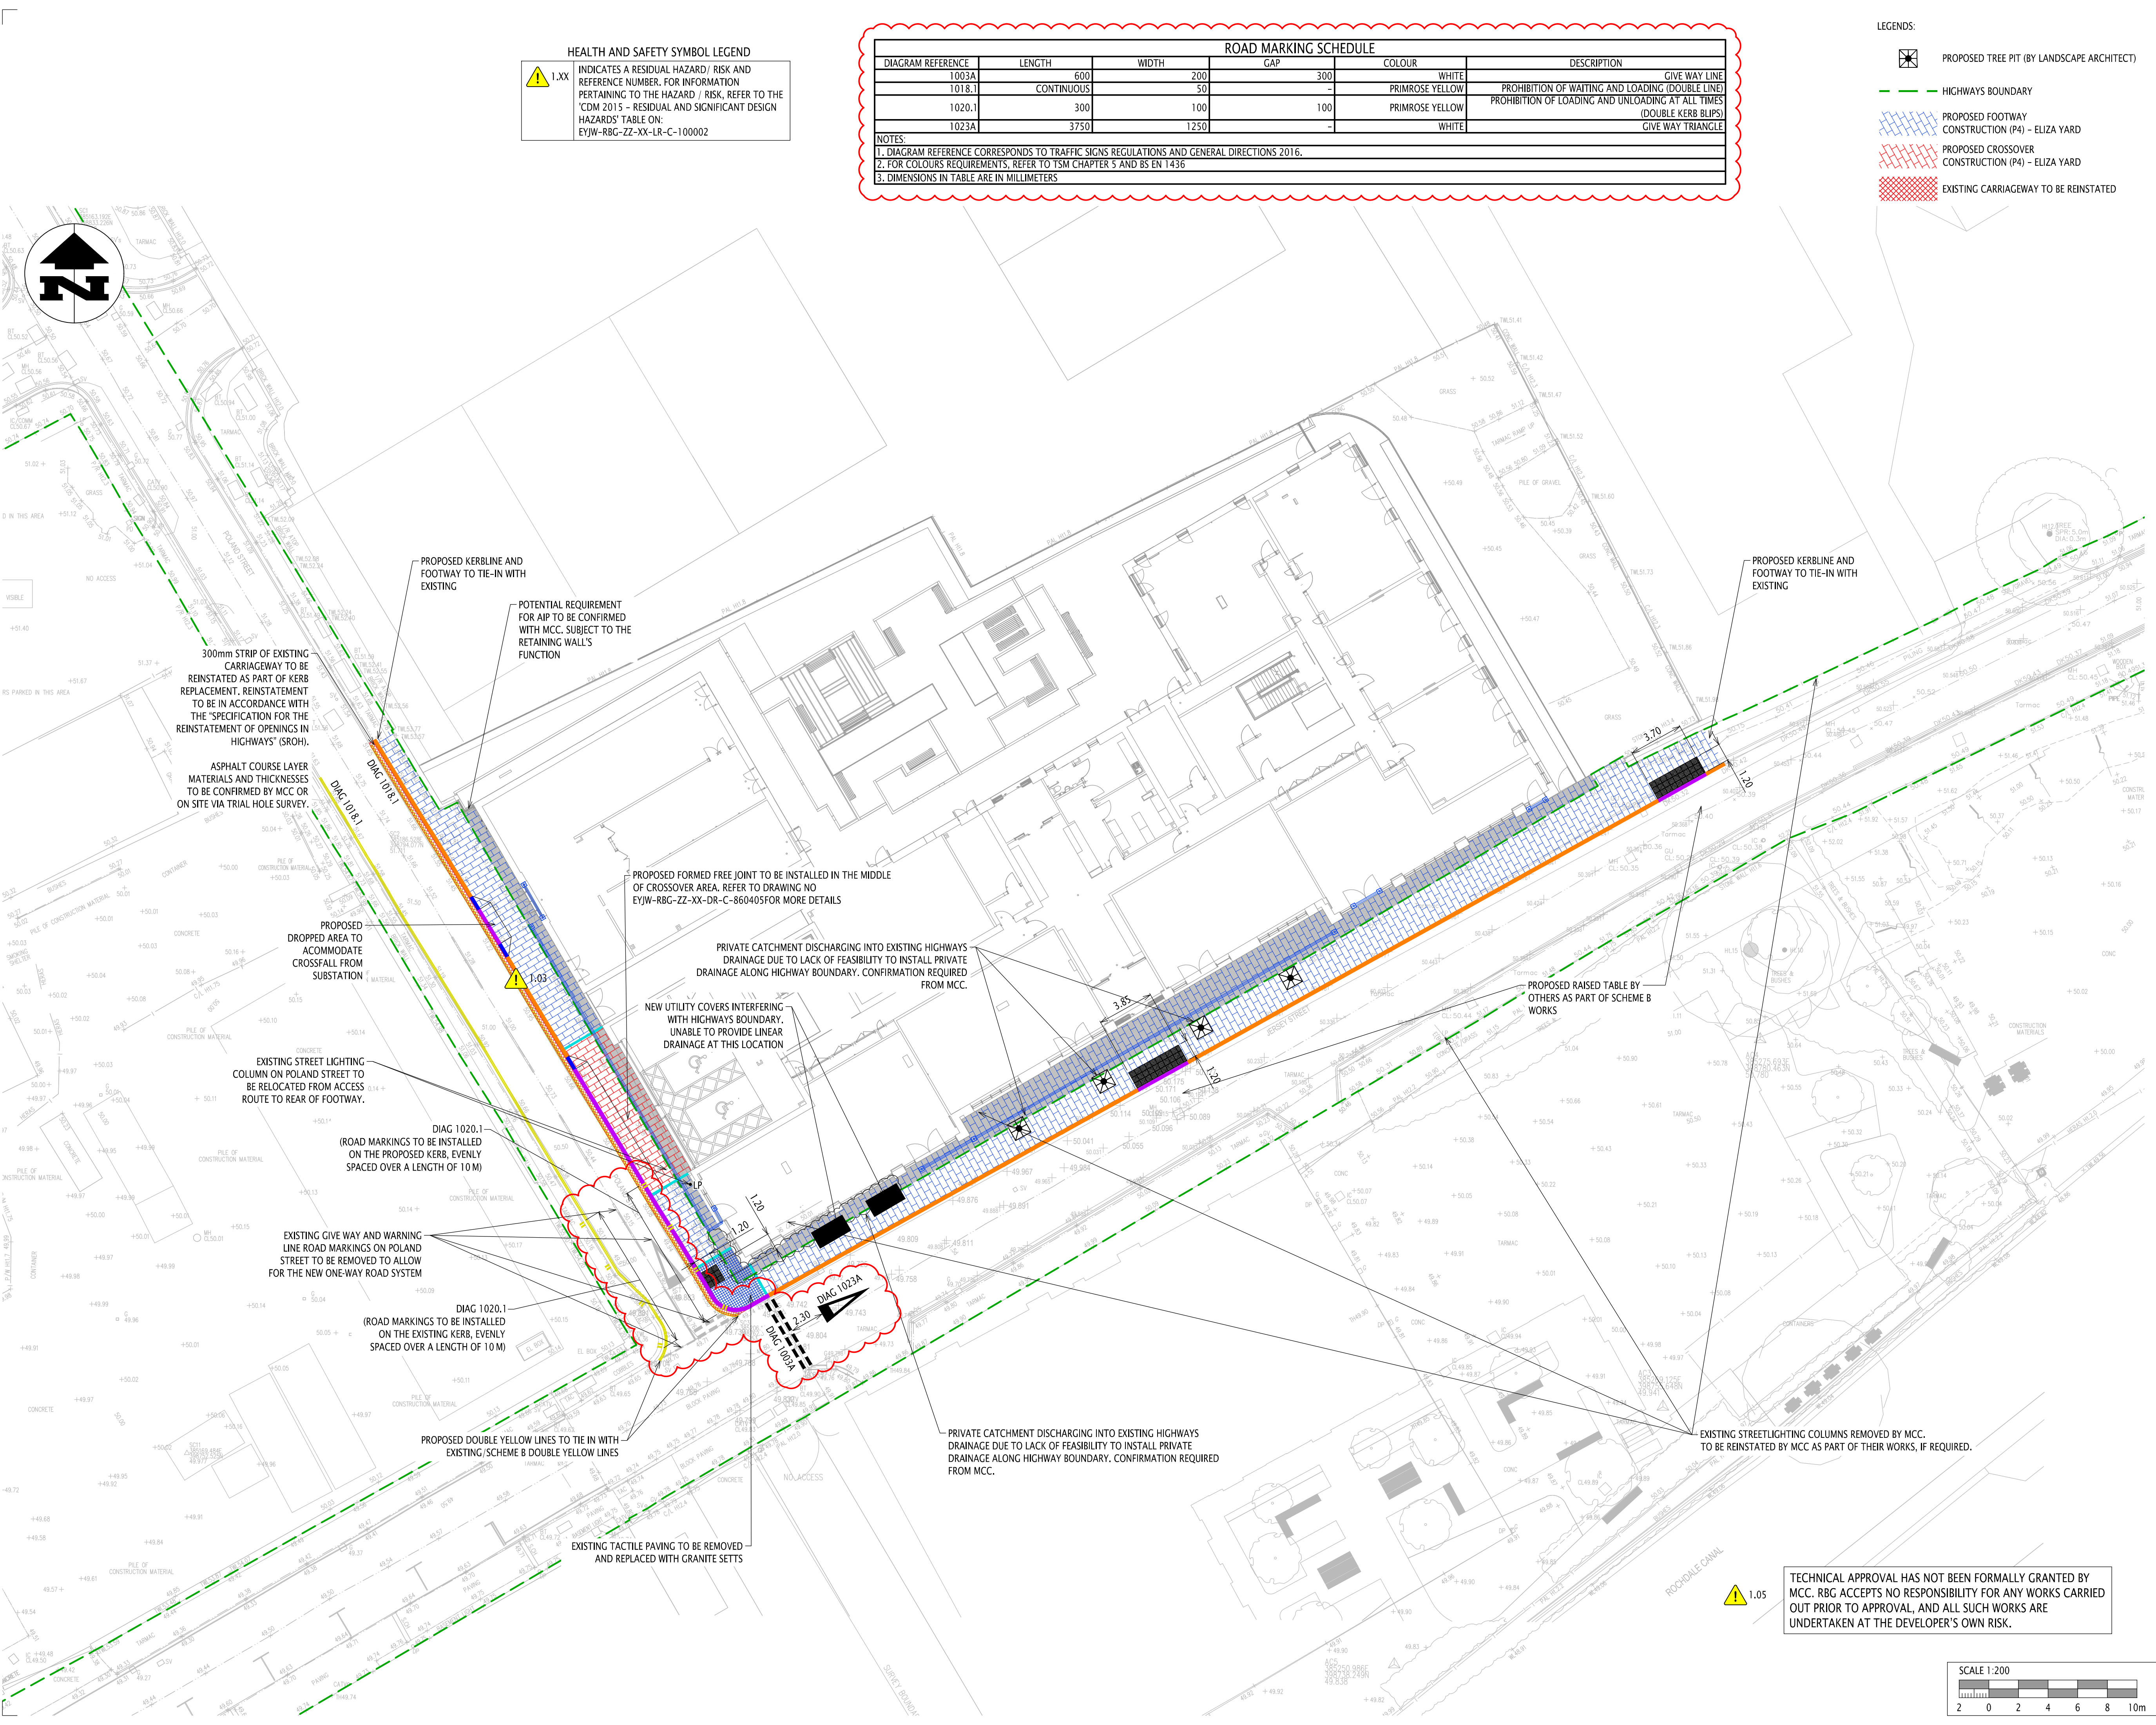

HEALTH AND SAFETY SYMBOL LEGEND

1.XX INDICATES A RESIDUAL HAZARD/ RISK AND REFERENCE NUMBER. FOR INFORMATION PERTAINING TO THE HAZARD / RISK, REFER TO THE 'CDM 2015 - RESIDUAL AND SIGNIFICANT DESIGN HAZARDS' TABLE ON: EYJW-RBG-ZZ-XX-LR-C-100002

ROAD MARKING SCHEDULE						
DIAGRAM REFERENCE	LENGTH	WIDTH	GAP	COLOUR	DESCRIPTION	
1003A	600	200	300	WHITE	GIVE WAY LINE	
1018.1	CONTINUOUS	50	-	PRIMROSE YELLOW	PROHIBITION OF WAITING AND LOADING (DOUBLE LINE)	
1020.1	300	100	100	PRIMROSE YELLOW	PROHIBITION OF LOADING AND UNLOADING AT ALL TIMES (DOUBLE KERB BLIPS)	
1023A	3750	1250	-	WHITE	GIVE WAY TRIANGLE	
NOTES:						
1. DIAGRAM REFERENCE CORRESPONDS TO TRAFFIC SIGNS REGULATIONS AND GENERAL DIRECTIONS 2016.						
2. FOR COLOURS REQUIREMENTS, REFER TO TSM CHAPTER 5 AND BS EN 1436						
3. DIMENSIONS IN TABLE ARE IN MILLIMETERS						

LEGENDS:

- PROPOSED TREE PIT (BY LANDSCAPE ARCHITECT)
- HIGHWAYS BOUNDARY
- PROPOSED FOOTWAY CONSTRUCTION (P4) - ELIZA YARD
- PROPOSED CROSSOVER CONSTRUCTION (P4) - ELIZA YARD
- EXISTING CARRIAGEWAY TO BE REINSTATED
- PRIVATE AREA
- GRANITE SETTS CONSTRUCTION (P5)
- PROPOSED PRECAST CONCRETE TACTILE PAVING FOR UNCONTROLLED CROSSING (BLISTER SURFACE) (P7)
- PROPOSED PRIVATE LINEAR DRAINAGE
- PROPOSED KERB TYPE E5 (60mm UPSTAND)
- PROPOSED KERB E5 (DROPPED) / FLUSH KERB WITH 6mm UPSTAND
- PROPOSED TRANSITION KERB (UPSTAND TO VARY FROM 60mm TO 6mm) TO BE INSTALLED BY SLIGHTLY ROTATION OF KERB E5
- PROPOSED EDGING KERB E6
- PROPOSED ROAD MARKINGS

- NOTES:
- ALL DIMENSIONS ARE IN METERS UNLESS STATED OTHERWISE.
 - DO NOT SCALE FROM THIS DRAWING.
 - EXISTING TOPOGRAPHICAL INFORMATION IS BASED UPON THE FOLLOWING DRAWINGS:
 - WARNER SURVEYS DRAWING NO: BT/223/0029/P/0001 REV 0 RECEIVED 06/12/23
 - LEVELS SURVEY SHOWN ON DRAWING "LANDSCAPE WITH JERSEY STREET AS BUILT.DWG" PROVIDED BY SISK ON 20/06/25
 - ROAD SURVEY 106 PROVIDED BY SISK ON 30/06/25
 - THE DESIGN SHOWN IN THIS DRAWING IS SUBJECT TO MANCHESTER CITY COUNCIL (MCC) APPROVAL.
 - PROPOSED LINEAR DRAINAGE AS PER DISCUSSIONS WITH MCC HIGHWAYS ON 29/07/25.
 - PROPOSED BLISTER PAVING AT CROSSING POINTS AS PART OF MCC PLANNED WORKS ALONG JERSEY STREET.
 - DRAWING TO BE READ IN CONJUNCTION WITH ALL SCHEME A S278 DRAWINGS. FULL DRAWING LIST IS SHOWN BELOW:
 - EYJW-RBG-XX-00-DR-C-800201 GENERAL ARRANGEMENT
 - EYJW-RBG-XX-00-DR-C-810201 SITE CLEARANCE PLAN
 - EYJW-RBG-XX-00-DR-C-830201 S278 REDLINE BOUNDARY
 - EYJW-RBG-XX-00-DR-C-830202 CONTOURS PLAN
 - EYJW-RBG-XX-00-DR-C-890201 EXISTING UTILITIES PLAN
 - EYJW-RBG-ZZ-XX-DR-C-860405 PAVEMENT DETAILS
 - EYJW-GIL-EX-00-DR-L-000411 TREE PIT IN HARD LANDSCAPE
 - TRAFFIC REGULATION ORDER (TRO) REQUIRED FOR PROPOSED DOUBLE YELLOW LINES FOLLOWING TRANSPORT STATEMENT 16451-HYO-XX-XX-RP-TP-4001-P3 BY HYDROCK. MCC TO CONFIRM TRO REQUIREMENTS.
 - ALL EXISTING UTILITY COVERS TO BE RETAINED, LEVEL TO BE REDUCED IF REQUIRED, AND AGREED WITH UTILITY PROVIDER.

C03 REVISED AS PER ROAD MARKING UPDATES	KK	CI	24/03/26
C02 REVISED TO INCORPORATE S278 UPDATES	CS	CI	16/03/26
C01 ISSUED FOR CONSTRUCTION	BS	AT	05/12/25

Rev. Revision Description By App Date

Disclaimer: Robert Bird Group Pty Ltd ACN 010 580 248 and its related entities (RBG) do not warrant the accuracy, currency or completeness of any information or data they supply or transfer by electronic means. You are responsible for verifying that any information or data supplied or transferred by electronic means matches the information or data on the corresponding PDF or DWG version issued by RBG. RBG will not be liable for any loss or damage you or any other party incur as a result of acting in reliance on any information or data supplied or transferred by electronic means and you release RBG from any liability for any loss or damage however caused which you or any other party may directly or indirectly suffer in connection with your access to or use of that information or data.

RBG provides this information for the express purpose contemplated by the underlying terms of engagement for the project which must not be used for any other purpose. The information is not a contractual document. Unless otherwise agreed in writing by RBG, all intellectual property rights in any information supplied by RBG are owned by, or licensed to, RBG. RBG only provides you with a non-transferable, fully revocable licence to use the intellectual property rights for the express purpose.

DO NOT SCALE DRAWINGS, USE FIGURED DIMENSIONS
REFER TO GENERAL NOTES UNLESS NOTED OTHERWISE

Structural, Civil & Construction
Engineering Consultant

RobertBirdGroup
an company

LONDON OFFICE
Robert Bird & Partners Limited
Level 1, Harling House
47-51 Great Suffolk Street
Southwark
London SE1 0BS, ENGLAND

Ph: +44 (0) 20 7633 2880
Email: enquiries@robertbird.com
Web: www.robertbird.com
UK Co: #447 2743

Client
JOHN SISK & SON LIMITED

Project
ELIZA YARD AND JERSEY WHARF
BLOCK C

Title
SECTION 278 - SCHEME A
GENERAL ARRANGEMENT

Date 07/25	Drawn B.SMITH
Scale at A1 1:200	Designer K.CHAG
Suitability Code A5	Design Checker A.TOTH
Job Number 5241	Approved G.JRVINE

For Construction	
Drawing Number	Revision
EYJW-RBG-XX-00-DR-C-800201	C03

TECHNICAL APPROVAL HAS NOT BEEN FORMALLY GRANTED BY MCC. RBG ACCEPTS NO RESPONSIBILITY FOR ANY WORKS CARRIED OUT PRIOR TO APPROVAL, AND ALL SUCH WORKS ARE UNDERTAKEN AT THE DEVELOPER'S OWN RISK.

