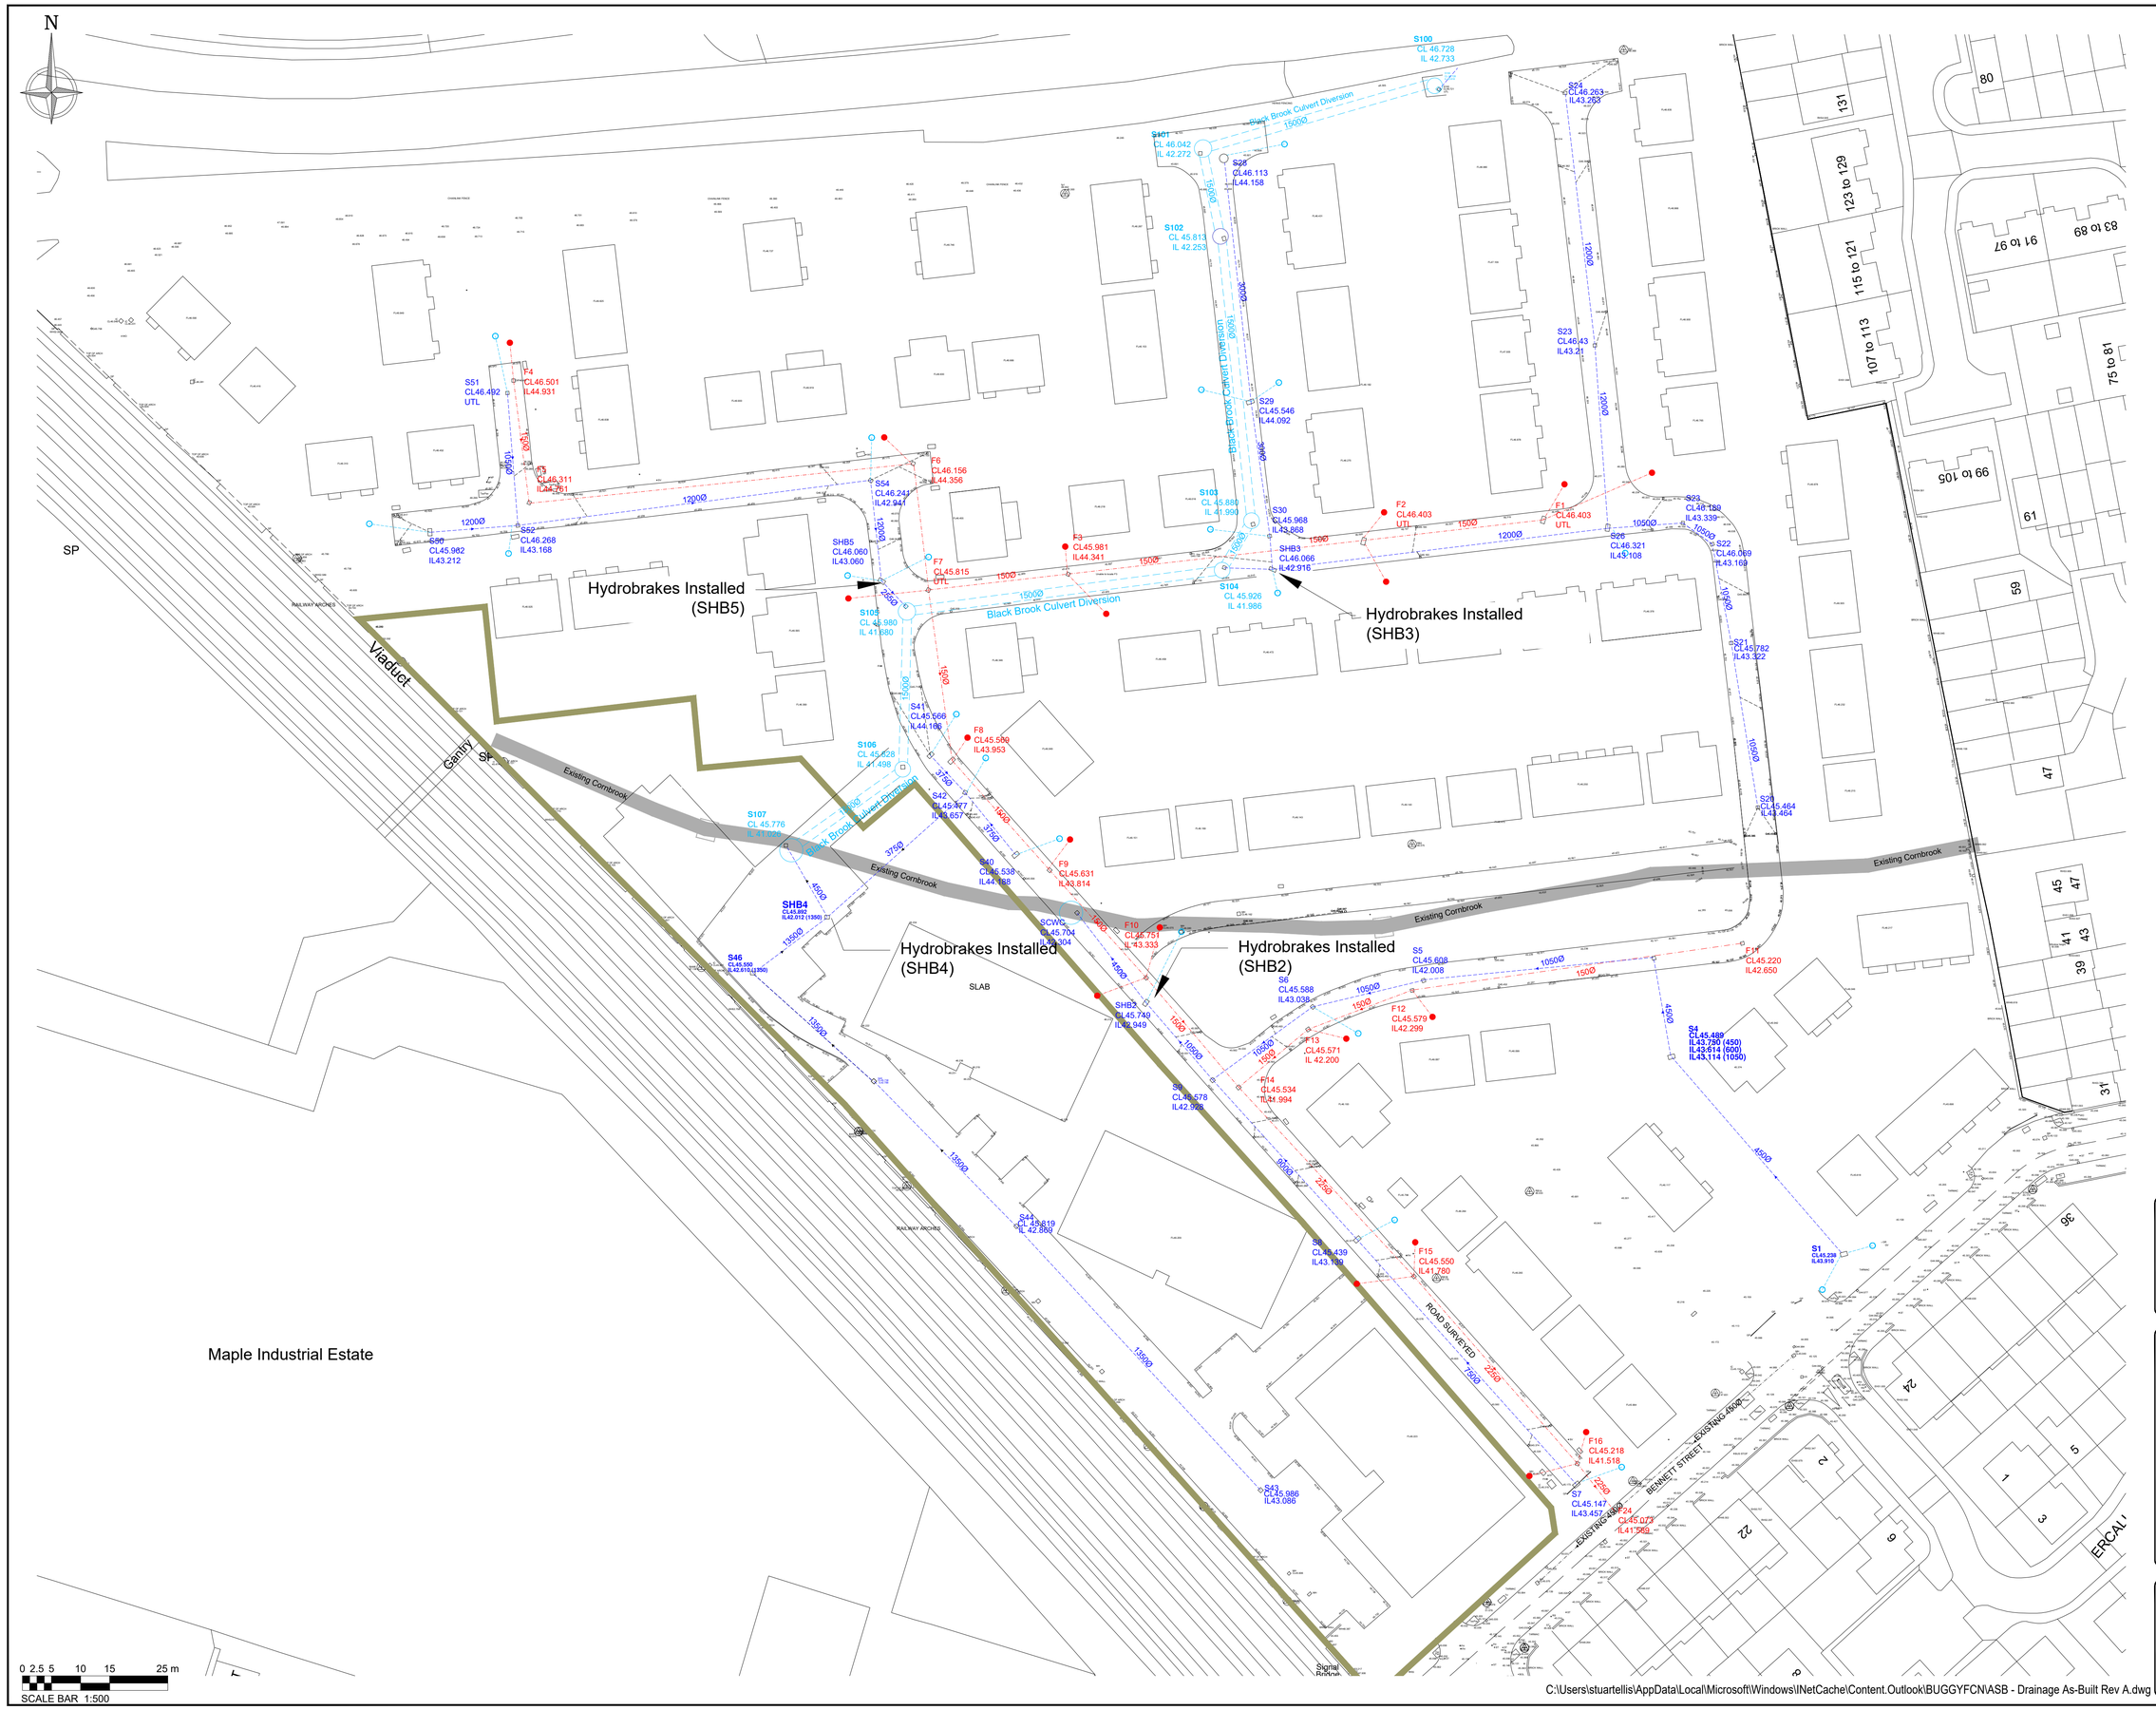

C:\Users\stuartellis\AppData\Local\Microsoft\Windows\INetCache\Content.Outlook\BUGGYFCN\ASB - Drainage As-Built Rev A.dwg

Revision	Date	Amendment	Initials
-	-	-	-

Development
Bennett Street

Location
Manchester

Marketing Name
-

Drawing Title
Drainage As-Built

Job No.	Drawing No.
006	**77**
Revision	Scale @ A1
A	1:500
Drawn By	Date
SE	7/7/2025
Checked by	Date Checked
-	-

1st Floor, 103 Dalton Avenue, Birchwood Park, Warrington WA3 6YE
T: 01925 363108 W: www.kellenhomes.com
KELLEN HOMES