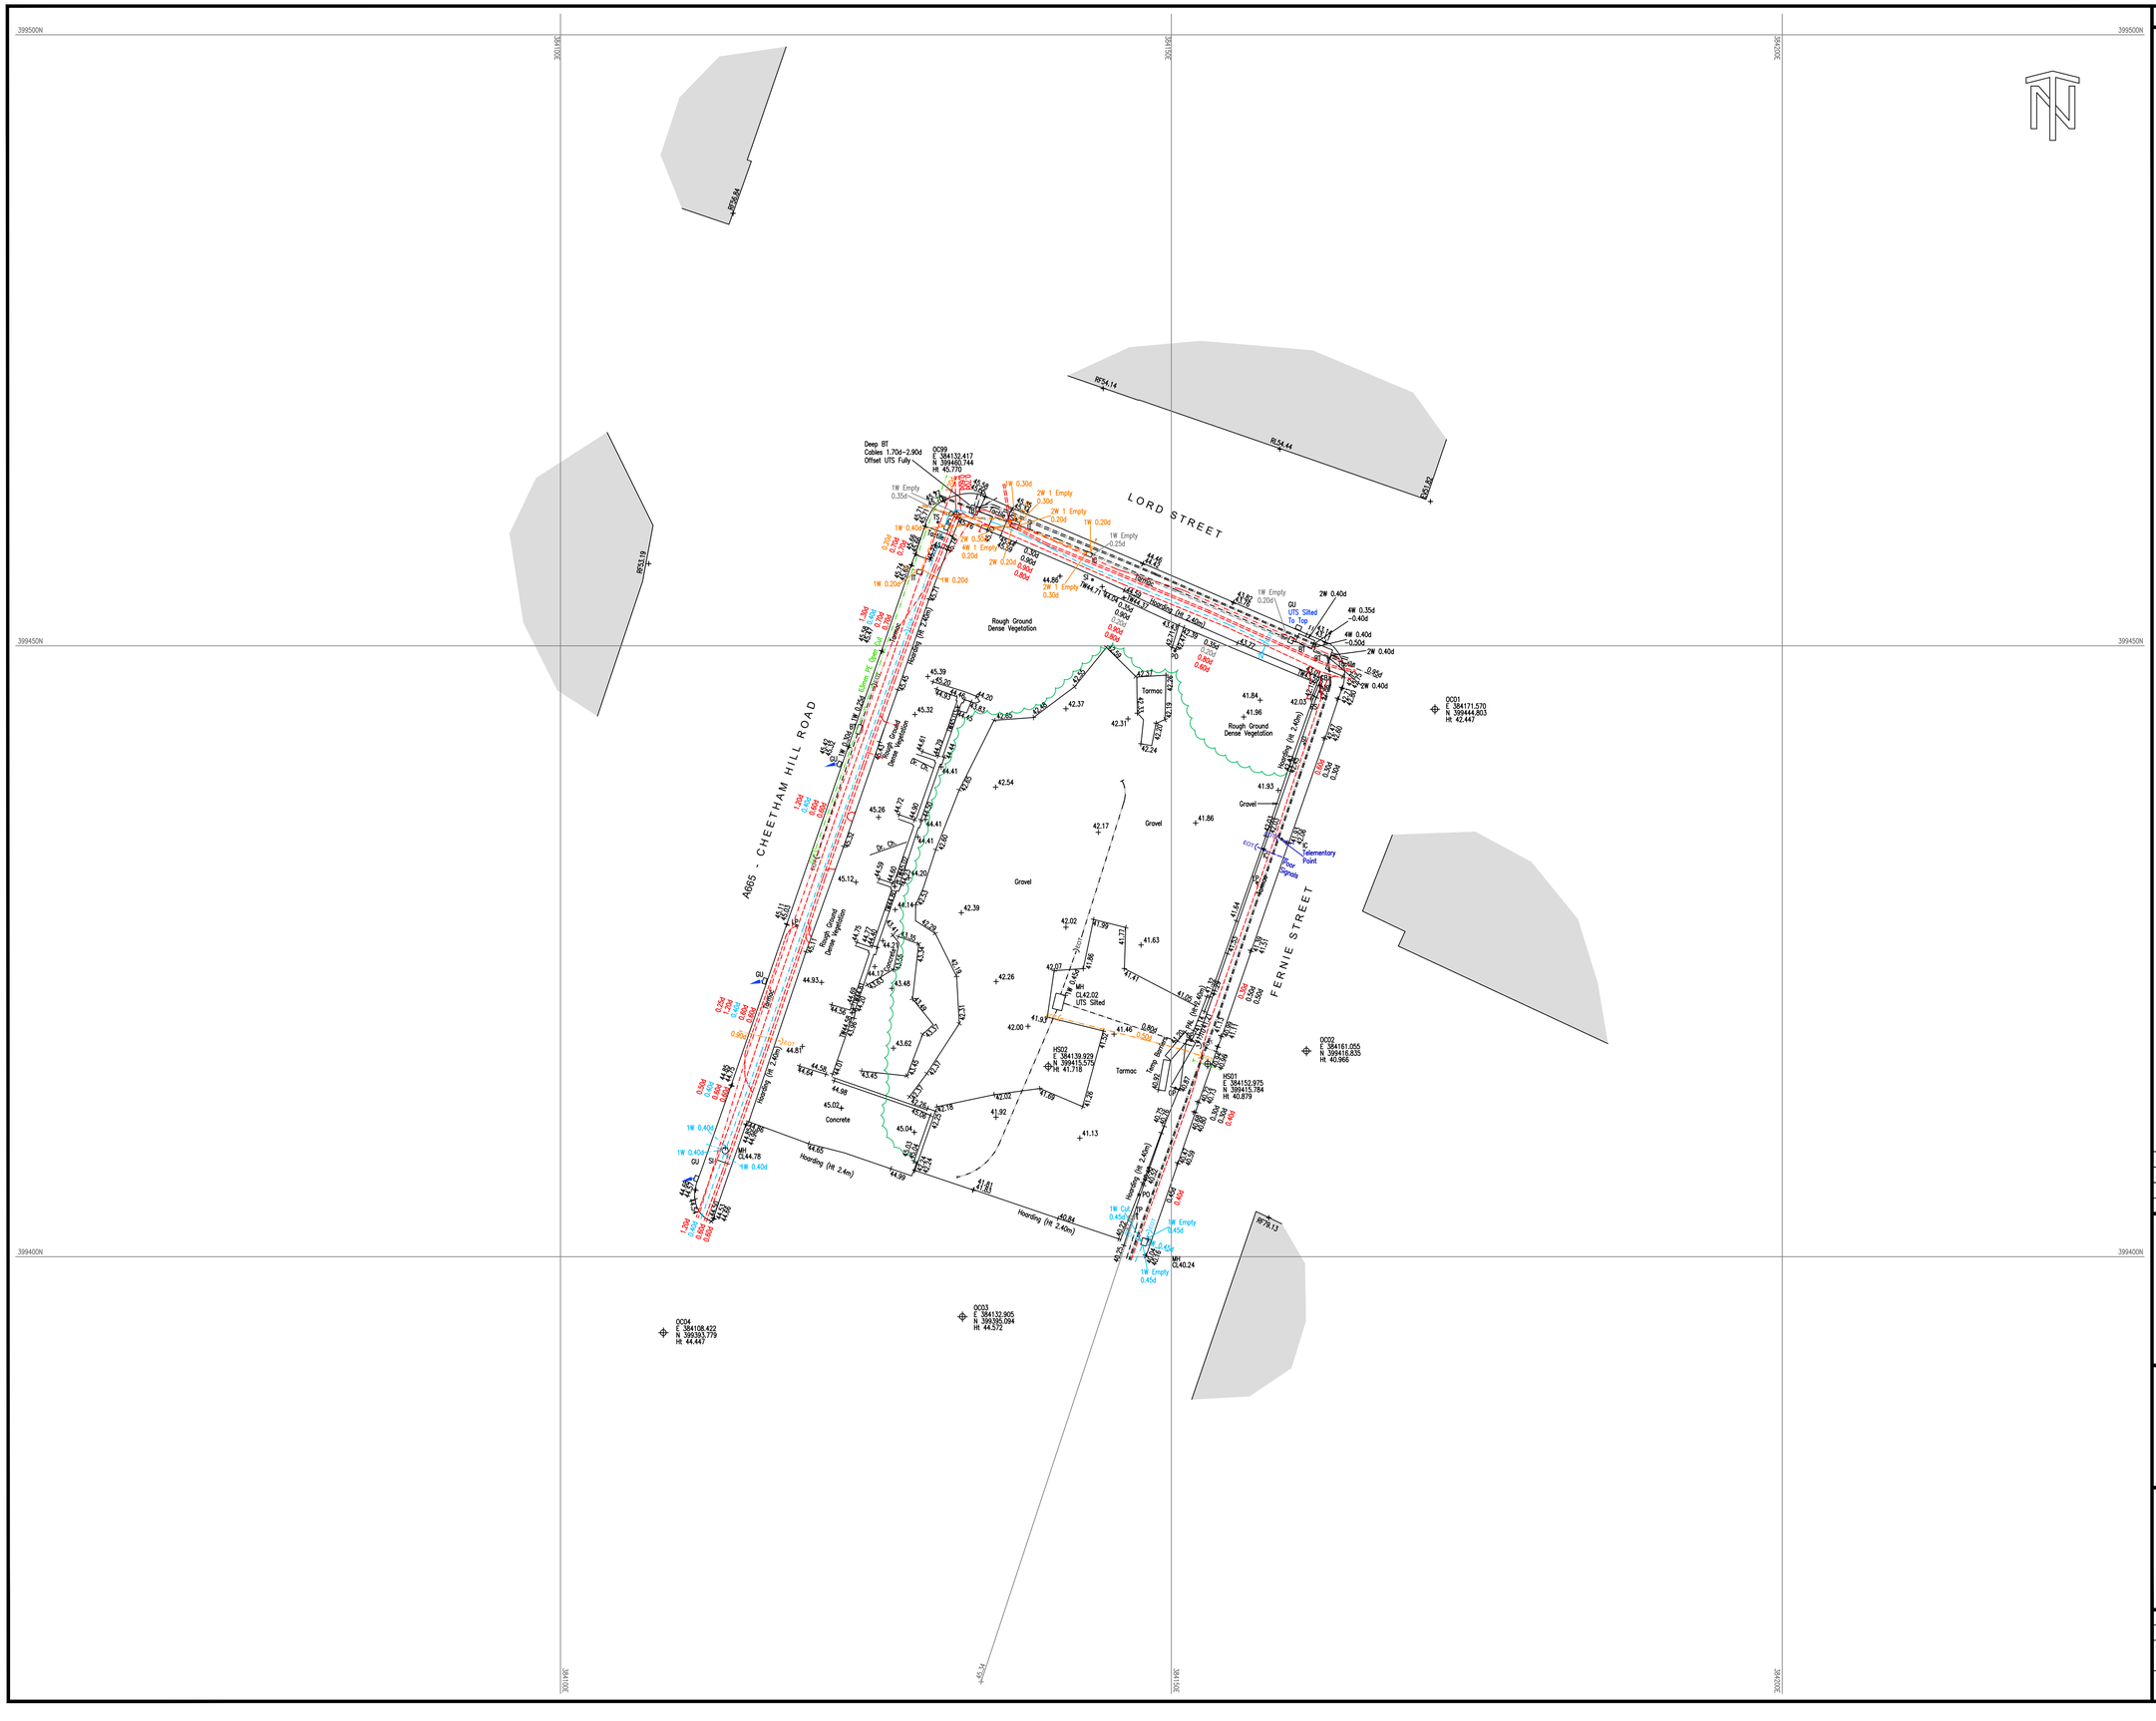

NOTES

KEY

Grid & Datum - Local Plane Grid related to OS National Grid & Datum By GNSS RTK Observations

STANDARD ABBREVIATIONS

STREET FURNITURE

A/C - AIR CONDITIONING
AE - AERIAL
AL - ALARM
AV - AIR VALVE
BA - BUOYANCY AID
BB - BELISHA BEACON
BD - BOUNDARY DIVIDE
BH - BOREHOLE
BI - BOLLARD ILLUMINATED
BL - BASEMENT LIGHT
BO - BOLLARD
BP - BOUNDARY POST
BR - BOULDER
BS - BUS STOP
BU - BUSH
CA - CABLE
CB - CONTROL BOX
CC - CLOSE CIRCUIT TV
CD - CONTROL BIN
CO - COLUMN
CT - CLOSE CIRCUIT TV POLE
DP - DOWN PIPE
DR - DRAIN
Dr Ch - DRAINAGE CHANNEL
DU - DUCT
EL - ELECTRIC
EP - ELECTRICITY POLE
ER - EARTH ROD
FA - FENDOR ANCHOR
FB - FLOWER BED
FH - FIRE HYDRANT
FL - FLOODLIGHT
FS - FLAG STAFF
GA - GAS
GM - GAS METER
G - GIRTH
GP - GATE POST
GU - GULLY
GV - GAS VALVE
Hyd - HYDRANT
IC - INSPECTION COVER
IT - TRAFFIC COVER
JB - JUNCTION BOX
KO - KERB OFFLET
LA - LADDER
LB - LITTER BIN
LC - LIGHTING COLUMN
LI - LIGHT
LP - LAMP POST
MBO - MOORING BOLLARD
MA - MAST
MH - MANHOLE
MO - MONUMENT
MP - MILE POST
MR - MOORING RING
MW - MONITORING WELL
NP - NAME PLATE
O/H - OVERHEAD
OSBM - ORDNANCE SURVEY BENCH MARK
PA - PLAY APPARATUS
PB - PILLAR BOX
PH - PUBLIC HOUSE
PI - PIPE
PL - PLANT
PM - PARKING METER
PN - PLANTER
PO - POST
PP - PETROL PUMP
RH - RIDGE HEIGHT
RS - ROAD SIGN
RI - ROAD SIGN ILLUMINATED
RTW - RETAINING WALL
RWP - RAINWATER PIPE
SA - STANCHION
SC - SPEED CAMERA
SD - SATELLITE DISH
SF - SECURITY FENCE
SG - SIGNAL
SI - SIGN
SI - SIGN ILLUMINATED
SMP - SERVICE MARKER POST
SS - SECURITY SENSOR
ST - STOP TAP
SU - STUMP
SV - STOP VALVE
SW - SWITCHGEAR
SY - STAY
TA - TAP
TBM - TEMPORARY BENCH MARK
TCB - TELEPHONE CALL BOX
TE - TELEPHONE
TM - TICKET MACHINE
TS - TRAFFIC SIGNAL
TP - TELEGRAPH POLE
UTL - UNABLE TO LIFT
VDP - VEHICLE DETECTOR PAD
VP - VENT PIPE
WB - WHISTLE BLOW
WM - WATER METER
WO - WASH OUT
WP - WASTE PIPE

FENCE TYPES

B/W - BARBED WIRE
C/B - CLOSE BOARDED
CI - CORRUGATED IRON
C/P - CONCRETE PANEL
H/R - HANDRAIL
I/R - IRON RAILING
PAL - PALISADE
P/C - POST & CHAIN
P/P - POST & PANEL
P/R - POST & RAIL
PSB - PEDESTRIAN SAFETY BARRIER
P/W - POST & WIRE
W/M - WIRE MESH

LEVELS

BL43.45 - BED LEVEL
EV43.45 - EAVE LEVEL
IL43.45 - INVERT LEVEL
43.45 - SPOT LEVEL
RF43.45 - ROOF LEVEL
RL43.45 - RIDGE LEVEL
SB43.45 - SOFT BED LEVEL
SL43.45 - SOFFIT LEVEL
TH43.45 - THRESHOLD LEVEL
WL43.45 - WATER LEVEL

SYMBOLS

HEDGE
GATE
BUILDING
TREE CANOPY
CONTROL STATION
EMBANKMENT
TREE
BUSH

UNDERGROUND SERVICE KEY

Foul/Combined water drain
Foul/Combined drain 300D and above
Surface water drain
Surface water drain 300D and above
Combined Water Drain
Surface water drain 300D and above
End of trace
Electric cables
HV cables
Gas
Water
Telephone
Catv
CCTV
Comms
Fibre Optics
Pipe

Vents
Fuel
Offsets
Vapour Recovery
Gauge Lines
Unidentified GPR
Unidentified EML
Taken From Records
Assumed Routes
Empty Ducts
Earth Rod
Rising Main
Overhead
Heating Pipes
Traffic Signals
Multi User
Trench Scar
Service Duct

Where chamber extents are significantly greater than the cover size, their approximate extents are shown thus;

ABBREVIATION KEY

AR assumed route
BD base bend
BD backdrop
CK cable
CL cable level
CR cable riser
DP down pipe
EBD external back drop
EOT end of trace
FP flood light pole
FH fire hydrant
FL flooded
G gully
GV gas valve
HOR head of run
HL high level
IC inspection chamber
IBD internal back drop
IL invert level
MH manhole
PL pit level
PR pipe riser
RE rodding eye
SP soil water pipe
SIL silt level
SL slit level
SV stop valve
SVP soil vent pipe
TE trapped exit
TTR taken from records
TP telegraph pole
UUD unable to determine outfall
UTL unable to lift
UTI unable to trace
UTS unable to survey
UTT unable to trace
VP vent pipe
WC water closet
WM water meter
WO wash out valve

UTILITY SURVEY NOTES

ELECTROMAGNETIC AND/OR GROUND PENETRATING RADAR TECHNIQUES HAVE BEEN USED TO LOCATE AND MAP UNDERGROUND UTILITIES AND FEATURES ON THIS DRAWING. N D OLIVER & CO LTD HAVE MADE EVERY ENDEAVOR TO MAKE SURE THAT THE INFORMATION CONTAINED WITHIN THIS DRAWING IS ACCURATE BEFORE THE HIGHEST EQUIPMENT POSSIBLE, THE RESULTS FROM THESE TYPES OF SURVEYS ARE NOT INFALLIBLE AND SHOULD THE LOCATION OR EXISTENCE OF ANY UTILITY BE OF CRUCIAL IMPORTANCE TO A PROJECT, THEN IT IS STRONGLY ADVISED THAT TRIAL EXCAVATIONS SHOULD BE UNDERTAKEN TO CONFIRM SURVEY RESULTS.

N D OLIVER & CO LTD HAVE USED ALL RECORD DRAWINGS THAT WERE AVAILABLE TO US BY THE CLIENT OR BY THE STATUTORY UTILITY PROVIDERS AT THE TIME OF THE SURVEY. ANY INFORMATION TAKEN FROM THESE DRAWINGS (IE PIPE SIZES, MATERIAL) IS NOT GUARANTEED. SERVICES LOCATED FROM RECORD DRAWINGS WILL BE SHOWN AND ANNOTATED AS TAKEN FROM RECORDS (TFR). HISTORIC RECORD INFORMATION IS OFTEN INCOMPLETE/INACCURATE AND CANNOT BE RELIED UPON.

A SINGLE LINE INDICATING A UTILITY MAY INDICATE THE PRESENCE OF MULTIPLE SERVICES WITHIN CLOSE PROXIMITY TO EACH OTHER. WHERE A SINGLE LINE TYPE IS SHOWN WE RECOMMEND HAND DIGGING BEING LEGAL TO EXPOSE HIDDEN SERVICES.

WHERE QUOTED, DEPTH INFORMATION OF UNDERGROUND SERVICES/FEATURES IS STATED. DEPTHS ARE GENERALLY WITHIN +/- 10% ACCURATE, BUT CANNOT BE GUARANTEED. ANY DEPTHS SHOWN ARE USUALLY TO THE TOP OF THE SERVICE/FEATURE, GRANTY SEWERS AND DRAINS ARE USUALLY TO INVERT (BASE OF DRAINAGE CHANNEL) UNLESS OTHERWISE STATED.

AT N D OLIVER & CO LTD WE USE SKILLED STAFF AND MODERN CALIBRATED EQUIPMENT TO PERFORM OUR SURVEYS, HOWEVER, THE COMPLETENESS OF THE SURVEY CANNOT BE GUARANTEED AND THE CLIENT ACCEPTS THIS BY INSTRUCTING US TO UNDERTAKE THE SURVEY AND WE CANNOT BE HELD RESPONSIBLE FOR ANY INACCURACIES BEYOND THOSE THAT COULD BE REASONABLY EXPECTED OF A CLIENT DAY SURVEY.

CONTRACTORS UTILISING OUR DRAWING FOR INTRUSIVE WORK SHOULD TAKE ALL REASONABLE MEASURES TO WORK SAFELY IN ACCORDANCE WITH HSG47 GUIDELINES "AVOIDING DANGER FROM UNDERGROUND SERVICES".

Rev	Date	Drawn	Description	Ch'k'd	App'd

N D OLIVER & CO
CHARTERED GEOMATIC SURVEYORS
Jupiter House, 21 Roebuck Lane, Sale, Manchester, M33 7SY
T: 0161 973 3495 F: 0161 962 6819
E: mail@ndoliver.com www.ndoliver.com

Client

LINEAR DESIGN & CONSTRUCT
BOWDEN HOUSE
2 SCOTT DRIVE
ALTRINCHAM
WA15 8AB

Title

NUMBER ONE, LORD STREET
MANCHESTER
M4 4EX

TOPOGRAPHICAL SURVEY

SHEET 1 OF 1

Surveyed	TB/OB	Drawn	HS	Drawn Date: 31/01/2025
Checked	AM	Approved	NDO	
Scale 1:250 @ A1		Project 13189		Status ORIG
		CAD File P:\2D DRAWINGS\13189_001.DWG		
Drawing No 13189 / 001				Rev 0