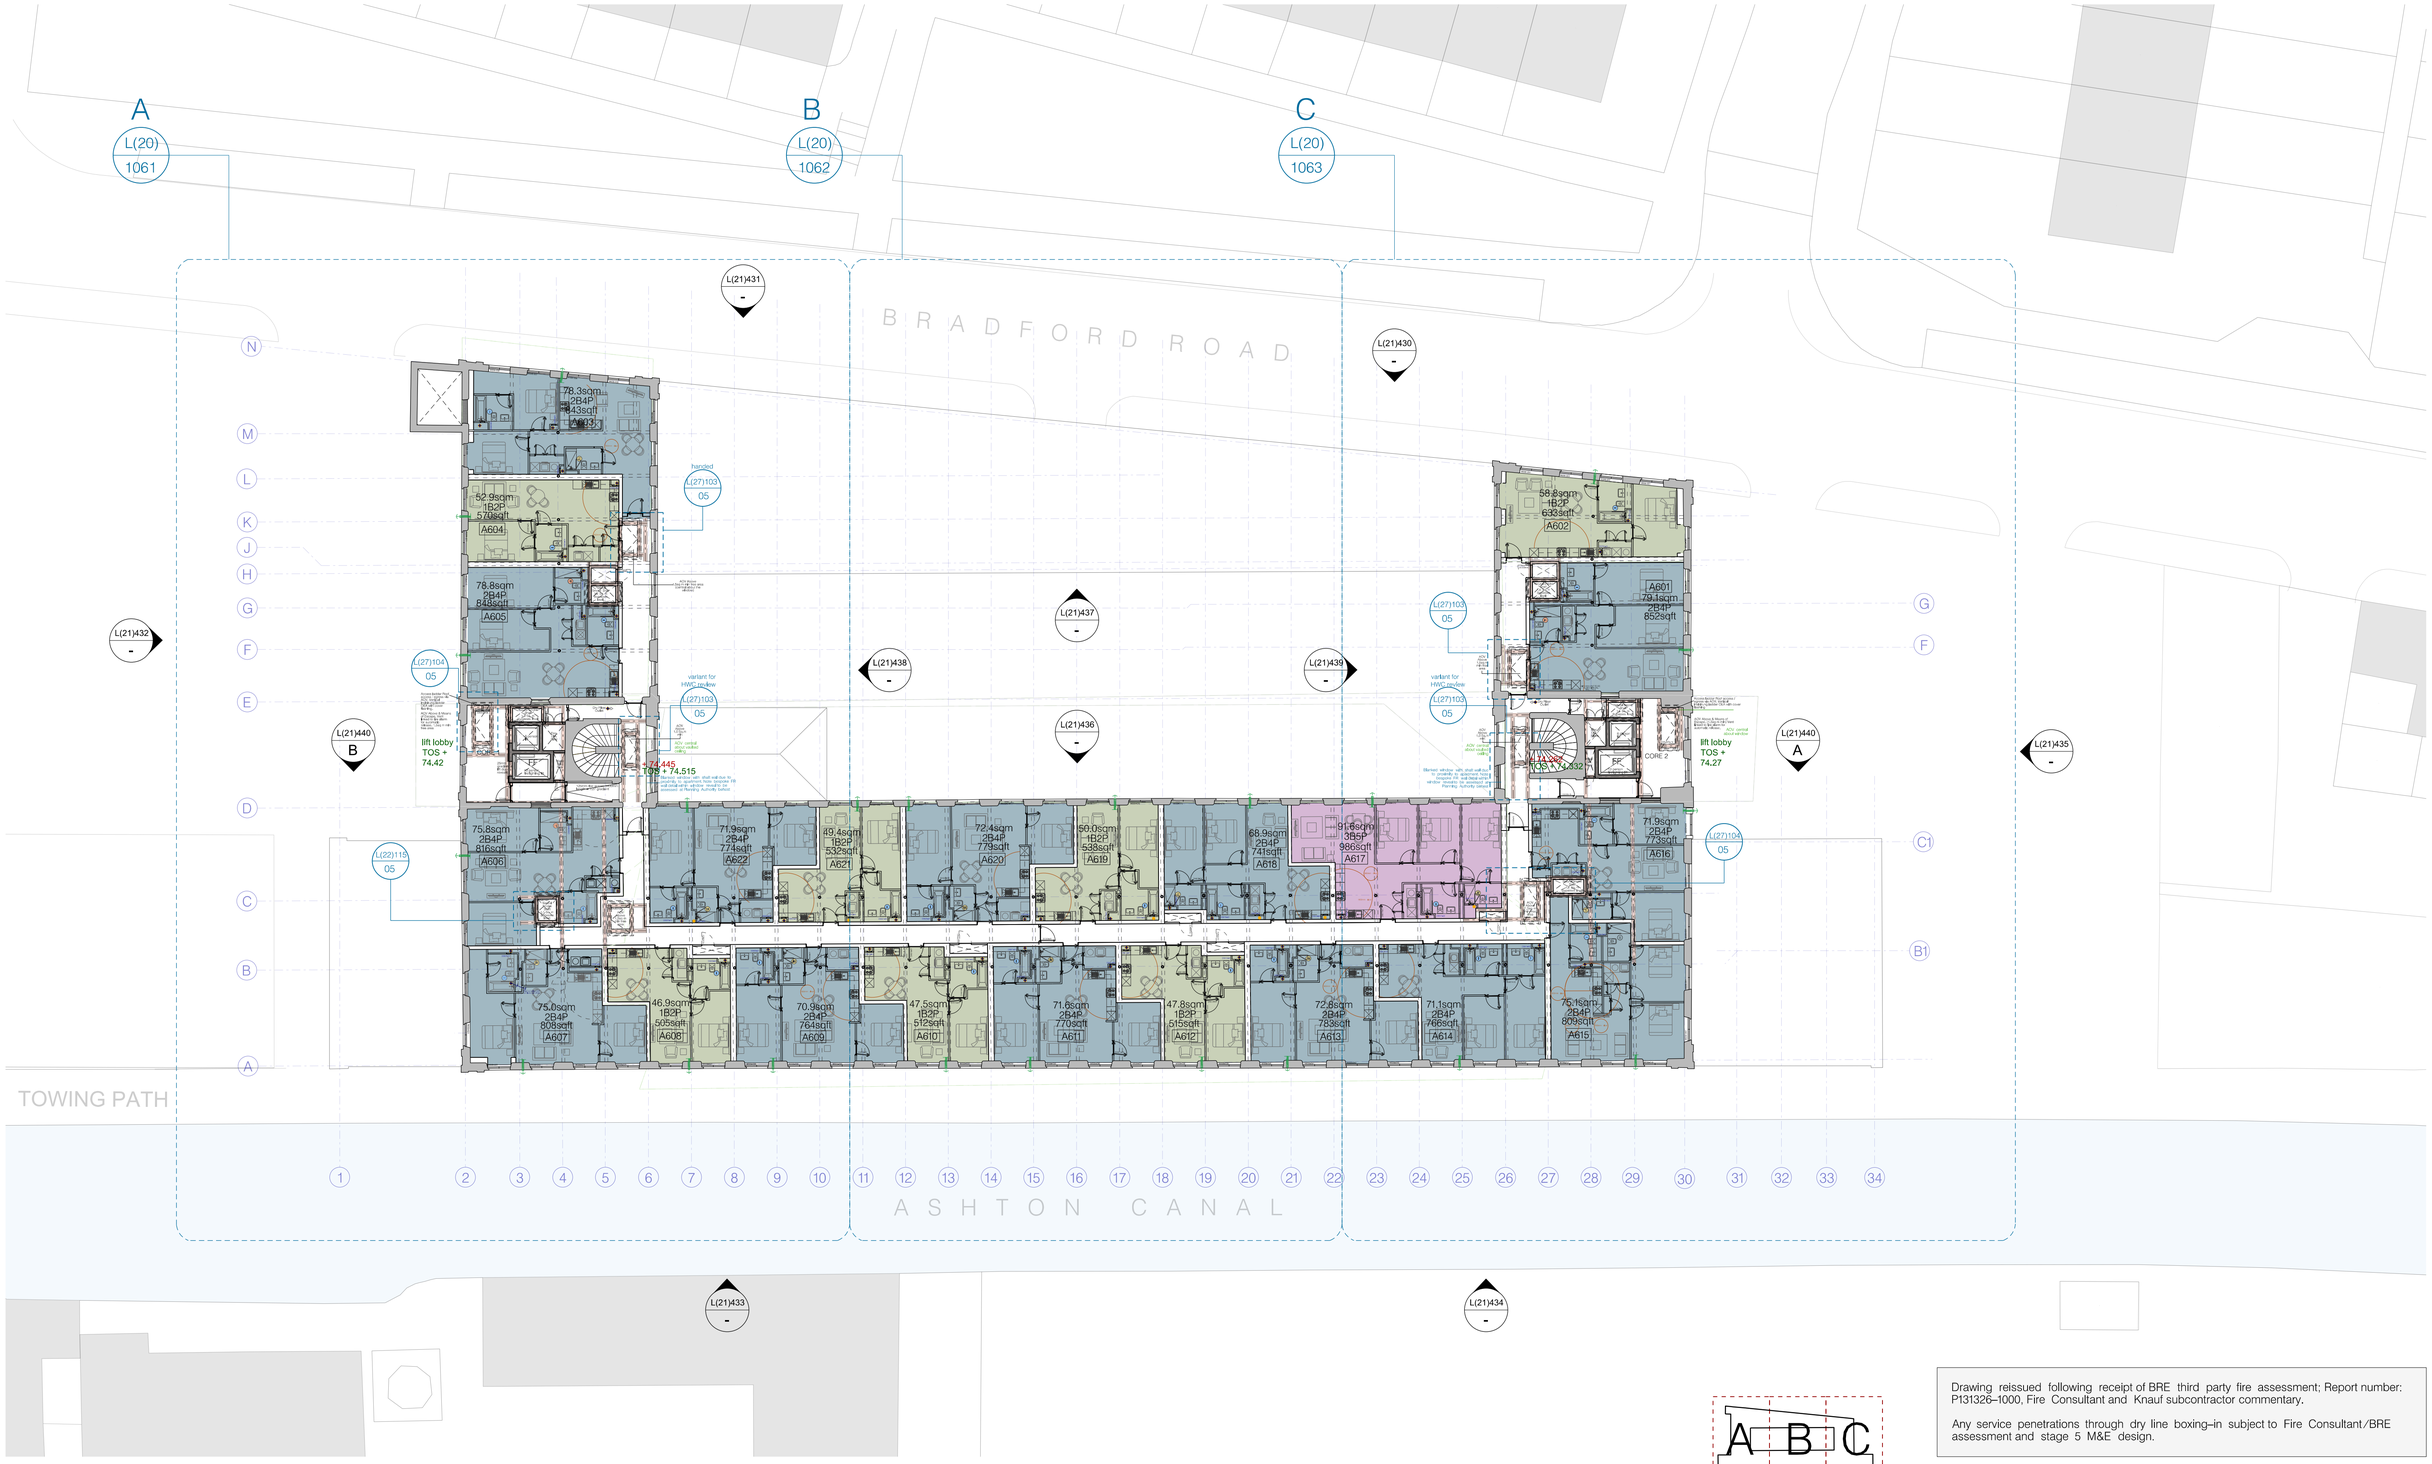


Drawing reissued following receipt of BRE third party fire assessment; Report number: P131326–1000, Fire Consultant and Knauf subcontractor commentary.

Any service penetrations through dry line boxing–in subject to Fire Consultant/BRE assessment and stage 5 M&E design.

hodder+partners

SGI Studios
1 Kelso Place
Manchester M15 4LE

t: +44(0)161 832 9842
e: mail@hodderandpartners.com
w: www.hodderandpartners.com

DO NOT SCALE
Work to annotated dimensions only.
Read drawing in conjunction with relevant specification, Structural Engineers' and Services Engineers' drawings.
Confirm all dimensions before commencement of any work on site or fabrication.


revisions + notes:

P1	30/08/2023	FIRST ISSUE
P2	08/11/23	Accommodation removed from flue chimney, smoke shaft amended.
P3	17/11/2023	Lift positions altered for risers, fireproof areas added.
P4	18/12/2023	Various apartment layouts rearranged. Colours adjusted.
P5	07/05/2024	Lift handing changed, Risers removed pending confirmation from MEP Consultant, Hob proximities amended, some layout changes as a result.
P6	01/11/2024	North East smoke shaft moved following FE comments. A615, A616, A617 layouts adjusted.
P7	05/02/2025	Team Issue
P8	26/02/2025	Team Issue
P9	20/03/2025	Team Issue
P10	03/04/2025	Team Issue
P11	06/05/2025	Areas update, Sheet ref anotated
C1	23.06.25	PRELIMINARY CONSTRUCTION ISSUE
C2	07.10.25	AOV UPDATE, UNITS 615, 616 UPDATE TO LAYOUT
C3	09.10.25	AOV /SMOKE SHAFT UPDATE TO SUIT SE COMMENTS AND VELUX INFO AND STANDARD SIZE WHERE POSS
C4	07.11.25	MISC APARTMENT UPDATE,RIBER TRIMMING COORDINATION WITH SE UPDATE, TOS STAIR LEVELS AS PER SURVEY SOLUTIONS SITE SURVEY
C5	04.12.25	WALL AND DOOR SETTING OUT TO ALLOW FOR SVP AND DRY LINING POST BRE REPORTING, MINOR SMOKE AND SERVICE CORE UPDATE FURTHER TO STRUCTURAL COORDINATION, MEV POSITION UPDATE
C6	23.01.25	Int apartmnt wall adjustment to reduce dryline boxing-in. Utility cpd door adjustment size. Core door adjust. Bathrm access panels added, SVP coordinsation, 2 no, (internal) RWP added to Bradford Road elevation
C7	11.02.26	SVP access panel to front face. AOV 02 & 13 update to s/c comment

NOTE – APARTMENT VENTILATION
MEV vent extract based upon acoustic trickle vent being adopted over windows. Trickle vent and MEV location in elevation subject to LA approval. Design and location of MEV subject to M&E and SE input. Refer to typical apartment dwg L(31)002. L(31)003 and elevations.

NOTE – LEVELS
– approx existing level + 00.000
– Proposed Top of screed TOS + 00.000

Lift lobby to be flat level across full width to ensure consistent dimension for lift thresholds. All lift thresholds to be 25mm above FFL. Client to confirm floor finish. All levels subject to site check

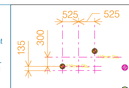

SVP SET OUT
Dimension indicates setting out of SVPs.
Dimensions set from centre of existing structural steelwork. Dimensions to the centre of the pipework.
Dimensions to be checked on site to ensure stacking of pipework. Diameter of pipework to M&E information. Acoustic lagging and boxing in to acoustic recommendations.

Substack position (typical dryline boxing out to extend to allow for substack)

Ground Floor
SVP shown in green identifies vertical drop adjacent to column. Pipe to be offset in soffit as identified.

Ground floor sub level pop up positions subject to site check to ensure avoidance of clash with existing foundations. SVP Pipe to be offset under new floor level for sub ground drainage, above the existing baseplate.
All SVP pop up locations subject to M&E stage 4/5 design coordination. Slab buildups and waterproofing strategy subject to Waterproofing specialist design. FR access panels to be added to corridors. Internal access where corridor access is not possible

RWP (Internal)
(Consolux to confirm pipe dia size and incorporate into design. HWC to incude in Civils drainage)

CONSOLUX TO REVIEW ALL SVP SET OUT - SPACE BEHIND SHOWER SPACE. SPACING INBETWEEN SVPS FOR STRUCTURAL CORING. & N/E UNIT KITCHEN CHANGE. CONSOLUX TO UPDATE DWGS TO ALLOW FOR REFERENCE INTO ARCHITECTURAL DWGS

NOTE
Indicates HOD proxy structure for coordination only. Refer to Structural Engineers drawings for structural information. Fire protection of structure subject to supplier and BRE comment

0 10m 20m

client:	**date:**
ARROWSMITH BRUNSWICK SQUARE LTD.	JUNE 2025
project:	**scale:** / **drawn by:**
BRUNSWICK MILL DEVELOPMENT PHASE 1	1:200 @A1 / TC
title:	**drawing number:**
LEVEL 6 PROPOSED	L(20)206
status:	**job number:** / **revision:**
STAGE 5 – CONSTRUCTION	0586 / C7

hodder+partners