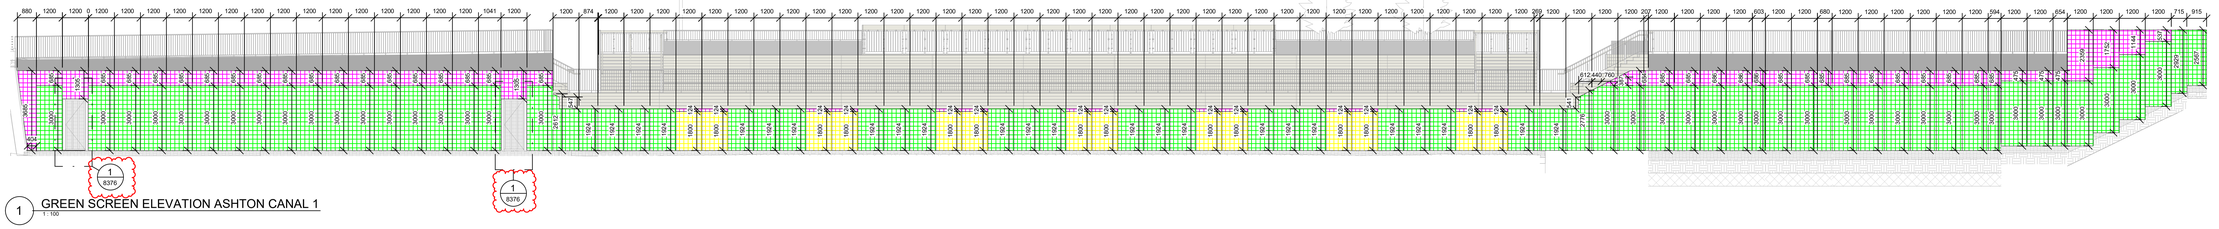

1 GREEN SCREEN ELEVATION ASHTON CANAL 1
1 : 100

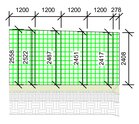

2 GREEN SCREEN ELEVATION ASHTON CANAL 2
1 : 100

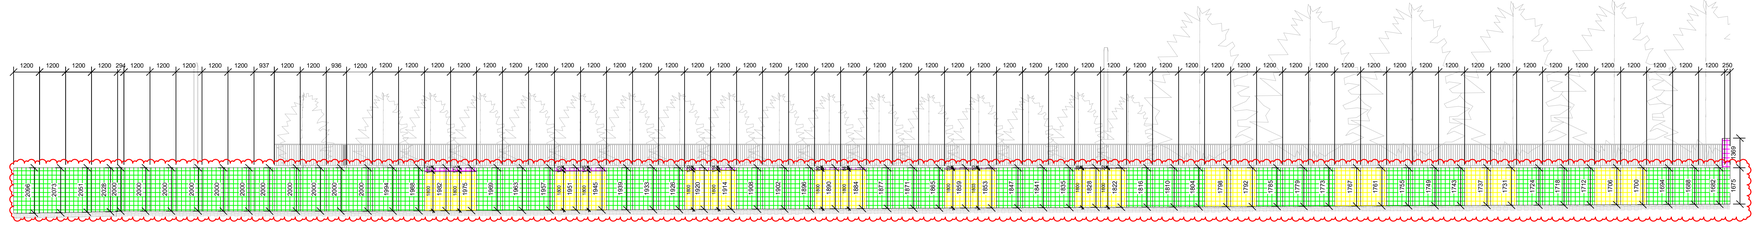

WALL HEIGHT AMENDED FOLLOWING DCR #0063
AND SI 324 | POP-64

3 GREEN SCREEN ELEVATION ASHTON CANAL 3
1 : 100

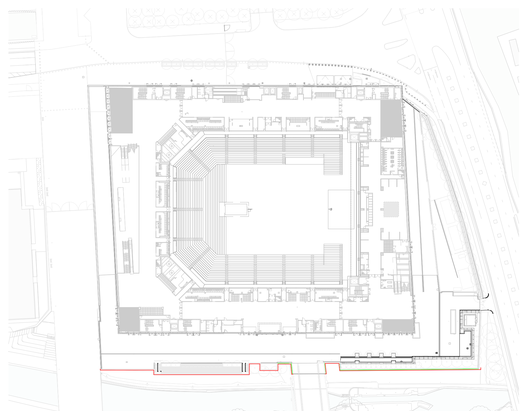

4 LOCATION PLAN
1 : 1000

Suitability Code (as defined in ISO 19650-2:2018)

Work in Progress (WIP)
S0 - Initial Status

Shared (Non- Contractual)
S1 - Suitable for co-ordination
S2 - Suitable for information
S3 - Suitable for review & comment
S4 - Suitable for stage approval
S5 - Withdrawn
S6 - Suitable for PIM authorisation
S7 - Suitable for AIM authorisation

Published (Contractual)
A1, A2, A3, Etc - Authorised and accepted
B1,B2,B3, Etc. - Partial sign-off (with comments)

Published (AIM Acceptance)
CR - As constructed record document

KEY PLAN

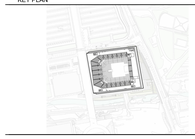

KEY

EXT-541 PRE-GROWN GREEN SCREEN PANEL UP TO 3M HEIGHT
HEDERA HELIX 'WOERNER'

EXT-541 PRE-GROWN GREEN SCREEN PANEL UP TO 1.8M HEIGHT
EUONYMUS FORTUNEI 'DART'S BLANKET'

EXT-541 ADDITIONAL SUPPORT GALVANISED STEEL MESH TO ALLOW CLIMBING PLANTS TO GROW OVER PRE-GROWN HEIGHT ABOVE 3M HEIGHT FOR HEDERA HELIX 'WOERNER'
ABOVE 1.8M HEIGHT FOR EUONYMUS FORTUNEI 'DART'S BLANKET'

THIS DRAWING IS ONLY TO SCALE IF IT IS REPRODUCED AT THE CORRECT PAPER SIZE

1:100@A0

0 1 2 3 4 8 m

ALL INTERNAL LAYOUTS AND USES ARE SHOWN FOR ILLUSTRATIVE PURPOSES ONLY AND ARE NOT FOR DETERMINATION

Safety, Health and Environmental Information

In addition to the hazards / risks normally associated with the types of work detailed on this drawing, note the following risks and information:

Construction	See risk register No abnormal risks identified with this package of work

For information relating to Use, Cleaning and Maintenance see the Health and Safety File. It is assumed that all works will be carried out by a competant contractor working, where appropriate, to an approved method statement.

client

OVG INTERNATIONAL

© COPYRIGHT. ALL RIGHTS RESERVED

THIS WORK IS COPYRIGHT AND CANNOT BE REPRODUCED OR COPIED IN ANY FORM OR BY ANY OTHER MEANS (GRAPHIC, ELECTRONIC OR MECHANICAL INCLUDING PHOTOCOPYING) WITHOUT THE WRITTEN PERMISSION OF POPULOUS ANY LICENSE, EXPRESS OR IMPLIED, TO USE THIS WORK IS LIMITED TO THE PURPOSE AND PERSON STATED IN THE CONDITIONS OF THE AGREEMENT OR IMPLIED AGREEMENT BETWEEN POPULOUS AND THE INTELECTING PARTY

USE FIGURED DIMENSIONS IN PREFERENCE TO SCALED. CHECK ALL DIMENSIONS ON SITE BEFORE FABRICATION OR SETTING OUT

architect

POPULOUS®

14 BLADES COURT | DEODAR ROAD | LONDON | SW15 2NU | UNITED KINGDOM
TELEPHONE +44 (0)20 8874 7666 FACSIMILE +44 (0)20 8874 7470

ALL PRODUCTION & INTELLECTUAL PROPERTY RIGHTS RESERVED © POPULOUS 2009

REVISIONS

REV	DATE	DESCRIPTION
00	22.06.2020	ISSUED FOR T2 STAGE 4a
01	30.06.2021	STAGE 4B LIVING WALL AND GREEN SCREEN
C01	18.11.2021	GREEN SCREEN ISSUED FOR CONSTRUCTION
C02	27.05.2022	SECURITY FENCE ADDED BEHIND GREEN SCREEN IN SOUTH WEST CORNER ALONG ASHTON CANAL

project name **Co-op Live**

title GREEN SCREEN ELEVATION
ASHTON CANAL

purpose of issue
CONSTRUCTION

scale 1:100@A0 drawn FP Project no. Suitability
date 22.06.2020 checked TJ 4933 S4

reference project code originator volume level type role number **BRA-POP-ZZ-GF-DR-L-8352** rev. **C02**