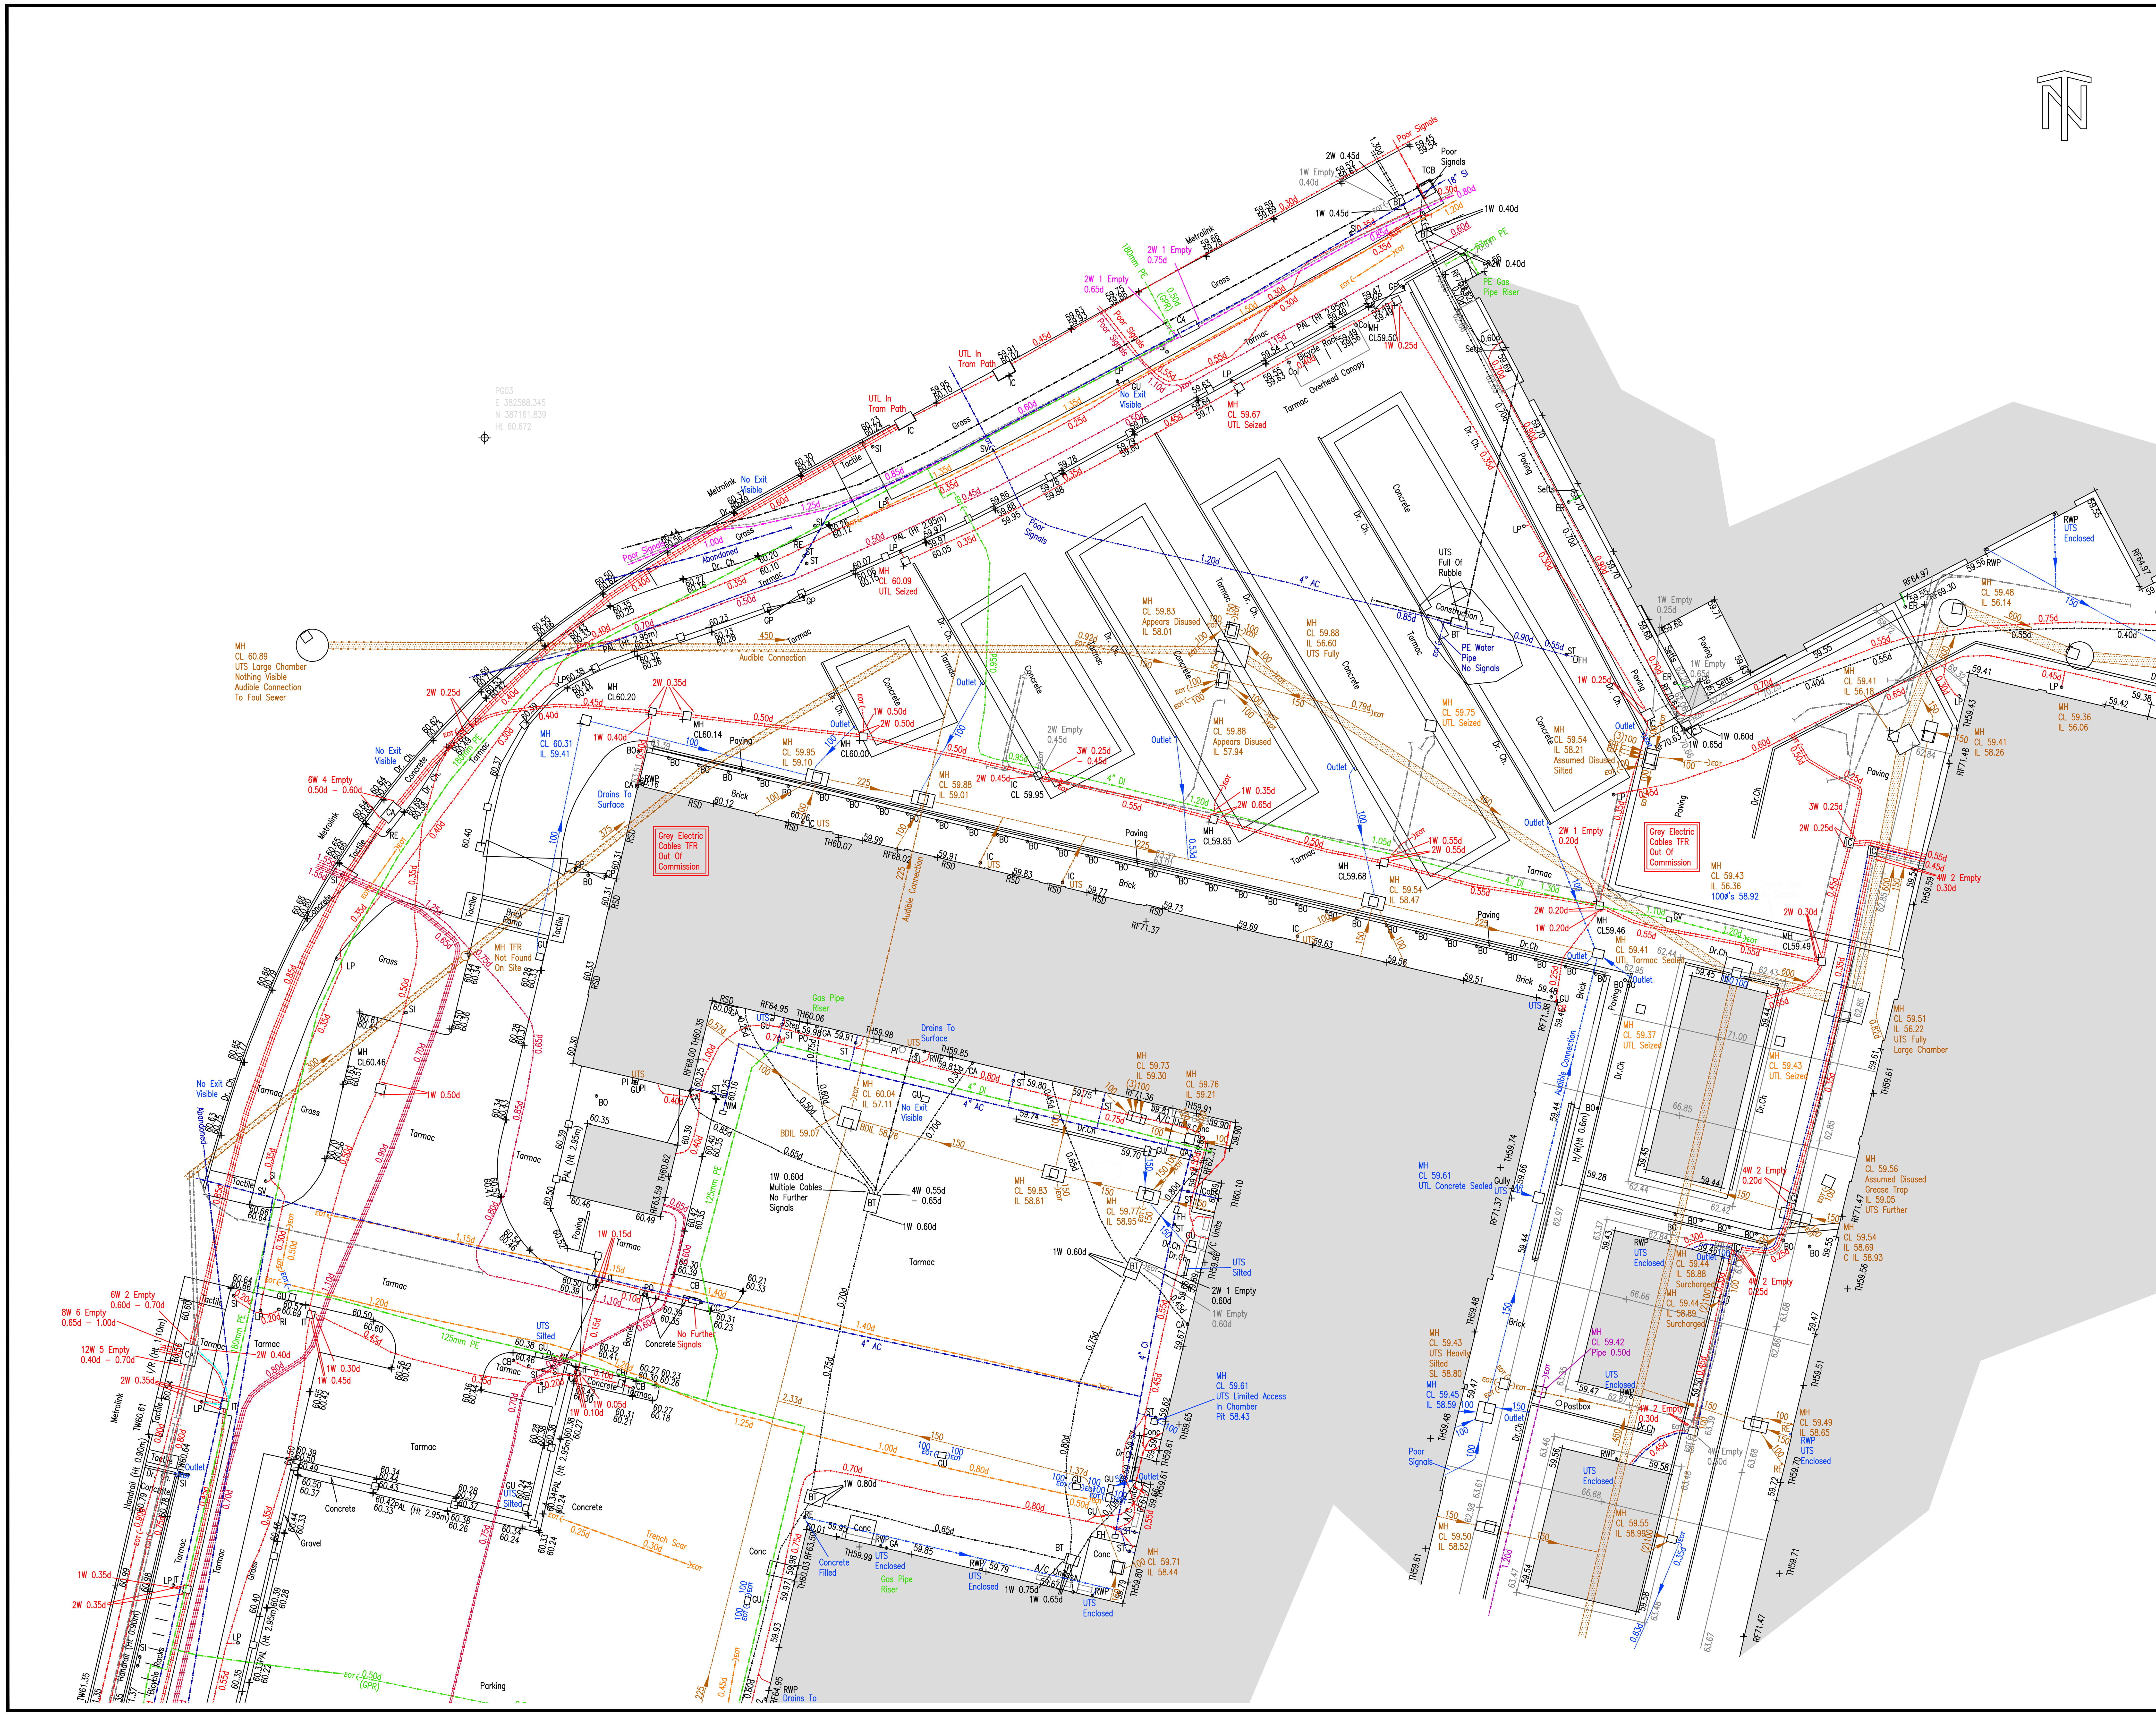

NOTES

KEY

Grid & Datum - Local Plane Grid related to OS National Grid & Datum By GNSS RTK Observations

STANDARD ABBREVIATIONS

STREET FURNITURE

A/C - AIR CONDITIONING
AE - AERIAL
AL - ALARM
AV - AIR VALVE
BA - BUOYANCY AID
BB - BELISHA BEACON
BD - BUILDING DIVIDE
BH - BOREHOLE
BI - BOLLARD ILLUMINATED
BL - BASEMENT LIGHT
BO - BOLLARD
BP - BOUNDARY POST
BR - BOULDER
BS - BUS STOP
BU - BUSH
CA - CABLE
CB - CONTROL BOX
CC - CLOSE CIRCUIT TV
CIB - CIGARETTE BIN
Col - COLUMN
CT - CLOSE CIRCUIT TV POLE
DP - DOWN PIPE
DR - DRAIN
Dr.Ch - DRAINAGE CHANNEL
DU - DUCT
EL - ELECTRIC
EP - ELECTRICITY POLE
ER - EARTH ROD
FA - FENDOR ANCHOR
F/B - FLOWER BED
FH - FIRE HYDRANT
FL - FLOODLIGHT
FS - FLAG STAFF
GA - GAS
GM - GAS METER
G - GIRTH
GP - GATE POST
GU - GULLY
GV - GAS VALVE
Hyd - HYDRANT
IC - INSPECTION COVER
IT - TRAFFIC COVER
JB - JUNCTION BOX
KO - KERB OFFSET
LA - LADDER
LB - LITTER BIN
LC - LIGHTING COLUMN
LI - LIGHT
LP - LAMP POST
MBO - MOORING BOLLARD
MA - MAST
MH - MANHOLE
MO - MONUMENT
MP - MILE POST
MR - MOORING RING
MW - MONITORING WELL
NP - NAME PLATE
O/H - OVERHEAD
OSBM - ORDNANCE SURVEY BENCH MARK
PA - PLAY APPARATUS
PB - PILLAR BOX
PH - PUBLIC HOUSE
PI - PIPE
PL - PLANT
PM - PARKING METER
PN - PLANTER
PO - POST
PP - PETROL PUMP
RH - RIDGE HEIGHT
RS - ROAD SIGN
RI - ROAD SIGN ILLUMINATED
RTW - RETAINING WALL
RWP - RAINWATER PIPE
SA - STANCHION
SC - SPEED CAMERA
SD - SATELITTE DISH
S/F - SAFETY FENCE
SG - SIGNAL
SI - SIGN
SI - SIGN ILLUMINATED
SMP - SERVICE MARKER POST
SS - SECURITY SENSOR
ST - STOP TAP
SU - STUMP
SV - STOP VALVE
SW - SWITCHGEAR
SY - STAY
TA - TAP
TBM - TEMPORARY BENCH MARK
TCB - TELEPHONE CALL BOX
TE - TELEPHONE
TM - TICKET MACHINE
TS - TRAFFIC SIGNAL
TP - TELEGRAPH POLE
UTL - UNABLE TO LIFT
VDP - VEHICLE DETECTOR PAD
VP - VENT PIPE
WB - WHISTLE BLOW
WM - WATER METER
WO - WASH OUT
WP - WASTE PIPE

FENCE TYPES

B/W - BARBED WIRE
C/B - CLOSE BOARDED
C/I - CORRUGATED IRON
C/P - CONCRETE PANEL
H/R - HANDRAIL
I/R - IRON RAILING
PAL - PALISADE
P/C - POST & CHAIN
P/P - POST & PANEL
P/R - POST & RAIL
PSB - PEDESTRIAN SAFETY BARRIER
P/W - POST & WIRE
W/M - WIRE MESH

LEVELS

BL43.45 - BED LEVEL
EV43.45 - EAVE LEVEL
IL43.45 - INVERT LEVEL
43.45 - SPOT LEVEL
RF43.45 - ROOF LEVEL
RL43.45 - RIDGE LEVEL
SB43.45 - SOFT BED LEVEL
SL43.45 - SOFFIT LEVEL
TH43.45 - THRESHOLD LEVEL
WL43.45 - WATER LEVEL

SYMBOLS

HEDGE · GATE · BUILDING · TREE CANOPY · CONTROL STATION · EMBANKMENT · TREE · BUSH

SHEET LAYOUT

001 / 1 · 001 / 2 · 001 / 3 · 001 / 4 · 001 / 5 · 001 / 6 · 001 / 7 · 001 / 8 · 001 / 9 · 001 / 10

UNDERGROUND SERVICE KEY

Foul/Combined water drain
Foul/Combined drain 300Ø and above
Surface water drain
Surface water drain 300Ø and above
Combined Water Drain
Surface water drain 300Ø and above
End of trace — EOT
Electric cables — E
HV cables — HV
Gas
Water
Telephone — BT
Catv
CCTV
Comms — COM
Fibre Optics — FO
Pipe
Vents — V
Fuel — F
Offsets — O
Vapour Recovery — VR
Gauge Lines — G
Unidentified GPR
Unidentified EML
Taken From Records
Assumed Routes
Empty Ducts — ED
Earth Rod — ER
Rising Main — RM
Overhead — O/H
Heating Pipes — HP
Traffic Signals — TS
Multi User
Trench Scar
Service Duct

Where chamber extents are significantly greater than the cover size, their approximate extents are shown thus;

ABBREVIATION KEY

AR assumed route
BD base bend
BD backdrop
CP cable pit
CL cover level
CR cable riser
DP down pipe
EBD external back drop
EOT end of trace
EP electricity pole
FH fire hydrant
FL flooded
G gully
GV gas valve
HOR head of run
HL high level
IC inspection chamber
IBD internal back drop
IL invert level
MH manhole
PL pit level
PR pipe riser
RE rodding eye
RWP rainwater pipe
SIL silted
SL silt level
SV stop valve
SVP soil vent pipe
TE trapped exit
TFR taken from records
TP telegraph pole
UDO unable to determine outfall
UTF unable to find
UTL unable to lift
UTS unable to survey
UTT unable to trace
VP vent pipe
WL water level
WM water meter
WO wash out valve

UTILITY SURVEY NOTES

ELECTROMAGNETIC AND/OR GROUND PENETRATING RADAR TECHNIQUES HAVE BEEN USED TO LOCATE AND MAP UNDERGROUND UTILITIES AND FEATURES ON THIS DRAWING. N D OLIVER & CO LTD HAVE MADE EVERY ENDEAVOUR TO MAKE SURE THAT THE INFORMATION CONTAINED WITHIN THIS DRAWING IS ACCURATE AND OF THE HIGHEST QUALITY. HOWEVER, THE RESULTS FROM THESE TYPES OF SURVEYS ARE NOT INFALLIBLE AND SHOULD THE LOCATION OR DEPTH OF SERVICES/FEATURES BE OF PARTICULAR IMPORTANCE TO A PROJECT, THEN IT IS STRONGLY ADVISED THAT TRIAL EXCAVATIONS SHOULD BE UNDERTAKEN TO CONFIRM SURVEY RESULTS.

N D OLIVER & CO LTD HAVE USED ALL RECORD DRAWINGS THAT WERE AVAILABLE TO US BY THE CLIENT OR BY THE STATUTORY UTILITY PROVIDERS AT THE TIME OF THE SURVEY. ANY INFORMATION TAKEN FROM THESE DRAWINGS (IE PIPE SIZES, MATERIAL) IS NOT GUARANTEED. SERVICES LOCATED FROM RECORD DRAWINGS WILL BE SHOWN AND ANNOTATED AS TAKEN FROM RECORDS (TFR). HISTORIC RECORD INFORMATION IS OFTEN INCOMPLETE/INACCURATE AND CANNOT BE RELIED UPON.

A SINGLE LINE INDICATING A UTILITY MAY INDICATE THE PRESENCE OF MULTIPLE SERVICES WITHIN CLOSE PROXIMITY TO EACH OTHER. WHERE A SINGLE LINE TYPE IS SHOWN WE RECOMMEND HAND DIGGING WITHIN 0.5m, TO EXPOSE HIDDEN SERVICES.

WHERE QUOTED, DEPTH INFORMATION OF UNDERGROUND SERVICES/FEATURES IS STATED. DEPTHS ARE GENERALLY WITHIN +/- 10% ACCURATE, BUT CANNOT BE GUARANTEED. ANY DEPTHS SHOWN ARE USUALLY TO THE TOP OF THE SERVICE/FEATURE. GRAVITY SEWERS AND DRAINS ARE USUALLY TO INVERT (BASE OF DRAINAGE CHANNEL) UNLESS OTHERWISE STATED.

AT N D OLIVER & CO LTD WE USE SKILLED STAFF AND MODERN CALIBRATED EQUIPMENT TO PERFORM OUR SURVEYS. HOWEVER, THE COMPLETENESS OF ANY UNDERGROUND SURVEY CANNOT BE 100% GUARANTEED AND WE CANNOT BE HELD RESPONSIBLE FOR ANY INACCURACIES BEYOND THOSE THAT COULD BE REASONABLY EXPECTED BY A COMPETENT COMPANY.

CONTRACTORS UTILISING OUR DRAWINGS FOR INTRUSIVE WORK SHOULD TAKE ALL REASONABLE MEASURES TO WORK SAFELY IN ACCORDANCE WITH HSG47 GUIDELINES "AVOIDING DANGER FROM UNDERGROUND SERVICES".

Rev	Date	Drawn	Description	Ch'k'd	App'd
C	09.06.25	NDO/AUL	Survey Area Expanded	AM	NDO

N D OLIVER & CO
CHARTERED GEOMATIC SURVEYORS
Jupiter House, 21 Roebuck Lane, Sale, Manchester, M33 7SY
T: 0161 973 3495 F: 0161 962 6819
E: mail@ndoliver.com www.ndoliver.com

Client

WALKER SIME LTD
THE CORNERHOUSE
FOURTH AVENUE
TRAFFORD PARK
MANCHESTER, M14 7DB

Title

WYTHENSHAWE CIVIC CENTRE
WYTHENSHAWE
M22 5RQ

TOPOGRAPHICAL & UTILITIES SURVEY
SHEET 5 OF 10

Surveyed	PG/HS/OB	Drawn	HS/PK/OB	Drawn Date: 30/04/2025
Checked	AM	Approved	NDO	
Scale: 1:200 @ A1		Project: 13162	CAD File: P:\13162\DRAWINGS\13162_001C.DWG	Status: REV
Drawing No: 13162 / 001C / 5				Rev: C

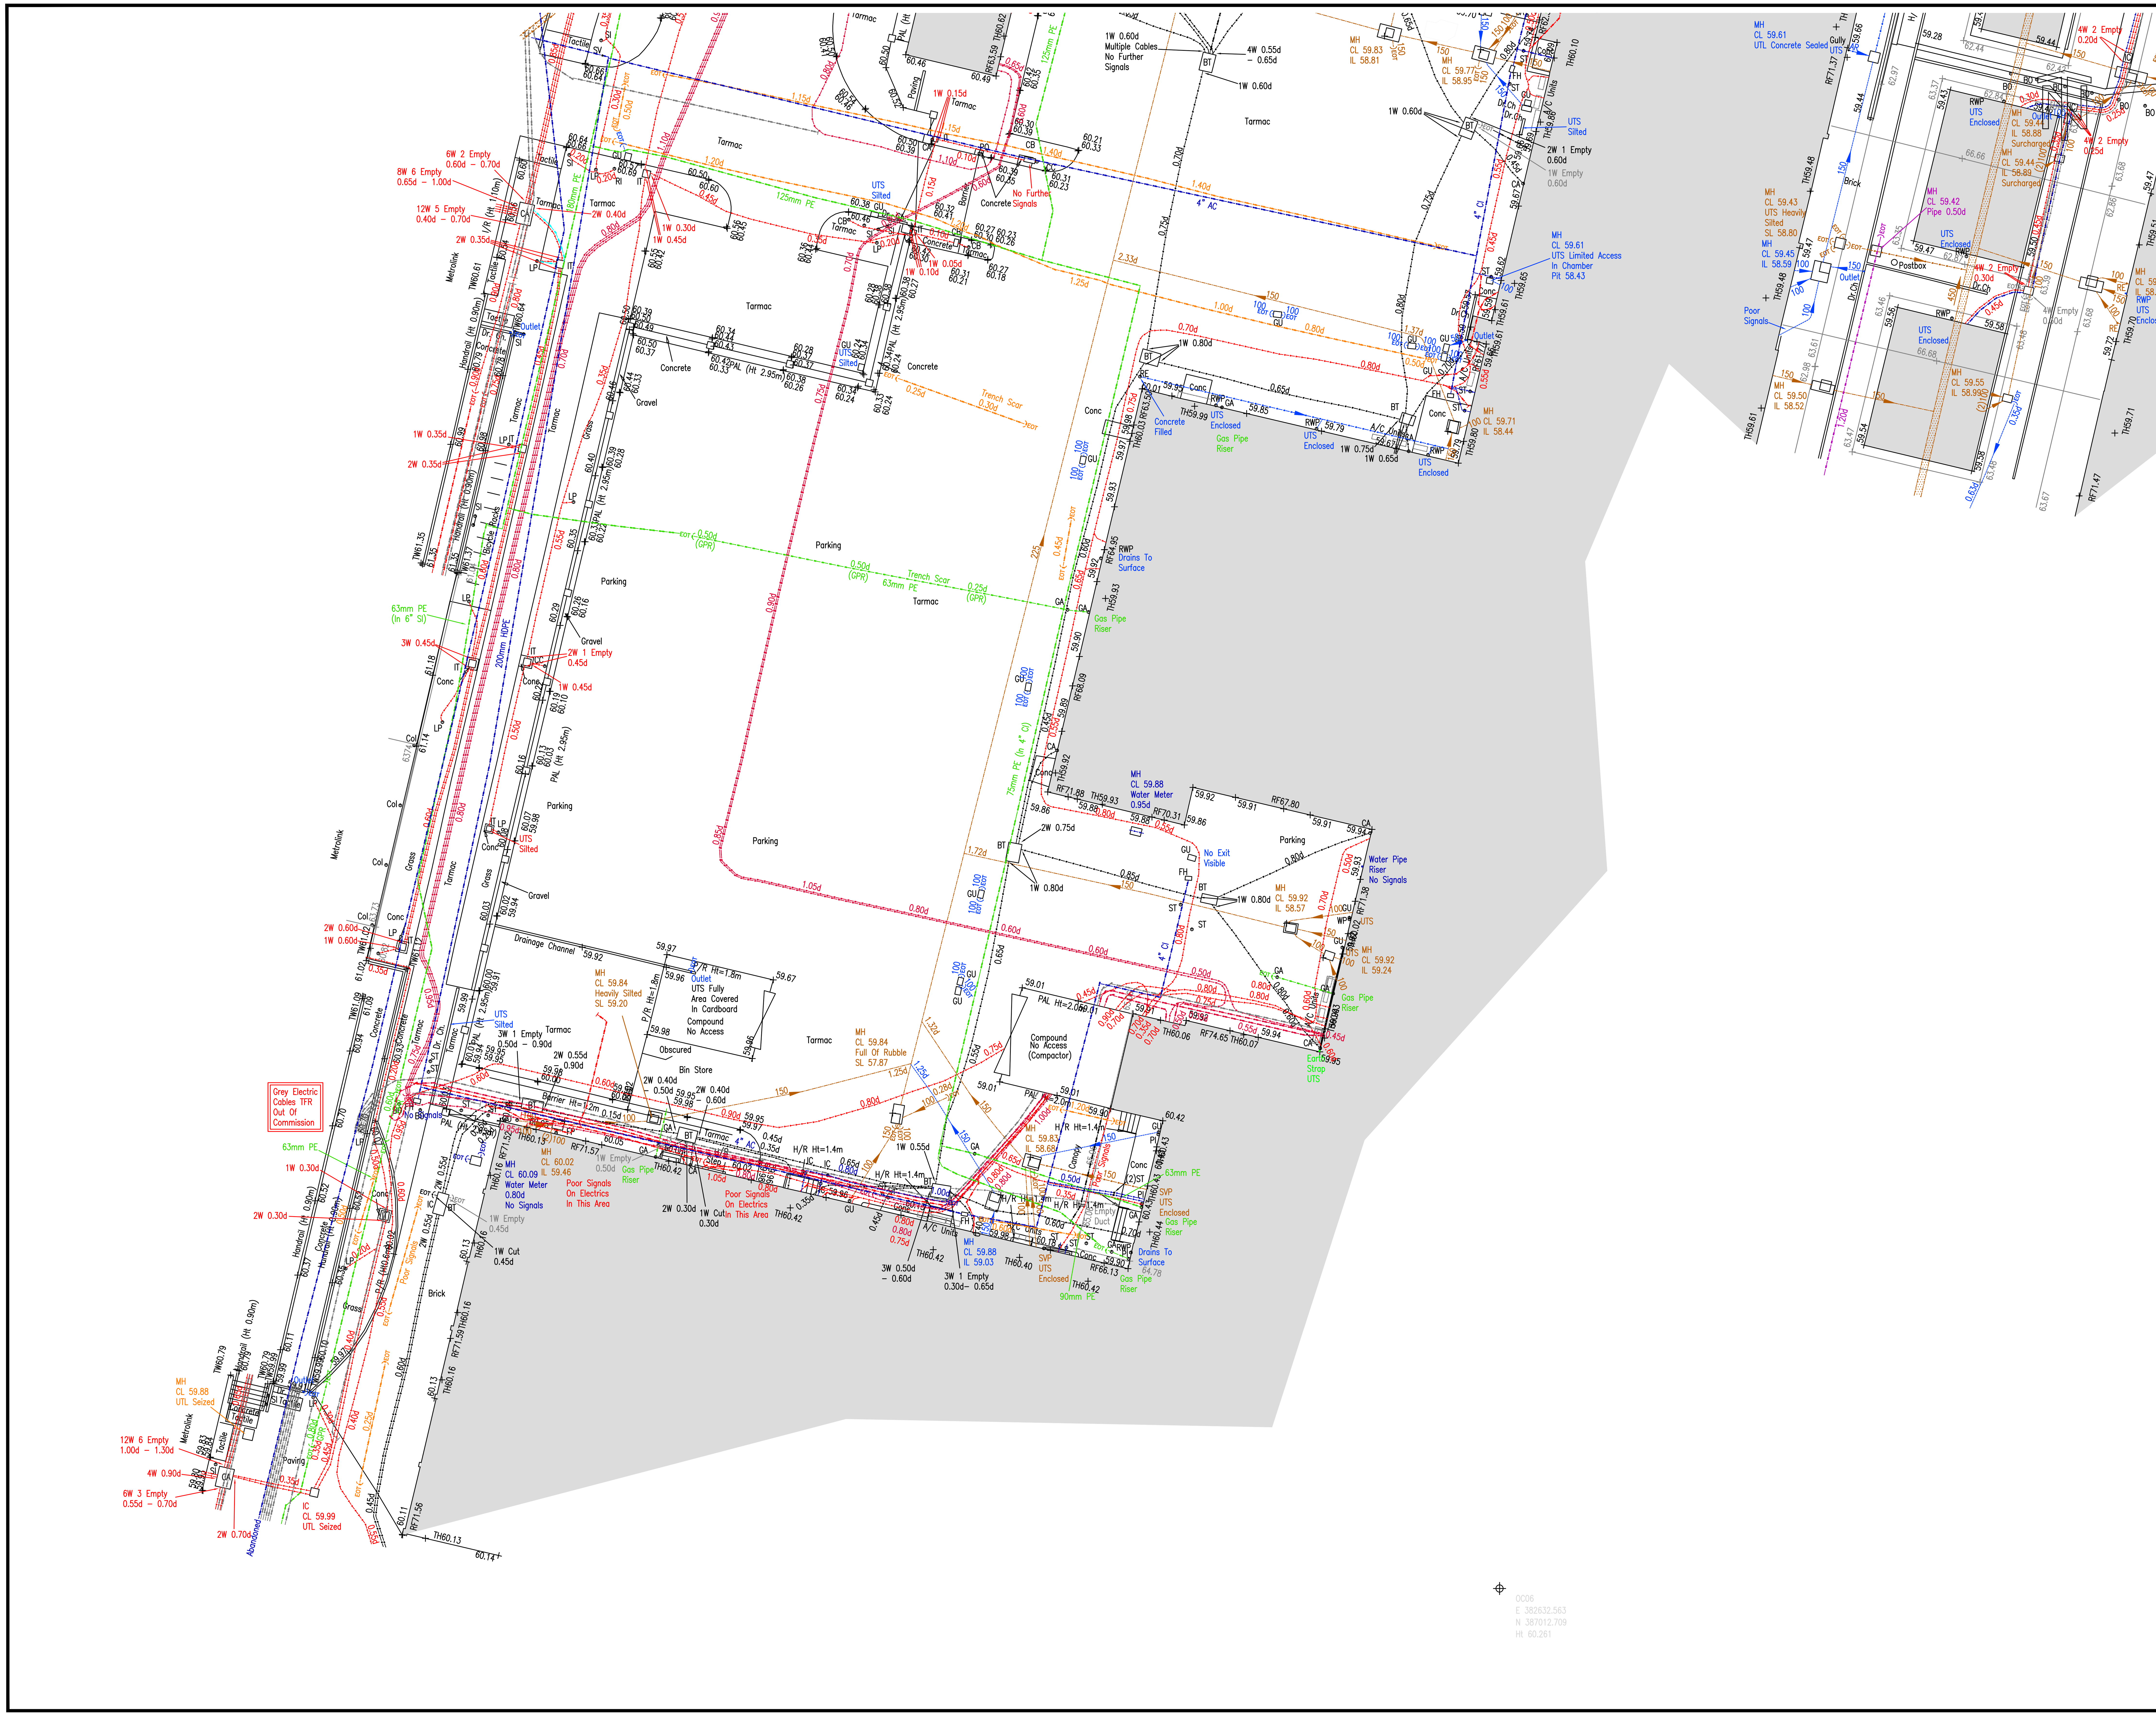

NOTES

KEY

Grid & Datum - Local Plane Grid related to OS National Grid & Datum By GNSS RTK Observations

STANDARD ABBREVIATIONS

STREET FURNITURE

A/C - AIR CONDITIONING
AE - AERIAL
AL - ALARM
AV - AIR VALVE
BA - BUOYANCY AID
BB - BELISHA BEACON
BD - BUILDING DIVIDE
BH - BOREHOLE
BI - BOLLARD ILLUMINATED
BL - BASEMENT LIGHT
BO - BOLLARD
BP - BOUNDARY POST
BR - BOULDER
BS - BUS STOP
BU - BUSH
CA - CABLE
CB - CONTROL BOX
CC - CLOSE CIRCUIT TV
CIB - CIGARETTE BIN
Col - COLUMN
CT - CLOSE CIRCUIT TV POLE
DP - DOWN PIPE
DR - DRAIN
Dr.Ch - DRAINAGE CHANNEL
DU - DUCT
EL - ELECTRIC
EP - ELECTRICITY POLE
ER - EARTH ROD
FA - FENDOR ANCHOR
F/B - FLOWER BED
FH - FIRE HYDRANT
FL - FLOODLIGHT
FS - FLAG STAFF
GA - GAS
GM - GAS METER
G - GIRTH
GP - GATE POST
GU - GULLY
GV - GAS VALVE
Hyd - HYDRANT
IC - INSPECTION COVER
IT - TRAFFIC COVER
JB - JUNCTION BOX
KO - KERB OFFLET
LA - LADDER
LB - LITTER BIN
LC - LIGHTING COLUMN
LI - LIGHT
LP - LAMP POST
MBO - MOORING BOLLARD
MA - MAST
MH - MANHOLE
MO - MONUMENT
MP - MILE POST
MR - MOORING RING
MW - MONITORING WELL
NP - NAME PLATE
O/H - OVERHEAD
OSBM - ORDNANCE SURVEY BENCH MARK
PA - PLAY APPARATUS
PB - PILLAR BOX
PH - PUBLIC HOUSE
PI - PIPE
PL - PLANT
PM - PARKING METER
PN - PLANTER
PO - POST
PP - PETROL PUMP
RH - RIDGE HEIGHT
RS - ROAD SIGN
RI - ROAD SIGN ILLUMINATED
RTW - RETAINING WALL
RWP - RAINWATER PIPE
SA - STANCHION
SC - SPEED CAMERA
SD - SATELITTE DISH
S/F - SAFETY FENCE
SG - SIGNAL
SI - SIGN
SI - SIGN ILLUMINATED
SMP - SERVICE MARKER POST
SS - SECURITY SENSOR
ST - STOP TAP
SU - STUMP
SV - STOP VALVE
SW - SWITCHGEAR
SY - STAY
TA - TAP
TBM - TEMPORARY BENCH MARK
TCB - TELEPHONE CALL BOX
TE - TELEPHONE
TM - TICKET MACHINE
TS - TRAFFIC SIGNAL
TP - TELEGRAPH POLE
UTL - UNABLE TO LIFT
VDP - VEHICLE DETECTOR PAD
VP - VENT PIPE
WB - WHISTLE BLOW
WM - WATER METER
WO - WASH OUT
WP - WASTE PIPE

FENCE TYPES

B/W - BARBED WIRE
C/B - CLOSE BOARDED
C/I - CORRUGATED IRON
C/P - CONCRETE PANEL
H/R - HANDRAIL
I/R - IRON RAILING
PAL - PALISADE
P/C - POST & CHAIN
P/P - POST & PANEL
P/R - POST & RAIL
PSB - PEDESTRIAN SAFETY BARRIER
P/W - POST & WIRE
W/M - WIRE MESH

LEVELS

BL43.45 - BED LEVEL
EV43.45 - EAVE LEVEL
IL43.45 - INVERT LEVEL
43.45 - SPOT LEVEL
RF43.45 - ROOF LEVEL
RL43.45 - RIDGE LEVEL
SB43.45 - SOFT BED LEVEL
SL43.45 - SOFFIT LEVEL
TH43.45 - THRESHOLD LEVEL
WL43.45 - WATER LEVEL

SYMBOLS

HEDGE; GATE; BUILDING; TREE CANOPY; CONTROL STATION; EMBANKMENT; TREE; BUSH

SHEET LAYOUT

001 / 1; 001 / 2; 001 / 3; 001 / 4; 001 / 5; 001 / 6; 001 / 7; 001 / 8; 001 / 9; 001 / 10

UNDERGROUND SERVICE KEY

Service	Symbol	Service	Symbol
Foul/Combined water drain		Vents	V
Foul/Combined drain 300Ø and above		Fuel	F
Surface water drain		Offsets	O
Surface water drain 300Ø and above		Vapour Recovery	VR
Combined Water Drain		Gauge Lines	G
Surface water drain 300Ø and above		Unidentified GPR	U-GPR
End of trace	EOT	Unidentified EML	U-EML
Electric cables	E	Taken From Records	E-TFR
HV cables	HV	Assumed Routes	
Gas	GAS	Empty Ducts	ED
Water	W	Earth Rod	ER
Telephone	BT	Rising Main	RM
Catv	CATV	Overhead	O/H
CCTV	CCTV	Heating Pipes	HP
Comms	COM	Traffic Signals	TS
Fibre Optics	FO	Multi User	MU
Pipe	PIPE	Trench Scar	
		Service Duct	

Where chamber extents are significantly greater than the cover size, their approximate extents are shown thus;

ABBREVIATION KEY

AR assumed route
BD base bend
BD backdrop
CP cable pit
CL cover level
CR cable riser
DP down pipe
EBD external back drop
EOT end of trace
EP electricity pole
FH fire hydrant
FL flooded
G gully
GV gas valve
HOR head of run
HL high level
IC inspection chamber
IBD internal back drop
IL invert level
MH manhole
PL pit level
PR pipe riser
RE rodding eye
RWP rainwater pipe
SIL silted
SL silt level
SV stop valve
SVP soil vent pipe
TE trapped exit
TFR taken from records
TP telegraph pole
UDO unable to determine outfall
UTF unable to find
UTL unable to lift
UTS unable to survey
UTT unable to trace
VP vent pipe
WL water level
WM water meter
WO wash out valve

UTILITY SURVEY NOTES

ELECTROMAGNETIC AND/OR GROUND PENETRATING RADAR TECHNIQUES HAVE BEEN USED TO LOCATE AND MAP UNDERGROUND UTILITIES AND FEATURES ON THIS DRAWING. N D OLIVER & CO LTD HAVE MADE EVERY ENDEAVOUR TO MAKE SURE THAT THE INFORMATION CONTAINED WITHIN THIS DRAWING IS ACCURATE AND OF THE HIGHEST QUALITY. HOWEVER, THE RESULTS FROM THESE TYPES OF SURVEYS ARE NOT INFALLIBLE AND SHOULD THE LOCATION OR DEPTH OF SERVICES/FEATURES BE OF PARTICULAR IMPORTANCE TO A PROJECT, THEN IT IS STRONGLY ADVISED THAT TRIAL EXCAVATIONS SHOULD BE UNDERTAKEN TO CONFIRM SURVEY RESULTS.

N D OLIVER & CO LTD HAVE USED ALL RECORD DRAWINGS THAT WERE AVAILABLE TO US BY THE CLIENT OR BY THE STATUTORY UTILITY PROVIDERS AT THE TIME OF THE SURVEY. ANY INFORMATION TAKEN FROM THESE DRAWINGS (IE PIPE SIZES, MATERIAL) IS NOT GUARANTEED. SERVICES LOCATED FROM RECORD DRAWINGS WILL BE SHOWN AND ANNOTATED AS TAKEN FROM RECORDS (TFR). HISTORIC RECORD INFORMATION IS OFTEN INCOMPLETE/INACCURATE AND CANNOT BE RELIED UPON.

A SINGLE LINE INDICATING A UTILITY MAY INDICATE THE PRESENCE OF MULTIPLE SERVICES WITHIN CLOSE PROXIMITY TO EACH OTHER. WHERE A SINGLE LINE TYPE IS SHOWN WE RECOMMEND HAND DIGGING WITHIN 0.5m, TO EXPOSE HIDDEN SERVICES.

WHERE QUOTED, DEPTH INFORMATION OF UNDERGROUND SERVICES/FEATURES IS STATED. DEPTHS ARE GENERALLY WITHIN +/- 10% ACCURATE, BUT CANNOT BE GUARANTEED. ANY DEPTHS SHOWN ARE USUALLY TO THE TOP OF THE SERVICE/FEATURE. GRAVITY SEWERS AND DRAINS ARE USUALLY TO INVERT (BASE OF DRAINAGE CHANNEL) UNLESS OTHERWISE STATED.

AT N D OLIVER & CO LTD WE USE SKILLED STAFF AND MODERN CALIBRATED EQUIPMENT TO PERFORM OUR SURVEYS. HOWEVER, THE COMPLETENESS OF ANY UNDERGROUND SURVEY CANNOT BE 100% GUARANTEED AND WE CANNOT BE HELD RESPONSIBLE FOR ANY INACCURACIES BEYOND THOSE THAT COULD BE REASONABLY EXPECTED BY A COMPETENT COMPANY.

CONTRACTORS UTILISING OUR DRAWINGS FOR INTRUSIVE WORK SHOULD TAKE ALL REASONABLE MEASURES TO WORK SAFELY IN ACCORDANCE WITH HSG47 GUIDELINES "AVOIDING DANGER FROM UNDERGROUND SERVICES".

Rev	Date	Drawn	Description	Ch'k'd	App'd
C	09.06.25	NDO/AUL	Survey Area Expanded	AM	NDO

N D OLIVER & CO
CHARTERED GEOMATIC SURVEYORS
Jupiter House, 21 Roebuck Lane, Sale, Manchester, M33 7SY
T: 0161 973 3495 F: 0161 962 6819
E: mail@ndoliver.com www.ndoliver.com

Client

WALKER SIME LTD
THE CORNERHOUSE
FOURTH AVENUE
TRAFFORD PARK
MANCHESTER, M14 7DB

Title

WYTHENSHAWE CIVIC CENTRE
WYTHENSHAWE
M22 5RQ

TOPOGRAPHICAL & UTILITIES SURVEY
SHEET 8 OF 10

Surveyed	PG/HS/OB	Drawn	HS/PK/OB	Drawn Date: 30/04/2025
Checked	AM	Approved	NDO	
Scale: 1:200 @ A1	Project: 13162	CAD File: P:\13162\DRAWINGS\13162_001C.DWG		Status: REV
Drawing No: 13162 / 001C / 8				Rev: C