




862 Kingsway

1 Gasworth Ave

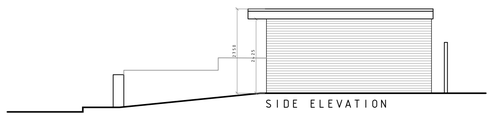

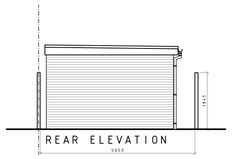

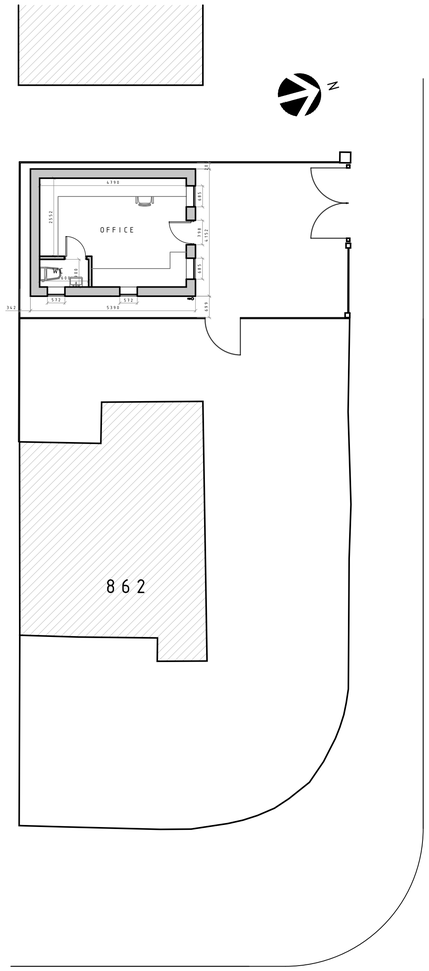


GAWSWORTH AVENUE


KINGSWAY

SITE PLAN

GROUND FLOOR PLAN

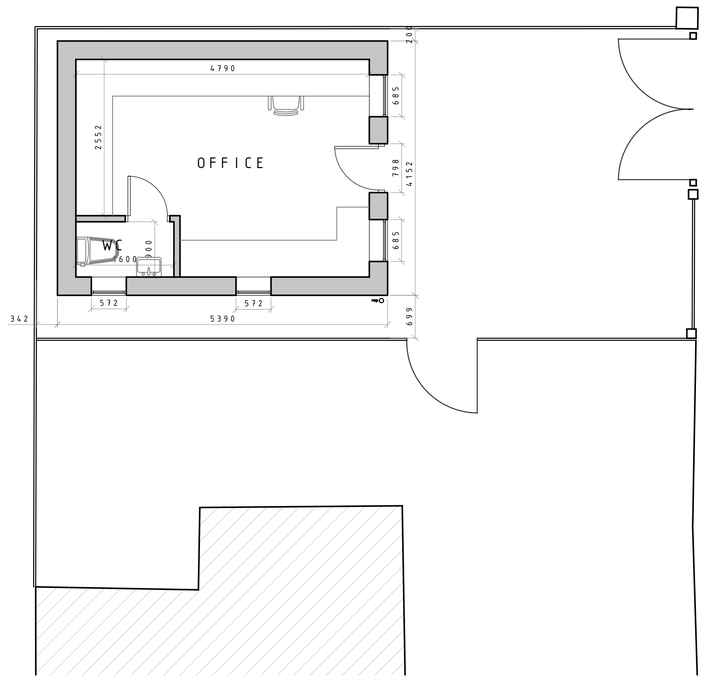

ROOF PLAN

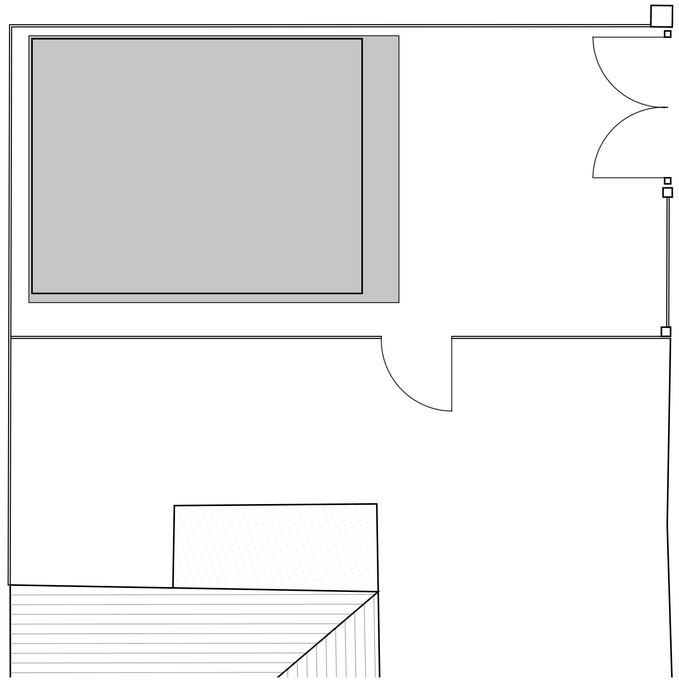

0 1 2m
SCALE 1:50

0 5m
SCALE 1:100

A FIRST ISSUE	-	23.04.26
AMENDMENTS	I	DATE

ADDRESS
862 KINGSWAY
MANCHESTER
M20 5WG

SUBJECT
GARDEN BUILDING
AS BUILT PLANS AND ELEVATIONS

CLIENT
MR M.KHAN

DATE 23.04.2026
SCALE 1:50 - PLANS
1:100 - ELEVS
1:100 - SITE

JOB No. 2604

DRG No. 02

AMENDMENT A