

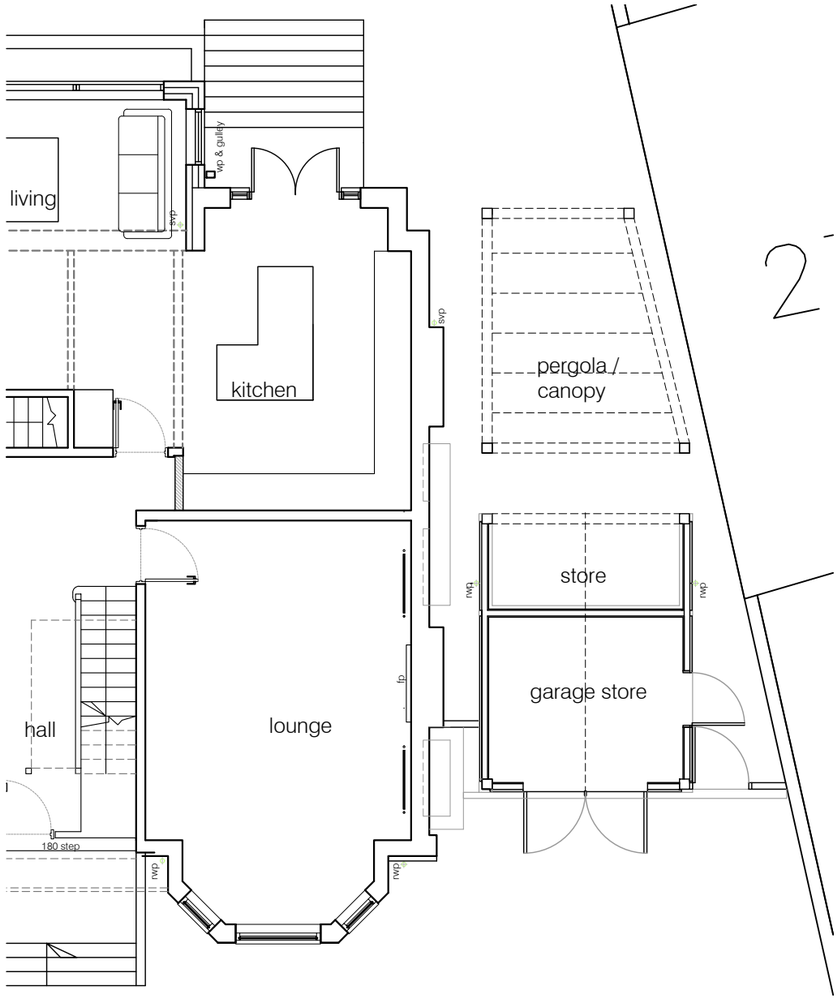



GROUND FLOOR PLAN

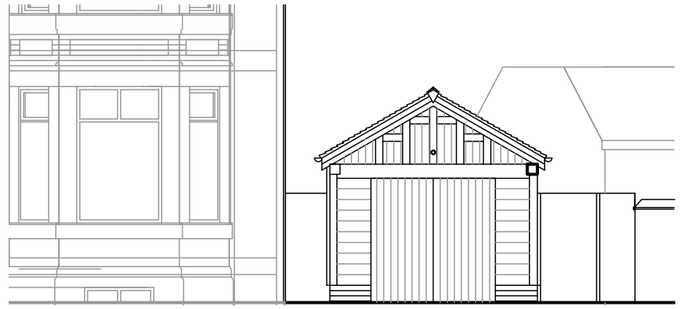


Front elevation facing road

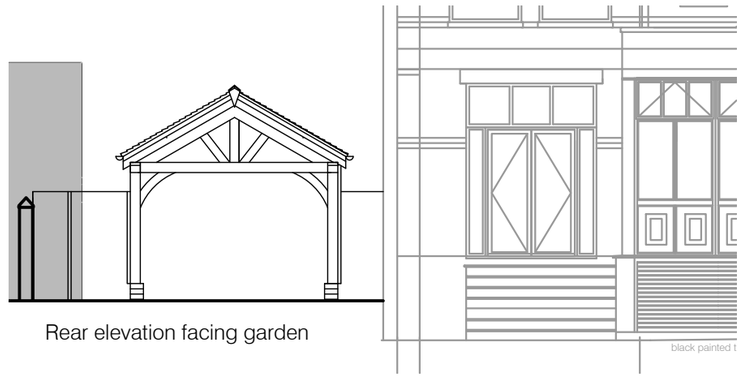


Rear elevation facing garden

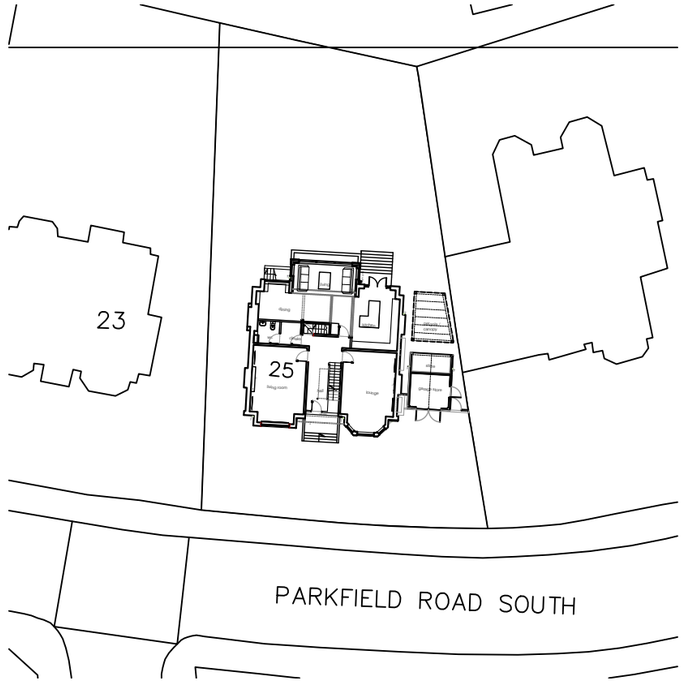

BLOCK PLAN 1:500

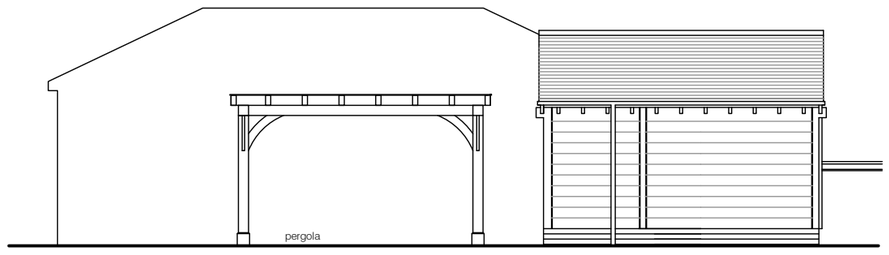

Side elevation facing house

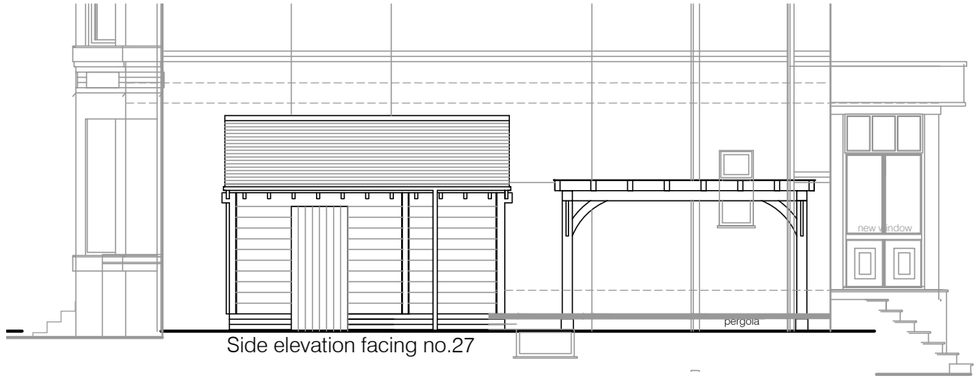

Side elevation facing no.27

New Garage external materials:
Clay tile pitched roof as main house
Black painted horizontal lapped timber boarding and solid timber posts to walls
Black painted vertically boarded timber doors
White render/black painted timber gable
Blue engineering plinth level brickwork
Black painted timber fascias, rafter feet, bargeboards
Black upvc rainwater goods

Simon R Miles
Chartered Architect
Didsbury
Manchester
T: 07778 137830
E: srmilesarchitect@gmail.com

Do not scale. Contractors must check all dimensions on site before preparing production drawings or commencing any work. This drawing and its design is the copyright of S.R.Miles Ltd and may not be reproduced in any form whatsoever without their prior express written consent.

Revision Date Revision note

Notes

Project :
25 Parkfield Road South Didsbury

Title :
As Built Garage - Plans and elevations

Drawing number : Issue :
26n 537 PL100

Client :
Mr & Mrs McDonald

Scale :
500,100@A3

Date :
11.05.2026

CAD Ref :
26 537

Drawn by :
SRM

SRM
Simon R Miles BA Hons Dip Arch RIBA
Chartered Architect