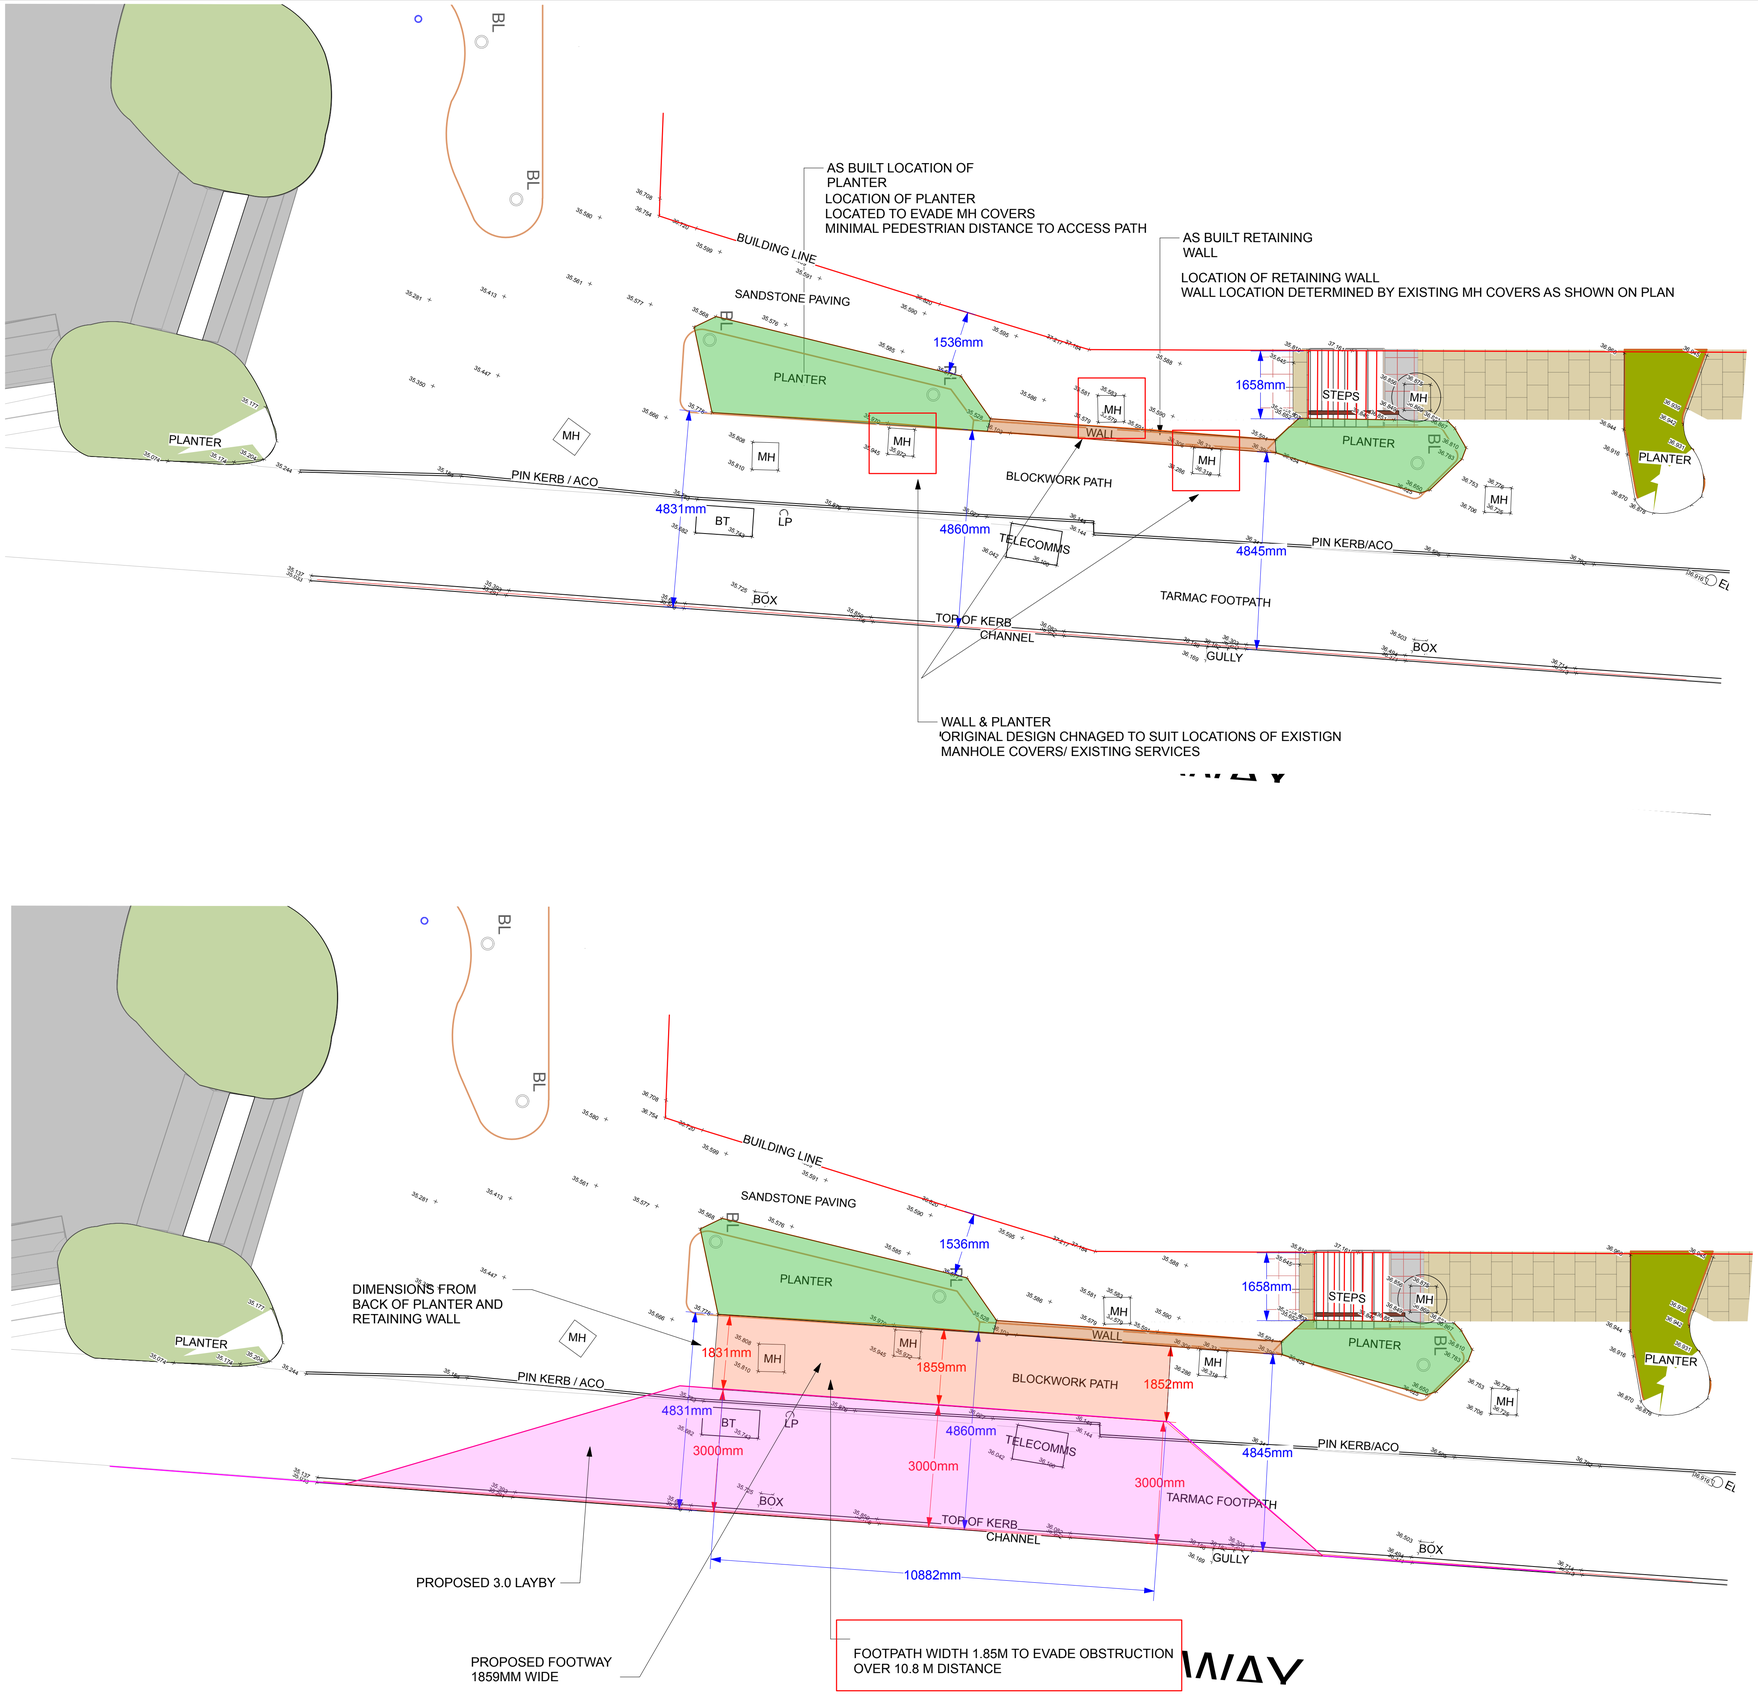


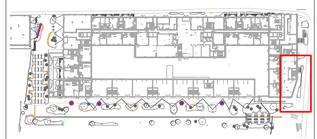

1 Location Plan
Scale: 1:75

No dimensions are to be scaled from this drawing. All dimensions are to be checked on site.
Area measurements for indicative purposes only.

This drawing is the property of Wright Landscapes Limited. No part of the drawing may be reproduced in any manner without permission from Wright Landscapes Limited.

All Wright Landscapes drawings to read in conjuction with architectual / engineers plans & details.

LOCATION PLAN



| Revision | Date | Description | Drawn | Approved |
|---|---|---|---|---|
| S5-P02 | 02:02:26 | AS BUILT SURVEY INFO ADDED | SB | NW |
| S5-P01 | 28:01:26 | First Issue - For Information | SB | NW |

**WRIGHT LANDSCAPES LIMITED**

**E**: info@wrightlandscapes.co.uk
**W**: www.wrightlandscapes.co.uk
**T**: 01244 541959

**HEAD OFFICE**
Pickmere Lane, Pickmere, Knutsford,
WA16 0JL

| | |
|---|---|
| **CLIENT** | DOMIS CONSTRUCTION |
| **PROJECT** | WATERHOUSE GARDENS |
| **DRAWING TITLE** | TRINITY WAY LAYBY - AS BUILT PLANTER |

| | |
|---|---|
| **DATE** 28/01/2026 | **SCALE** AS NOTED |
| **DRAWN** SB | **SIZE** A1 |
| **APPROVED** NW | **WORKSTAGE** Stage 5 |

**DRAWING NUMBER** 1174-WRI-XX-XX-DR-L-5032 **SUITABILITY** S5 **REVISION** P02

© Wright Landscapes Limited