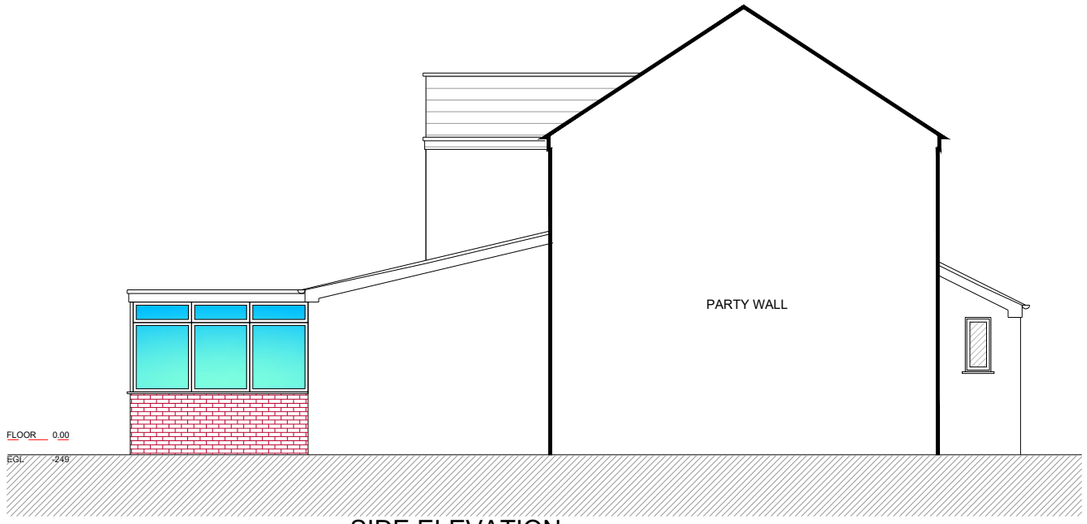


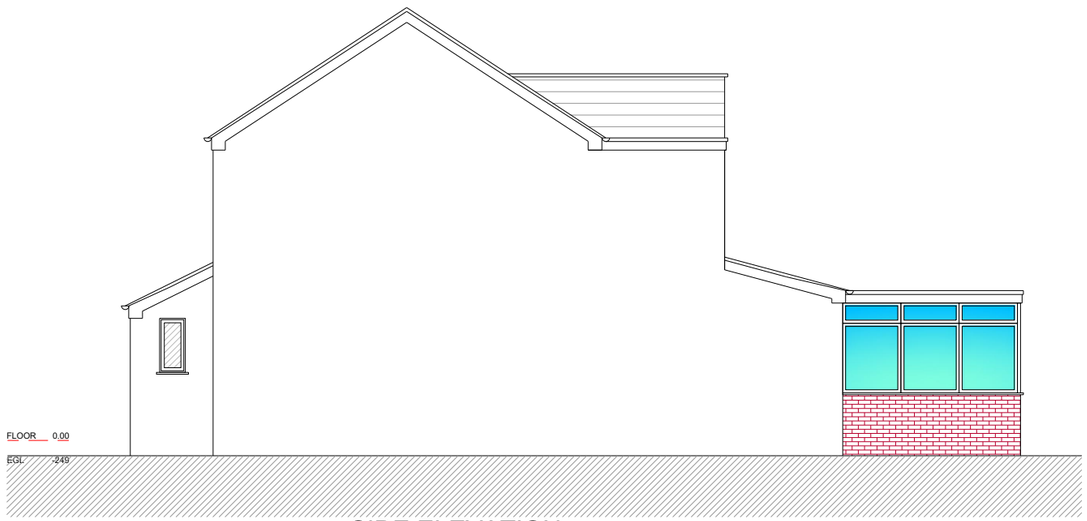

FRONT ELEVATION




SIDE ELEVATION




REAR ELEVATION




SIDE ELEVATION

1:100

2m 0 2m 4m 6m 8m 10m

PROJECT REF
26068

DRAWING REF
PROPOSED ELEVATIONS (AS BUILT)

SCALE
1:100 @ A3

DATE
MAY '26

07854 885578
design@platinumarchitecture.co.uk
www.platinumarchitecture.co.uk
6 Derwent Avenue ⋮ Timperley ⋮ Altrincham ⋮ WA15 7JB

CLIENT
MR Y MOHOTTALA,
48 TOPFIELD ROAD,
WYTHENSHAWE,
M22 9QN

PROJECT
RETROSPECTIVE APPLICATION
FOR REAR CONSERVATORY

DRAWING TITLE
PROPOSED ELEVATIONS
(AS BUILT)

| | | |
|---|---|---|
| - | ISSUED FOR CLIENT COMMENT | 18.05.2026 |

07854 885578
design@platinumarchitecture.co.uk
www.platinumarchitecture.co.uk
6 Derwent Avenue ⋮ Timperley ⋮ Altrincham ⋮ WA15 7JB