

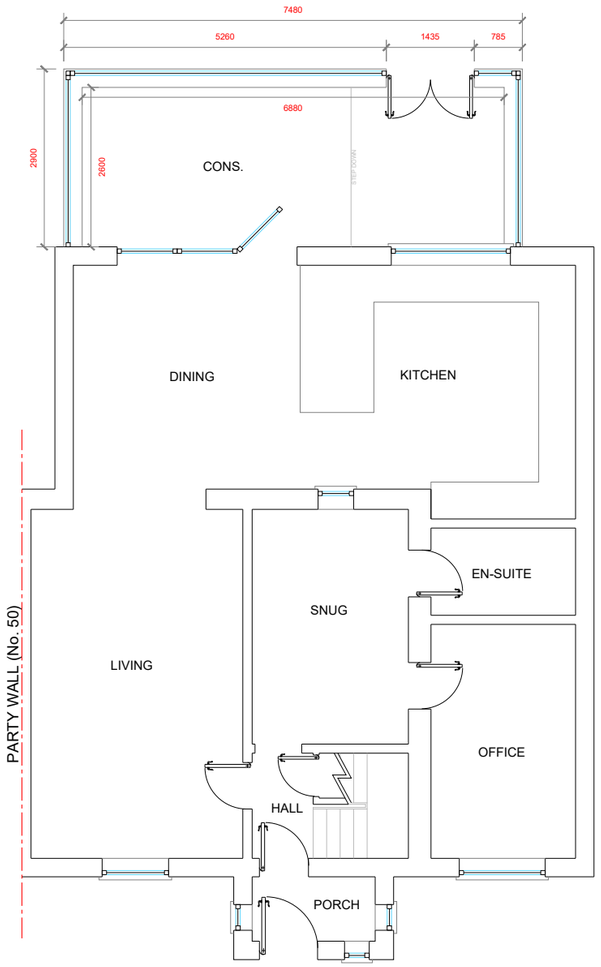


GROUND FLOOR

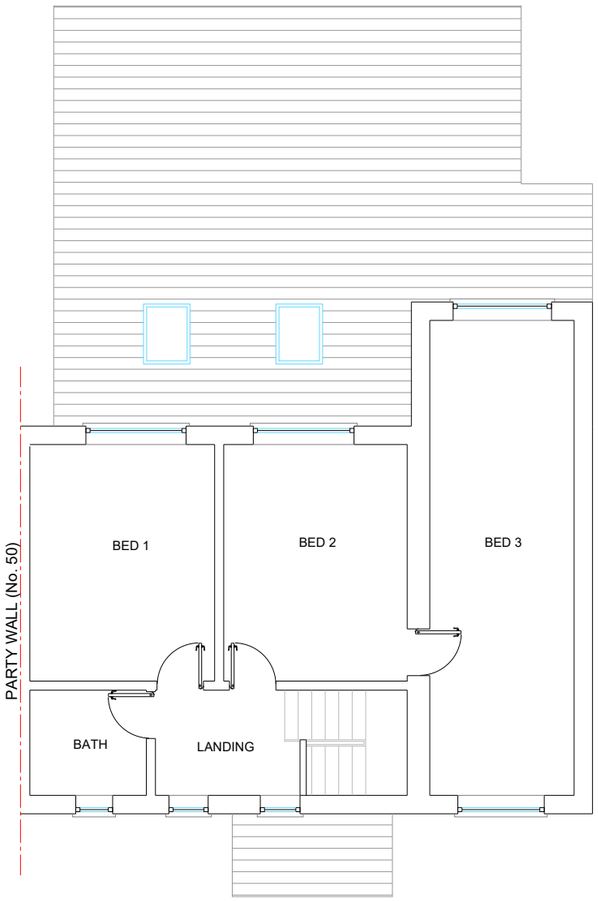

FIRST FLOOR

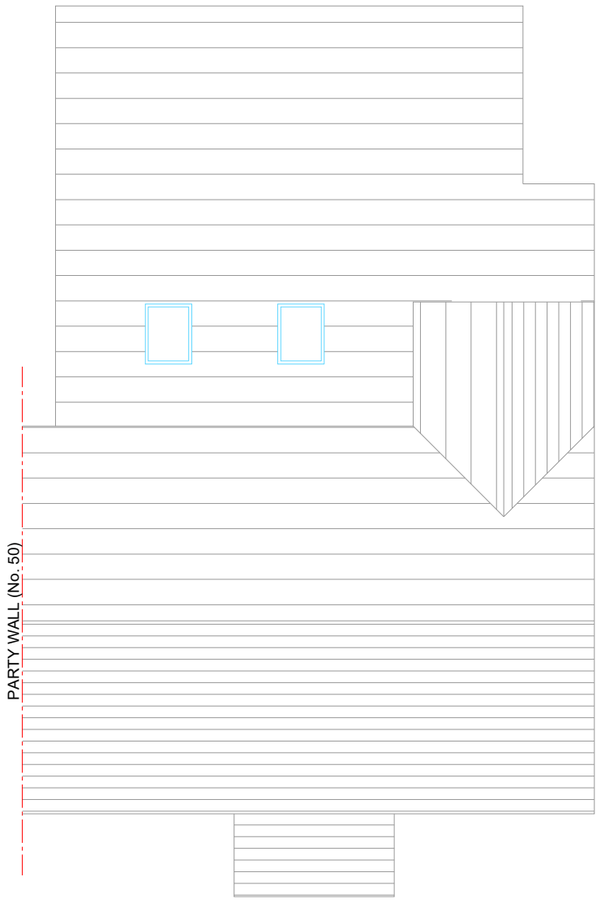

ROOF PLAN

1:100

2m 0 2m 4m 6m 8m 10m

PROJECT REF
26068

DRAWING REF
PROPOSED FLOOR PLANS (AS BUILT)

SCALE
1:100 @ A3

DATE
MAY '26

07854 885578
design@platinumarchitecture.co.uk
www.platinumarchitecture.co.uk
6 Derwent Avenue | Timperley | Altrincham | WA15 7JB

CLIENT
MR Y MOHOTTALA,
48 TOPFIELD ROAD,
WYTHENSHAWE,
M22 9QN

PROJECT
RETROSPECTIVE APPLICATION FOR REAR CONSERVATORY

DRAWING TITLE
PROPOSED FLOOR PLANS (AS BUILT)

-	ISSUED FOR CLIENT COMMENT	18.05.2026

07854 885578
design@platinumarchitecture.co.uk
www.platinumarchitecture.co.uk
6 Derwent Avenue | Timperley | Altrincham | WA15 7JB