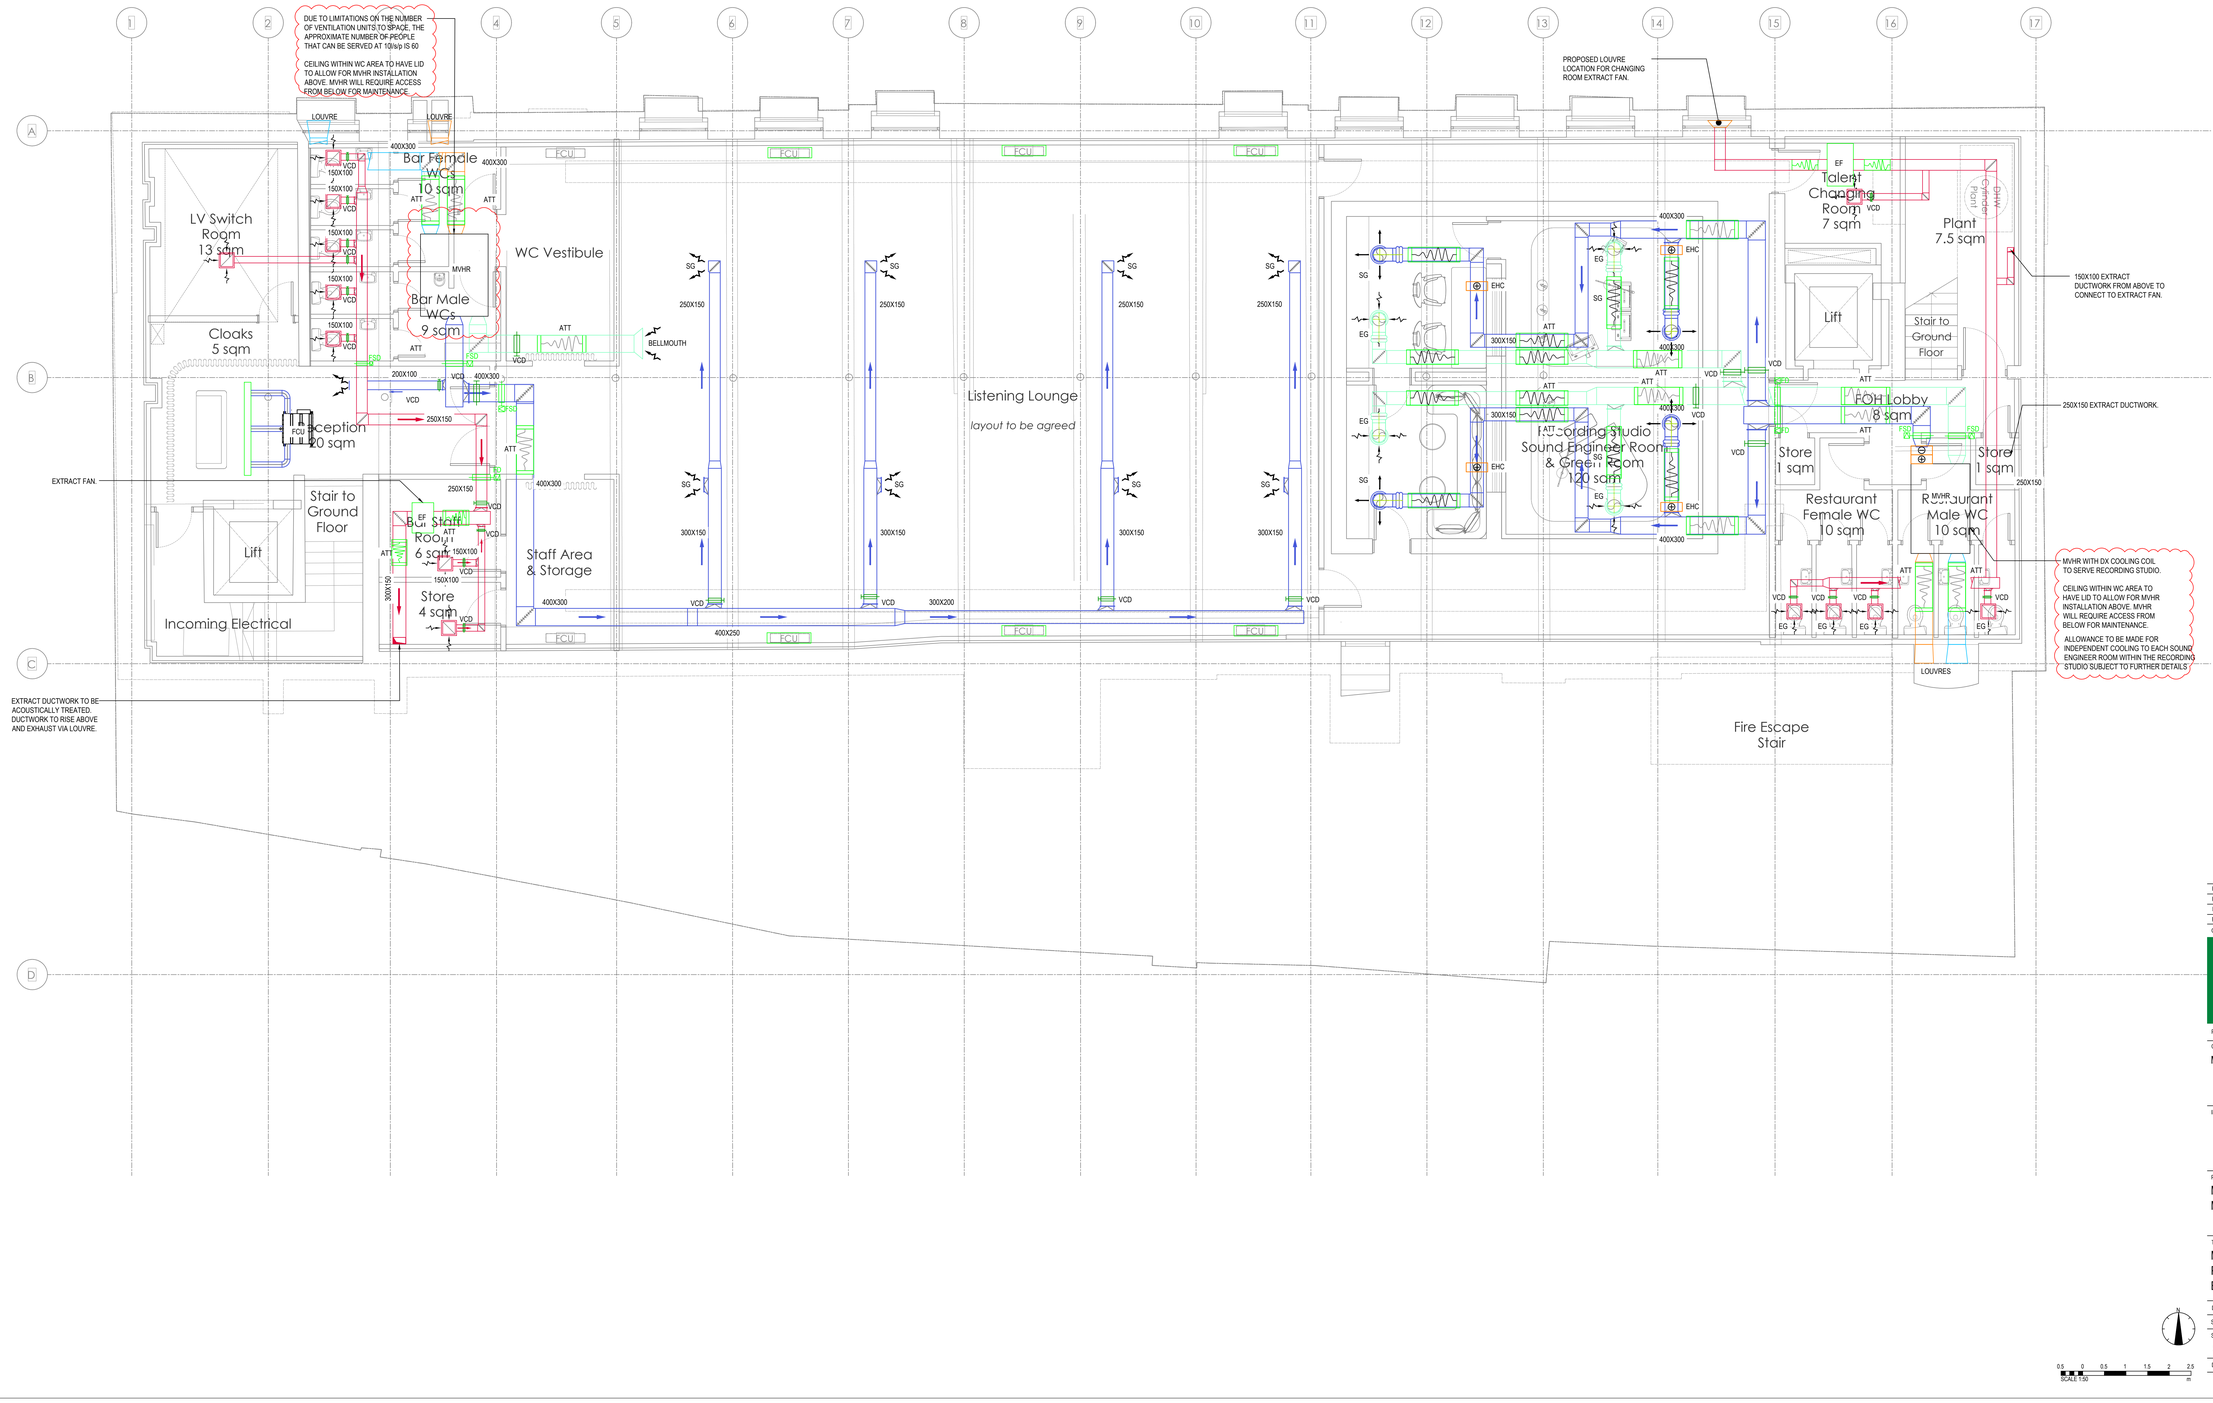


DISCLAIMER NOTES:

- THIS DOCUMENT IS COPYRIGHT OF THE ORIGINATOR AND MUST BE TREATED AS CONFIDENTIAL
- THIS DOCUMENT MUST NOT BE ALTERED, REPRODUCED OR DISTRIBUTED WITHOUT PRIOR WRITTEN CONSENT OF THE ORIGINATOR
- THIS DOCUMENT MUST NOT BE ALTERED - THE ORIGINATOR ACCEPTS NO RESPONSIBILITY FOR ANY DISCREPANCIES ARISING AS A RESULT OF THE ORIGINATORS INFORMATION BEING ALTERED BY OTHERS.
- ANY DISCREPANCY MUST BE REPORTED TO THE ORIGINATOR
- DO NOT SCALE THIS DOCUMENT - USE FIGURED DIMENSIONS ONLY
- ALL DIMENSIONS MUST BE CHECKED ON SITE PRIOR TO COMMENCEMENT OF ANY RELATED WORKS
- THIS DOCUMENT MUST BE READ IN CONJUNCTION WITH ALL SUPPORTING DOCUMENTS PRODUCED BY THE ORIGINATOR AND OTHER PROJECT DISCIPLINES
- THE ORIGINATOR ACCEPTS NO RESPONSIBILITY FOR THE ACCURACY OF BACKGROUND INFORMATION PRODUCED BY THIRD PARTIES - THIS MUST BE TREATED AS INDICATIVE ONLY
- USERS OF THIS DOCUMENT ARE RESPONSIBLE FOR CHECKING WHICH REVISION IS CURRENT
- THE DOCUMENT STATUS "INFORMATION" OR "PRELIMINARY", INDICATES THAT THIS DRAWING IS FOR REFERENCE PURPOSES ONLY - THE ORIGINATOR WILL ACCEPT NO RESPONSIBILITY FOR THE COMPLETENESS OF INFORMATION UNDER THIS STATUS
- THE DOCUMENT STATUS "RECORD" OR "AS BUILT" HAS BEEN PREPARED, IN PART, BASED UPON INFORMATION FURNISHED BY OTHERS. WHILE THIS INFORMATION IS BELIEVED TO BE RELIABLE, THE ORIGINATOR ASSUMES NO RESPONSIBILITY FOR THE ACCURACY OF THIS "RECORD" OR "AS BUILT" DOCUMENT OR FOR ANY ERRORS OR OMISSIONS THAT MAY HAVE BEEN INCORPORATED INTO IT AS A RESULT OF INCORRECT INFORMATION PROVIDED TO THE ORIGINATOR. THOSE RELYING ON THE "RECORD" OR "AS BUILT" DOCUMENT ARE ADVISED TO OBTAIN INDEPENDENT VERIFICATION OF ITS ACCURACY

DRAWING NOTES:

CDM REGULATIONS 2015
SIGNIFICANT OR NON-OBVIOUS RISKS AND RISKS WHICH ARE DIFFICULT TO MANAGE ARE IDENTIFIED ON THIS DRAWING USING THE FOLLOWING SYMBOL, IDENTIFIED TO THE RIGHT WITH BRIEF ACCOMPANYING TEXT. FOR FURTHER DETAILS OF THE RISKS IDENTIFIED BY DESIGNERS, REFERENCE SHOULD BE MADE TO CDM HAZARD REGISTER.

LEGEND

- EXTRACT GRILLE
- SUPPLY DIFFUSER
- LINEAR DIFFUSER
- FAN COIL UNIT
- HEAT RECOVERY VENTILATION UNIT
- CROSS TALK ATTENUATOR
- ACOUSTIC ATTENUATOR
- DUCTWORK DROPS TO BELOW
- DUCTWORK RISES TO ABOVE
- INTAKE AIR DUCTWORK
- EXHAUST AIR DUCTWORK
- SUPPLY AIR DUCTWORK
- RETURN AIR DUCTWORK
- TOILET / KITCHEN AIR DUCTWORK
- DX COOLING COIL
- ELECTRIC HEATER COIL (EHC)
- FIRE SMOKE DAMPER
- VOLUME CONTROL DAMPER
- EXTRACT FAN

REV	DESCRIPTION	DATE	BY	CHKD
P03	STAGE 3 ISSUE - UPDATED ARCHITECTS GA'S	26/05/2026	FC	MB
P02	STAGE 3 ISSUE	22/05/2026	FC	MB
P01	STAGE 3 ISSUE	12/05/2026	FC	MB

ORIGINATOR: www.ridge.co.uk

RIDGE

PROJECT NUMBER:

CLIENT:
MAKE DEVELOPMENTS

IN ASSOCIATION WITH:

PROJECT:
MARLSBRO HOUSE
MANCHESTER

TITLE:
MECHANICAL SERVICES
PROPOSED VENTILATION LAYOUT
BASEMENT

DRAWN BY: F.C. CHECKED BY: MB APPROVED BY: -

SCALE: 1:50 @ A0 DATE: 12/05/2026

STATUS: DESCRIPTION:
S3 SUITABLE FOR REVIEW/COMMENT

DRAWING No: 5031691-RDG-XX-B1-D-M-570000.dwg

PROJECT:	ORG	FUNCTION	SPATIAL	FORM	DISCIPLINE	NUMBER	REV
5031691	RDG	XX	00	D	M	570000	P03

0.5 0 0.5 1 1.5 2 2.5 m
SCALE 1:50