+well

MERCHANT'S QUAY, MANCHESTER

PARTITION & ABUTMENT DETAILS - 2 of 2


DO NOT SCALE DRAWING

GENERAL NOTES

1. All dimensions are in millimetres unless noted otherwise.
   No dimensions to be scaled off this drawing.
   All dimensions to be checked on site prior to ordering materials.


HORIZONTAL SECTION THROUGH GLAZED PARTITION

SECTION E
DOUBLE GLAZED / STRUCTURE
(TRIMMED ABUTMENT)

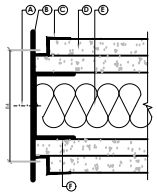


A: SUITABLE FIXINGS
B: EXISTING STRUCTURAL WALL
C: 12.5 x 10mm EDGE REVEAL PAINTED OUT WHITE
D: DOUBLE SKIN 12.5mm PLASTERBOARD
E: INSULATION
F: 50mm STEEL STUD

SECTION E
DOUBLE GLAZED / STRUCTURE
(TRIMMED ABUTMENT)

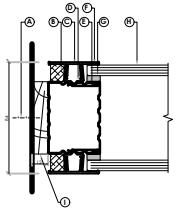


A: SUITABLE FIXINGS
B: 10876 MDF PACKING STRIP
C: SYA138 FLUSH PLAIN ALUMINIUM TRIM
D: SYS104M STUD AND CHANNEL
E: SYS105 STUD BOXING PLATE
F: 11856 FOAM SEAL
G: SYF10X6 FOAM SEAL
H: 6/8mm GLASS
(NOMINAL GLASS THICKNESS NOTED)
I: 12mm TIMBER BATTEN TO CREATE SHADOW DETAIL AT JUNCTION
(TO BE PAINTED OUT BLACK)

SECTION F
DOUBLE GLAZED / DOUBLE GLAZED

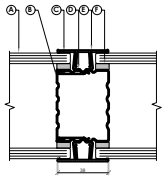


A: 6/8mm GLASS
(NOMINAL GLASS THICKNESS NOTED)
B: SYS105 STUD BOXING PLATE
C: 11856 FOAM SEAL
D: SYS104M STUD AND CHANNEL
E: SYA138 FLUSH PLAIN ALUMINIUM TRIM
F: SYF10X6 FOAM SEAL

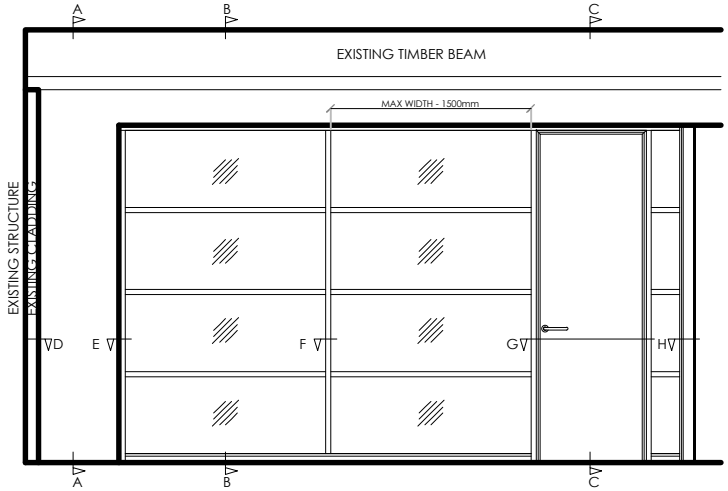


TYPICAL PARTITION ELEVATION
scale 1:20

SECTION G
SQUARE DOOR FRAME / DOUBLE GLAZED

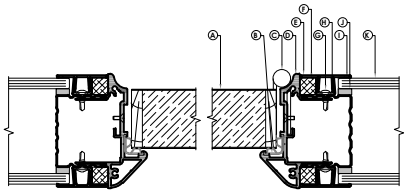


A: 44mm TIMBER DOOR
B: PTDS DOOR SEAL
C: HL103 HINGE
D: SYA10 DOOR FRAME
E: SYA138 FLUSH PLAIN ALUMINIUM TRIM
F: 10876 MDF PACKING STRIP
G: 13 x 4.2mm PAN HEAD SELF DRILLER
H: SYS104M STUD AND CHANNEL
I: 11856 FOAM SEAL
J: SYF10X6 FOAM SEAL
K: 6/8mm GLASS
(NOMINAL GLASS THICKNESS NOTED)

SECTION H

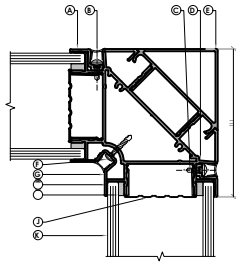


A: SYA21 PART OMEGA CORNER COVER TRIM
B: SYP15 FEATURE JOINT INSERT
C: 13 x 4.2mm PAN HEAD SELF DRILLER
D: [illegible]
E: SYA36 SQUARE CORNER/ END CAP
F: 25 x 3.5mm PAN HEAD SELF DRILLER
G: [illegible]
H: 11856 FOAM SEAL
I: SYF10X6 FOAM SEAL
J: SYS105 STUD BOXING PLATE
K: 6/8mm GLASS
(NOMINAL GLASS THICKNESS NOTED)

3-WAY GLAZING JUNCTION

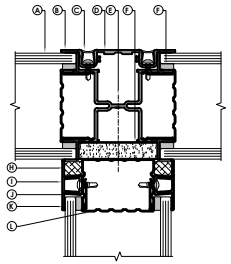

A: 6/8mm GLASS (NOMINAL GLASS THICKNESS NOTED)
B: SYA15 UNIVERSAL POST COVER PLATE
C: SYP15 FEATURE JOINT INSERT
D: SYA14 UNIVERSAL POST
E: SUITABLE FIXINGS
F: 59 x 12.5mm THICK PLASTERBOARD
G: SYF10X6 FOAM SEAL
H: 10876 MDF PACKING STRIP
I: SYA138 FLUSH PLAIN ALUMINIUM TRIM
J: SYS104 STUD AND CHANNEL
K: 11856 FOAM SEAL
L: SYS105 STUD BOXING PLATE

3-WAY GLAZING JUNCTION (WITH DOORS)

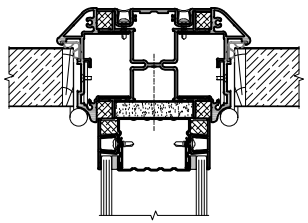



Rev	Date	Description	Drawn	Chk'd	App'd
P02	08.09.08	As built issue	RWT		

Client:
WELL PHARMACY

Project:
OFFICE RELOCATION
MERCHANTS WREHOUSE
MANCHESTER

Drawing Title:
LEVEL 3
PARTITION AND ABUTMENT 2OF2
AS BUILT

Scale (at A1): **1:20**
NIR Project No: **81400831**

NIRAS
ARCHITECTS

Project Contact: RISI @NIRAS.com
tel: +44 (0) 1509 670850

Status: **PLANNING** | Status: **S2**

Drawing No.: **400831-NIR-B01- 00 -DR-A-PT-11** | Rev.: **P02**

Copyright, Designs and Patents Act (1988)
This drawing must not be reproduced without the permission of NIRAS Group (UK) Ltd.