
+well

MERCHANT'S WAREHOUSE, MANCHESTER
LEVEL THREE - PARTITION ELEVATIONS


DO NOT SCALE DRAWING

GENERAL NOTES


1. All dimensions are in millimetres unless noted otherwise.
   No dimensions to be scaled off this drawing.
   All dimensions to be checked on site prior to ordering materials.

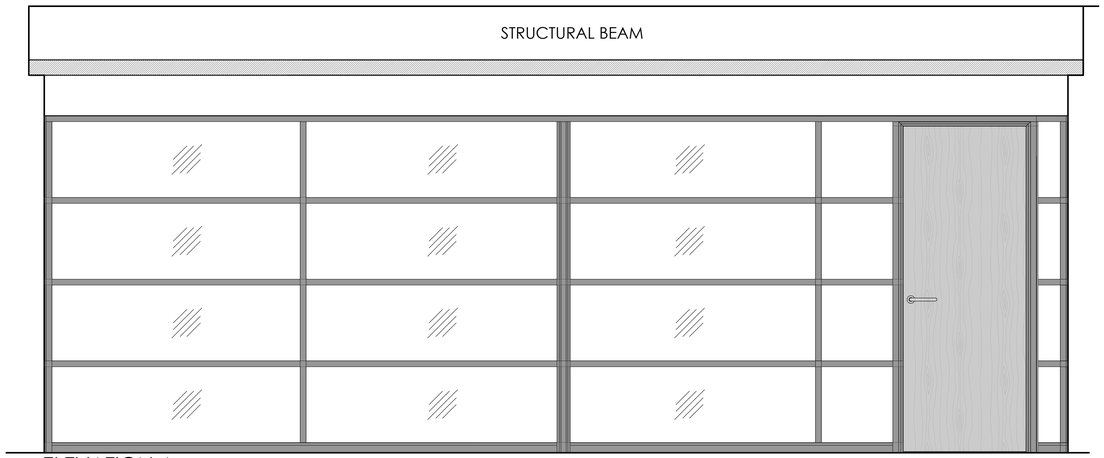


ELEVATION A

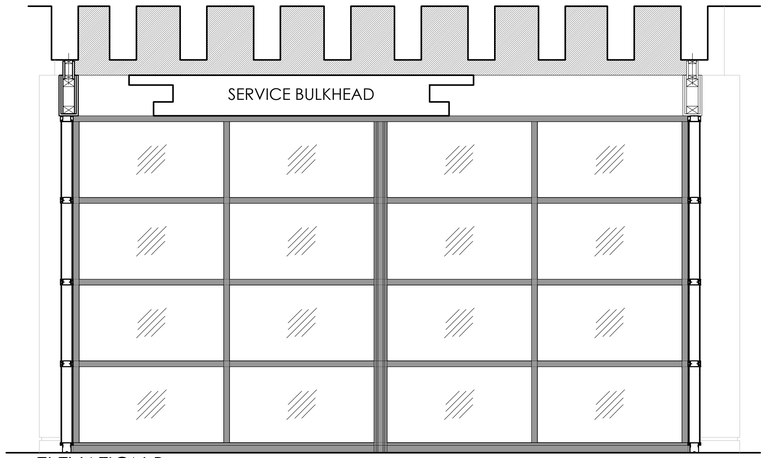

ELEVATION B

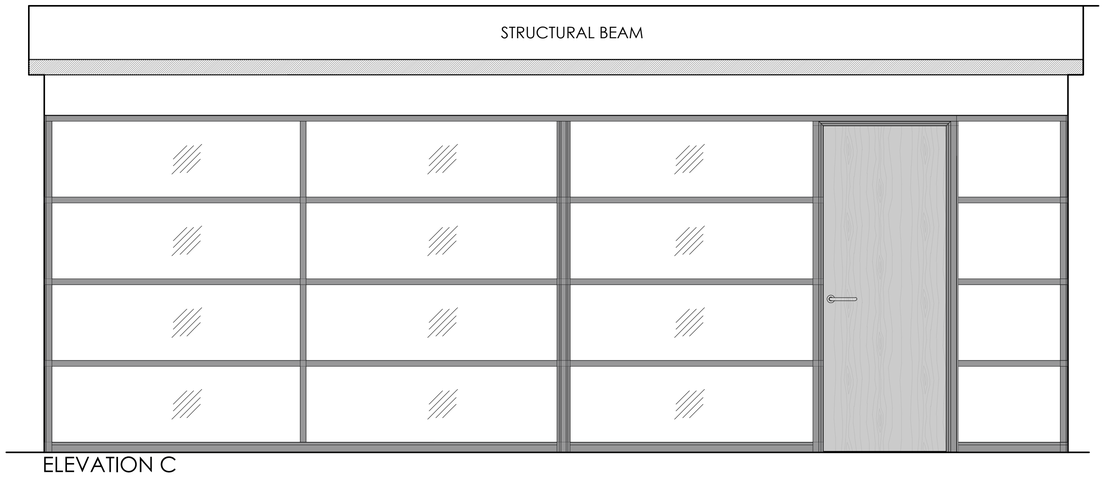

ELEVATION C

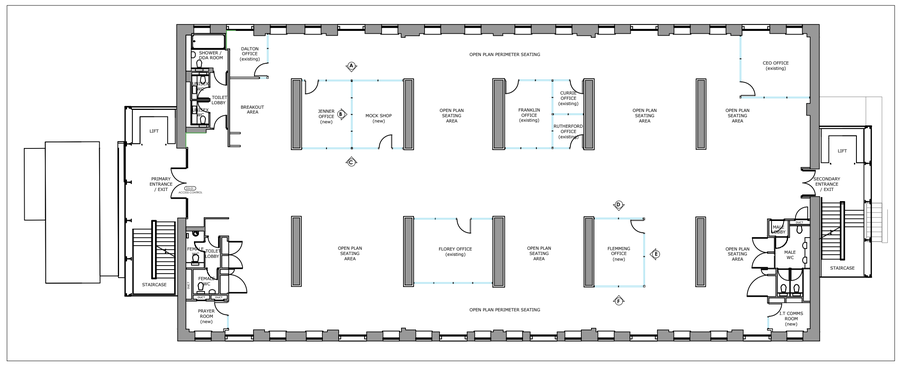

LOCATION KEY

DRAWING TO BE READ IN CONJUNCTION WITH L3-PT-01

0mm 200mm 400mm 600mm 800mm 1m 2m

SCALE BAR (1:20)

Rev	Date	Description	Drawn	Chk'd	App'd
P02	08.03.26	As built Issue	RISI	-	-

Client:

WELL PHARMACY

Project:

OFFICE RELOCATION
MERCHANTS WREHOUSE
MANCHESTER

Drawing Title:

LEVEL 3
PARTITION ELEVATIONS
AS BUILT

Scale (at A1): **1:20**

NIR Project No: **81400831**

NIRAS

ARCHITECTS

Project Contact: RISI @NIRAS.com
tel: +44 (0) 1509 670850

Status: **PLANNING** — Status: **S2**

Drawing No.: **400831-NIR-B01- 00 -DR-A-PE-01** — Rev.: **P02**

Copyright, Designs and Patents Act (1988)
This drawing must not be reproduced without the permission of NIRAS Group (UK) Ltd.