+well

# MERCHANT'S QUAY, MANCHESTER


## PARTITION & ABUTMENT DETAILS - 1 of 2

DO NOT SCALE DRAWING

**GENERAL NOTES**


1. All dimensions are in millimetres unless noted otherwise.
   No dimensions to be scaled off this drawing.
   All dimensions to be checked on site prior to ordering materials.

### SECTION A-A
VERTICAL SECTION THROUGH SOLID PARTITION

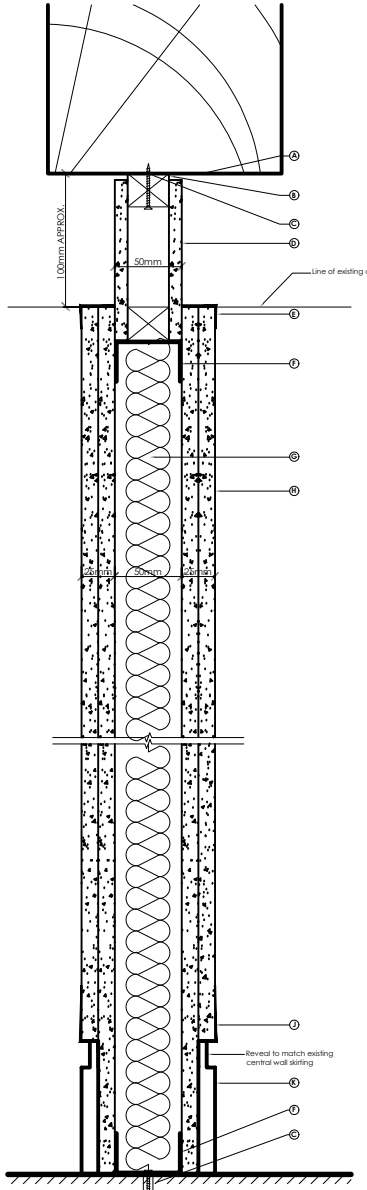



A: EXISTING STRUCTURAL TIMBER BEAM
B: 5mm REVEAL
C: SUITABLE FIXINGS
D: 9.5mm PLASTERBOARD
E: 25mm EDGE TRIM
F: 50mm STEEL STUD
G: INSULATION
H: 12.5mm PLASTERBOARD
J: 12.5mm EDGE TRIM
K: MDF SKIRT TO MATCH EXISTING CENTRAL WALL DETAIL

### SECTION B-B
VERTICAL SECTION THROUGH GLAZED PARTITION

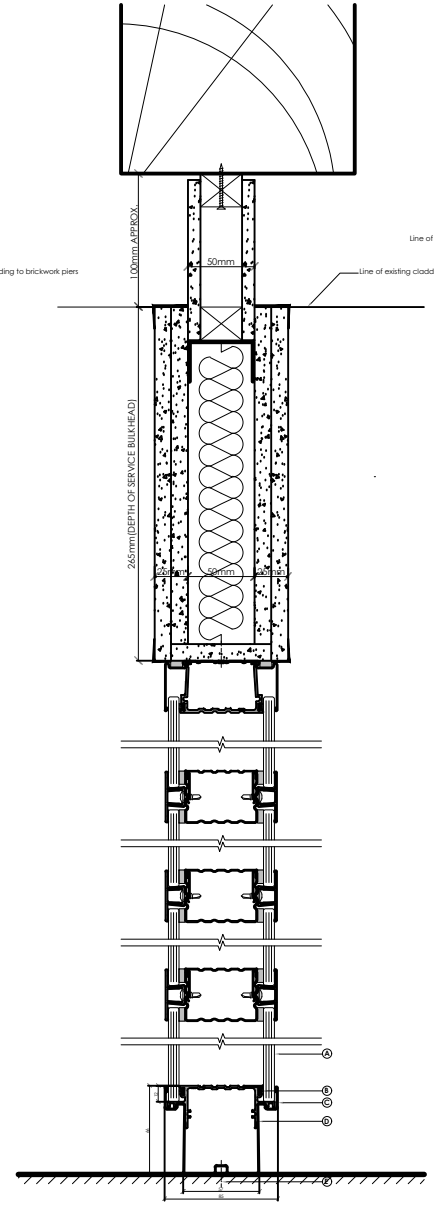



A: 6/8mm GLASS (NOMINAL GLASS THICKNESS NOTED)
B: 11855 BRUSH SEAL
C: SYS102 SKIRTING TRACK
D: SYA106 DOUBLE GLAZING BASE RAIL
E: SUITABLE FIXINGS

### SECTION C-C
VERTICAL SECTION THROUGH FULL HEIGHT DOOR

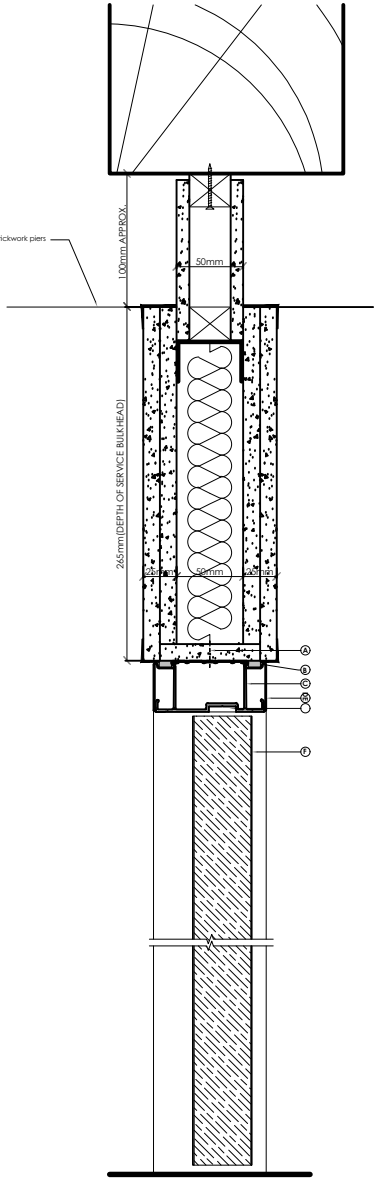


A: SUITABLE FIXINGS
B: SYF10X6 FOAM SEAL
C: SYA13 DOOR FRAME HEAD SECTION
D: SYS01 HEAD TRACK
E: PIS20X2 OPTIONAL COVER STRIP
F: 44mm TIMBER WITH LAMINATE FACE DOOR

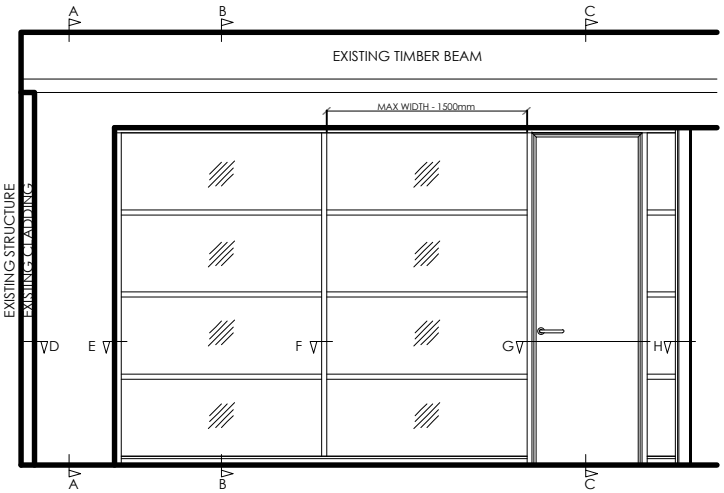


**TYPICAL PARTITION ELEVATION**
scale 1:20

SCALE BAR (1:20)

| Rev | Date | Description | Drawn | Chk'd | App'd |
|---|---|---|---|---|---|
| P02 | 08.09.06 | As built issue | RISI | | |

Client:
**WELL PHARMACY**

Project:
**OFFICE RELOCATION**
**MERCHANTS WREHOUSE**
**MANCHESTER**

Drawing Title:
**LEVEL 3**
**PARTITION AND ABUTMENT 1OF2**
**AS BUILT**

Scale (at A1): **1:20**
NIR Project No: **81400831**

NIRAS
ARCHITECTS


Project Contact: RISI @NIRAS.com
tel: +44 (0) 1509 670850


Status: **PLANNING** | Status: **S2**

Drawing No.: **400831-NIR-B01- 00 -DR-A-PT-10** | Rev.: **P02**


Copyright, Designs and Patents Act (1988)
This drawing must not be reproduced without the permission of NIRAS Group (UK) Ltd.