
DO NOT SCALE DRAWING


GENERAL NOTES

1. All dimensions are in millimetres unless noted otherwise.
   No dimensions to be scaled off this drawing.
   All dimensions to be checked on site prior to ordering materials.

+well


MERCHANT'S WAREHOUSE, MANCHESTER
LEVEL THREE - DOOR SCHEDULE

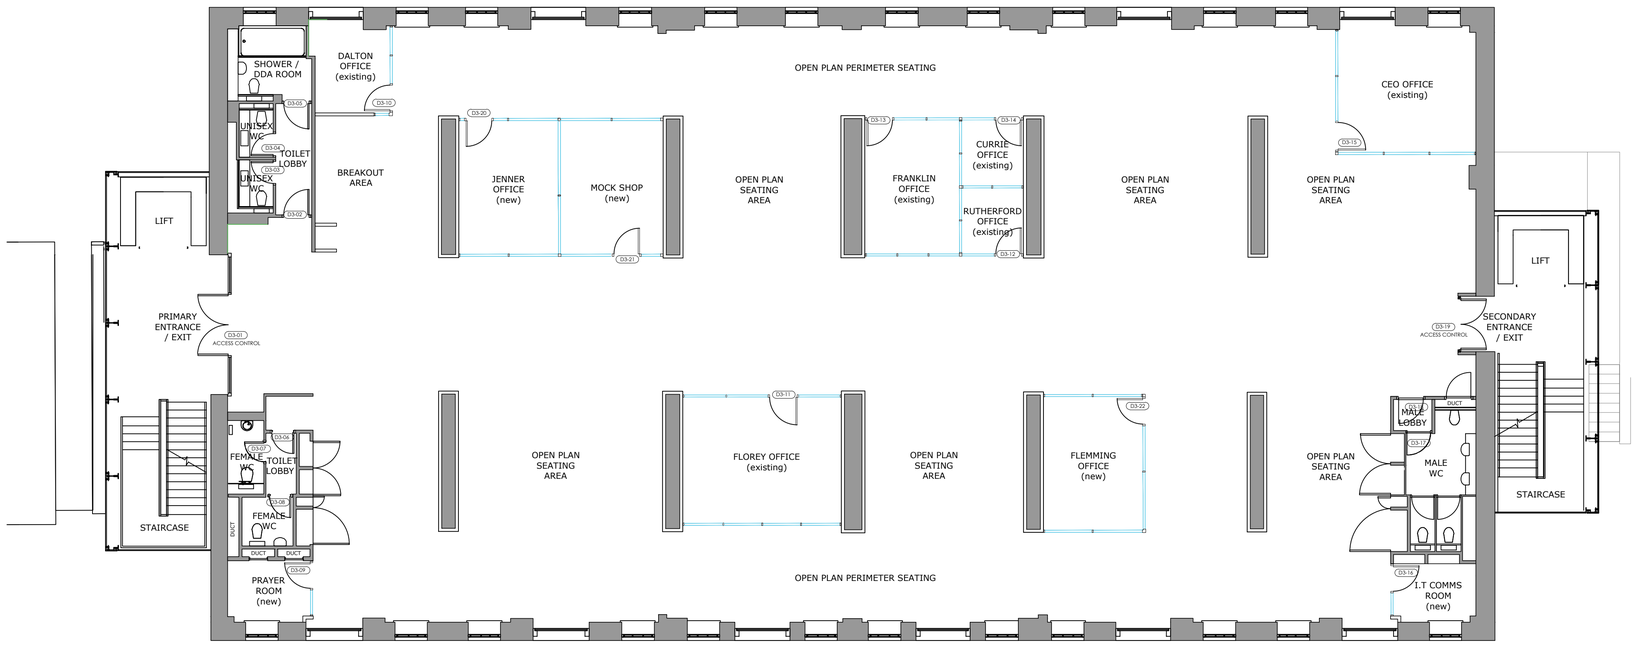

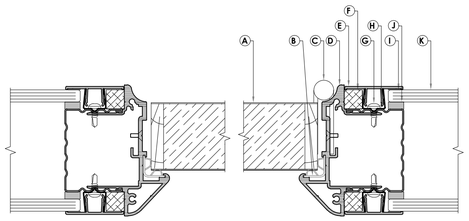

A: 44mm TIMBER DOOR
B: PTDS DOOR SEAL
C: HL103 HINGE
D: SYA10 DOOR FRAME
E: SYA138 FLUSH PLAIN ALUMINIUM TRIM
F: 10876 MDF PACKING STRIP
G: 13 x 4.2mm PAN HEAD SELF DRILLER
H: SYS104M STUD AND CHANNEL
I: 11856 FOAM SEAL
J: SYF10X4 FOAM SEAL
K: 6/8mm GLASS
(NOMINAL GLASS THICKNESS NOTED)

TYPICAL HORIZONTAL SECTION THROUGH DOOR
scale 1:2

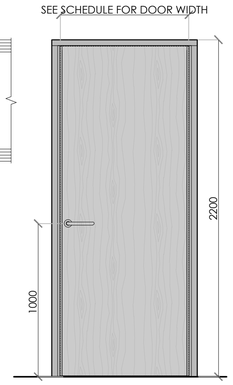

HEIGHT TO U/S OF BULKHEAD ON THIS FLOOR = 2200mm
CONTRACTOR TO PROVIDE FULL HEIGHT DOORS TO SUIT

DOOR TYPE A
scale 1:20

DOOR SCHEDULE

	DOOR						FRAME		Fire Rating	IRONMONGERY										NOTES
Number	Configuration	Door Size - WxHxT	Finish	Colour	Core	Vision Panel	Finish	Type		Finish	Lever Handles	Pull Handle	Push Plate	Latch	Cylinder Lock	Flush Bolt	Secure Access	Self closer	Kick plate	
D3-01	EXISTING																YES			ACCESS CONTROL
D3-02	EXISTING																			
D3-03	EXISTING																			
D3-04	EXISTING																			
D3-05	EXISTING																			
D3-06	EXISTING																			
D3-07	EXISTING																			
D3-08	EXISTING																			
D3-09	EXISTING																			
D3-10	EXISTING																			
D3-11	EXISTING																			
D3-12	EXISTING																			
D3-13	EXISTING																			
D3-14	EXISTING																			
D3-15	EXISTING																			
D3-16	EXISTING																			
D3-17	EXISTING																			
D3-18	EXISTING																			
D3-19	EXISTING																YES			ACCESS CONTROL
D3-20	TYPE A	838 x 2160 x 44	LAMINATE	EGGER H3081 ST22 HACIENDA BLACK	SOLID	--	POWDERCOATED RAL 9004	METAL	--	SATIN CHROME	YES	--	--	YES	YES	--	--	--	--	
D3-21	TYPE A	838 x 2160 x 44	LAMINATE	EGGER H3081 ST22 HACIENDA BLACK	SOLID	--	POWDERCOATED RAL 9004	METAL	--	SATIN CHROME	YES	--	--	YES	YES	--	--	--	--	
D3-22	TYPE A	838 x 2160 x 44	LAMINATE	EGGER H3081 ST22 HACIENDA BLACK	SOLID	--	POWDERCOATED RAL 9004	METAL	--	SATIN CHROME	YES	--	--	YES	YES	--	--	--	--	

IRONMONGERY SPEC

Lever Handle	Ref: 27432	Monza Lever on Rose	Finish - Satin Chrome
Escutcheon	Ref: 12341	Euro profile escutcheon	Finish - Satin Chrome
Door Stop	Ref: 10889	Half Moon Floor Door Stop	Finish - Satin Chrome
Pull Handle	Ref: 23973/3	610mm T Bar Pull Handle	Finish - Satin Chrome

All available from A & H Brass. Tel: +44 (0)20 7402 1854 Email: sales@ahbrass.co.uk

0m 1m 2m 3m 4m 5m 10m
SCALE BAR (1:100)

Rev	Date	Description	Drawn	Chk'd	App'd
P02	08.03.26	As built Issue	RISI	-	-

Client:
WELL PHARMACY

Project:
OFFICE RELOCATION
MERCHANTS WREHOUSE
MANCHESTER

Drawing Title:
LEVEL 3
DOOR SCHEDULE
AS BUILT

Scale (at A1): **AS SHOWN** | NIR Project No: **81400831**

NIRAS
ARCHITECTS

Project Contact: RISI @NIRAS.com
tel: +44 (0) 1509 670850

Status: **PLANNING** | Status: **S2**

Drawing No.: **400831-NIR-B01- 00 -DR-A-DS-01** | Rev. **P02**

Copyright, Designs and Patents Act (1988)
This drawing must not be reproduced without the permission of NIRAS Group (UK) Ltd.