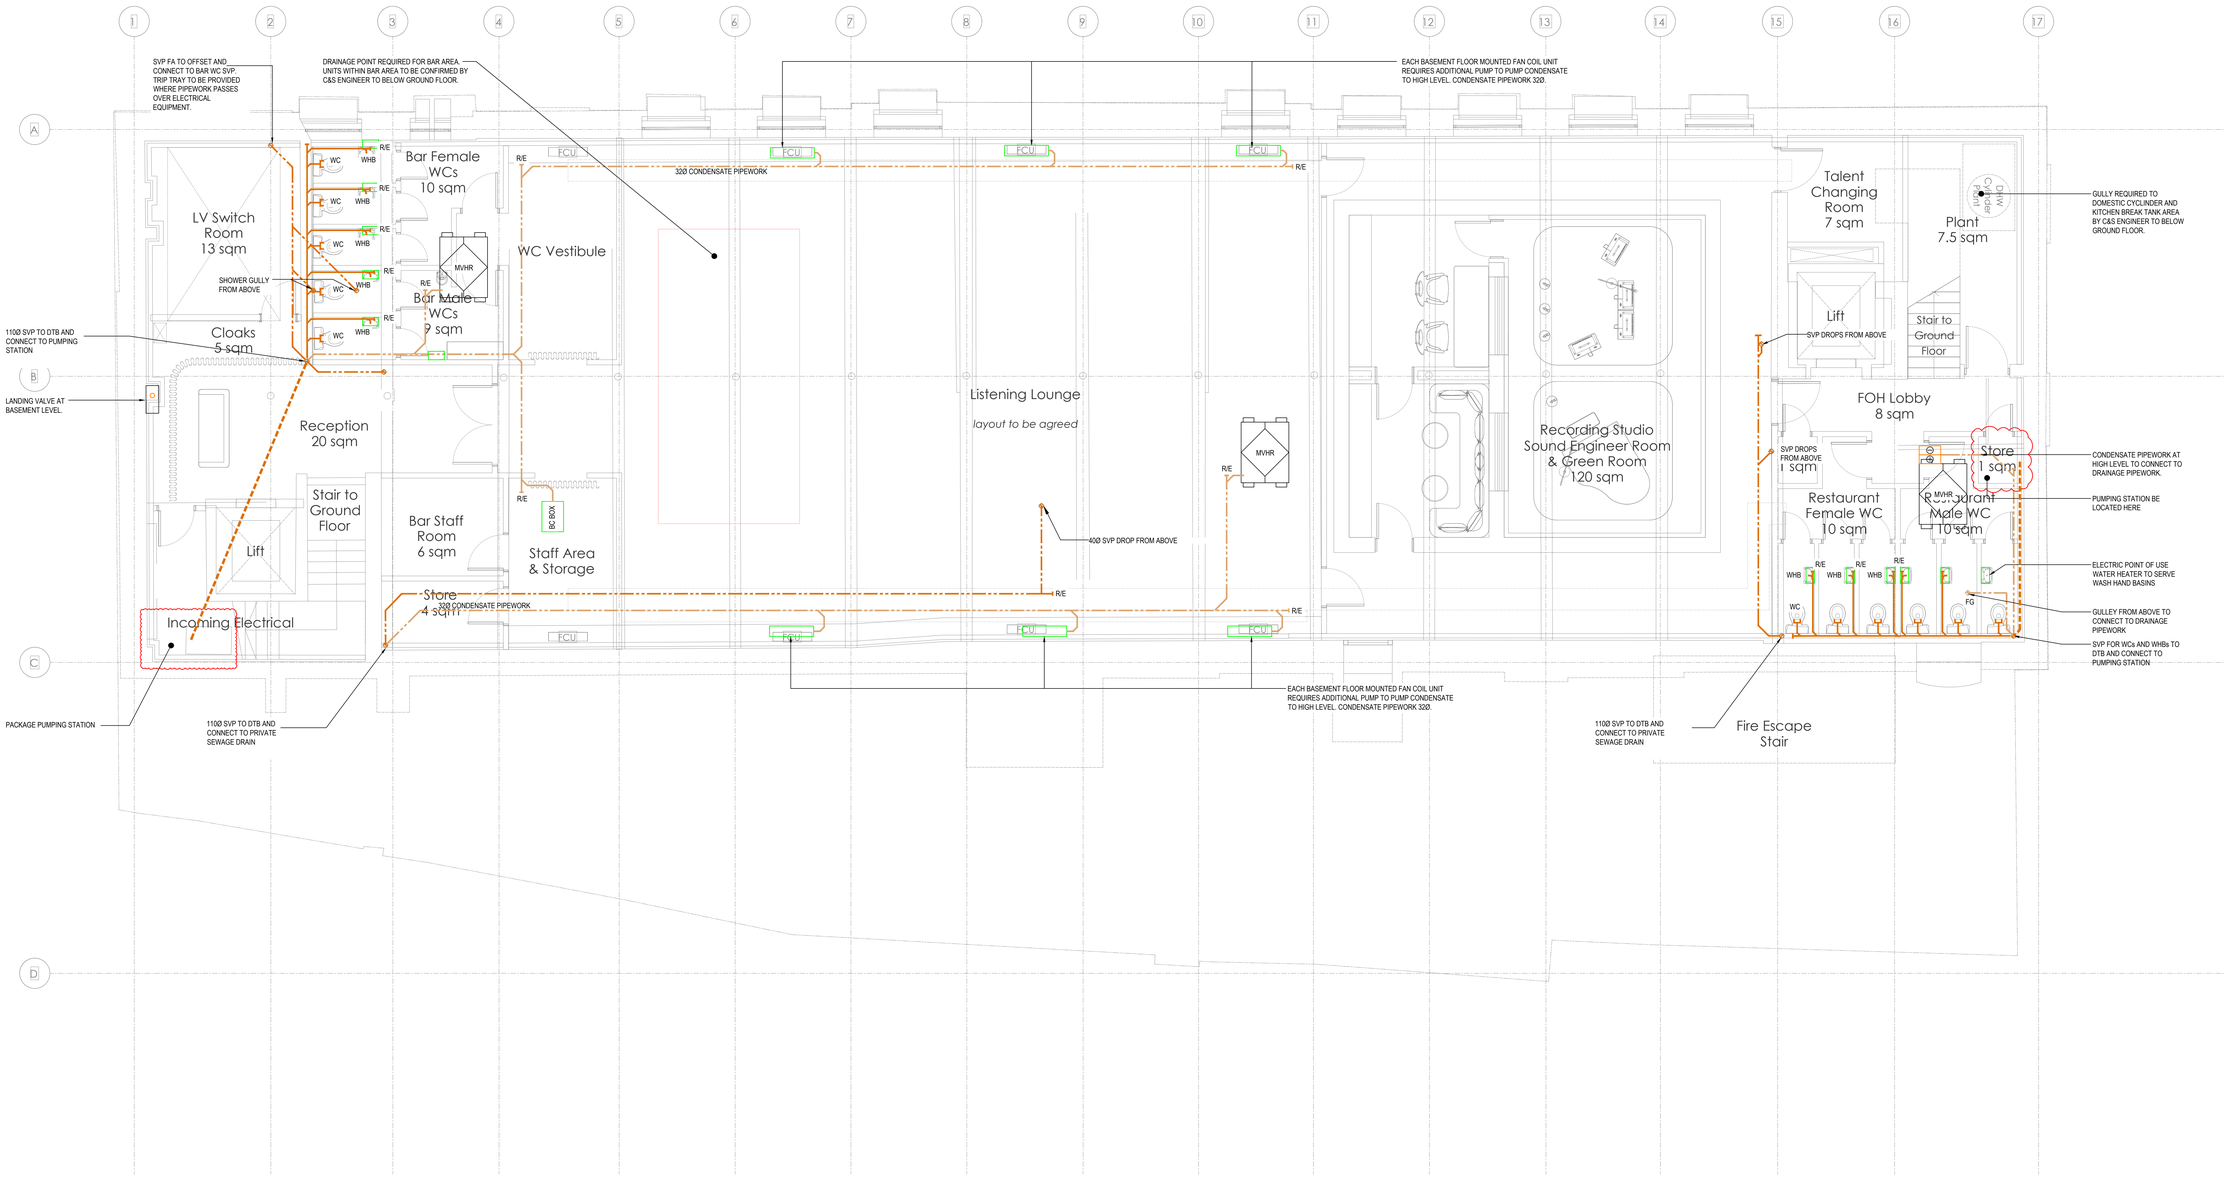


LEGEND

- SOIL PIPEWORK
- CONDENSATE PIPEWORK
- DRY RISER PIPEWORK

SVP SOIL & VENT PIPE
WVP WASTE AND VENT PIPE
VP VENT PIPE
RFB RISE FROM BELOW
RTA RISE TO ABOVE
DFA DROP FROM ABOVE
DTB DROP FROM BELOW
DTLL DROP TO LOW LEVEL
FG FLOOR GULLY
RE RODDING EYE
SS STUB STACK

DISCLAIMER NOTES:

- THIS DOCUMENT IS COPYRIGHT OF THE ORIGINATOR AND MUST BE TREATED AS CONFIDENTIAL
- THIS DOCUMENT MUST NOT BE ALTERED, REPRODUCED OR DISTRIBUTED WITHOUT PRIOR WRITTEN CONSENT OF THE ORIGINATOR
- THIS DOCUMENT MUST NOT BE ALTERED - THE ORIGINATOR ACCEPTS NO RESPONSIBILITY FOR ANY DISCREPANCIES ARISING AS A RESULT OF THE ORIGINATORS INFORMATION BEING ALTERED BY OTHERS.
- ANY DISCREPANCY MUST BE REPORTED TO THE ORIGINATOR
- DO NOT SCALE THIS DOCUMENT - USE FIGURED DIMENSIONS ONLY
- ALL DIMENSIONS MUST BE CHECKED ON SITE PRIOR TO COMMENCEMENT OF ANY RELATED WORKS
- THIS DOCUMENT MUST BE READ IN CONJUNCTION WITH ALL SUPPORTING DOCUMENTS PRODUCED BY THE ORIGINATOR AND OTHER PROJECT DISCIPLINES
- THE ORIGINATOR ACCEPTS NO RESPONSIBILITY FOR THE ACCURACY OF BACKGROUND INFORMATION PRODUCED BY THIRD PARTIES - THIS MUST BE TREATED AS INDICATIVE ONLY
- USERS OF THIS DOCUMENT ARE RESPONSIBLE FOR CHECKING WHICH REVISION IS CURRENT
- THE DOCUMENT STATUS "INFORMATION" OR "PRELIMINARY", INDICATES THAT THIS DRAWING IS FOR REFERENCE PURPOSES ONLY - THE ORIGINATOR WILL ACCEPT NO RESPONSIBILITY FOR THE COMPLETENESS OF INFORMATION UNDER THIS STATUS
- THE DOCUMENT STATUS "RECORD" OR "AS BUILT" HAS BEEN PREPARED, IN PART, BASED UPON INFORMATION FURNISHED BY OTHERS. WHILE THIS INFORMATION IS BELIEVED TO BE RELIABLE, THE ORIGINATOR ASSUMES NO RESPONSIBILITY FOR THE ACCURACY OF THIS "RECORD" OR "AS BUILT" DOCUMENT OR FOR ANY ERRORS OR OMISSIONS THAT MAY HAVE BEEN INCORPORATED INTO IT AS A RESULT OF INCORRECT INFORMATION PROVIDED TO THE ORIGINATOR. THOSE RELYING ON THE "RECORD" OR "AS BUILT" DOCUMENT ARE ADVISED TO OBTAIN INDEPENDENT VERIFICATION OF ITS ACCURACY

DRAWING NOTES:

CDM REGULATIONS 2015
SIGNIFICANT OR NON-OBVIOUS RISKS AND RISKS WHICH ARE DIFFICULT TO MANAGE ARE IDENTIFIED ON THIS DRAWING USING THE FOLLOWING SYMBOL, IDENTIFIED TO THE RIGHT WITH BRIEF ACCOMPANYING TEXT. FOR FURTHER DETAILS OF THE RISKS IDENTIFIED BY DESIGNERS, REFERENCE SHOULD BE MADE TO CDM HAZARD REGISTER.

ABOVE GROUND DRAINAGE GENERAL NOTES

1. ALL SVP TO BE 110ø/ UPVC, UNLESS OTHERWISE STATED.
2. THIS DRAWING SHALL BE READ IN CONJUNCTION WITH ANY RELEVANT STRUCTURAL, ARCHITECTURAL AND CONSULTANTS DRAWINGS. DO NOT SCALE FROM THIS DRAWING.
3. ALL DIMENSIONS STATED IN mm.
4. ALL SINGLE WHB STUB STACKS TO BE 50Ø WASTED, WITH 32Ø WASTE TRAPS.
5. ALL WC MANIFOLD SOIL PIPES C/W UP TURNED RODDING ARMS.
6. ALL CONDENSATE WASTE PIPE CONNECTIONS TO STACKS VIA HIGH LEVEL BOSS CONNECTIONS SERVING HEAT PUMPS AND HRUs CONDENSATE DRAINAGE TUNDISH AND SUITABLY SIZED WASTE VALVE.
9. ALL HEAT PUMP AND HRU CONDENSATE DRAINS TO BE INSTALLED IN 40Ø PIPEWORK.
10. ALL SVP PIPE TERMINATION THROUGH ROOF STRUCTURE SHALL FITTED WITH WEATHERING APRON AND VENT COWLS.
11. ALL STUB STACKS SHALL BE 110mm/ C/W AAAV
12. ALL VERTICAL DROPS ARE 110mm UPVC

GENERAL NOTES:

1. THIS DRAWING SHALL BE READ IN CONJUNCTION WITH ANY RELEVANT STRUCTURAL, ARCHITECTURAL AND CONSULTANTS DRAWINGS.
2. THIS DRAWING SHALL BE READ IN CONJUNCTION WITH THE SERVICES DRAWINGS
3. DO NOT SCALE FROM THIS DRAWING.
4. ALL DIMENSIONS STATED IN mm.
5. ABOVE GROUND DRAINAGE SOIL, VENT AND WASTE VENT PIPE SHALL BE CARRIED OUT IN PVC TO BS3282:1047. 100 SERIES SOLVENT WELD PIPE AND FITTINGS TO BS EN 1329-1:2000 KITEMARK CERTIFIED.
6. WASTE PIPEWORK AND FITTINGS SHALL BE CARRIED OUT IN PVC TO BS EN 1566- 1:2000 200 SERIES SOLVENT WELD PIPE AND FITTING KITEMARK CERTIFIED.
7. PLASTIC PIPEWORK AND FITTING JOINTING SHALL BE GENERALLY SOLVENT WELD WITH RING SEAL JOINTS TO ACCOMODATE EXPANSION.
8. TRAP AND PAN CONNECTOR SHALL BE TO BS 3943 KITEMARKS CERTIFIED, SERIES 400.
9. THE INSTALLATION SHALL CONFORM TO BS EN 12056 PART 1 TO 5, BUILDING REGULATION APPROVED DOCUMENT AND THE LOCAL AUTHORITY BUILDING CONTROL OFFICER.
10. PVC PIPEWORK PASSING THROUGH WALLS OR SLABS SHALL BE SLEEVED AND SEALED.
11. THE INSTALLATION WHERE SUSPENDED IN CEILING VOID SHALL BE FRAMED WITH 25mm THICK FOIL FACED INSULATION FOR THE PREVENTION OF CONDENSATION AND NOISE BREAK OUT.
12. MEP SUB-CONTRACTOR TO CO-ORDINATE ALL FINAL ABOVE GROUND DRAINAGE CONNECTIONS BETWEEN FF&E ITEMS AND DRAIN STACKS.
13. FOR DETAILS OF RAIN WATER OUTLETS SEE ARCHITECTS DRAWINGS.
14. ALL SVPs FITTED WITH ACCESS DOOR 1100mm ABOVE FFL, ALL STACKS ALL LEVELS.
15. THE ARCHITECT TO CONFIRM ALL STACK RISER POSITIONS AND PROVIDED BOXING DETAILS AS NECESSARY.
16. ALL PLASTIC 50Ø AND ABOVE TO BE FITTED WITH FIRE COLLAR AT ALL FIRE COMPARTMENT WALLS AND FLOORS.
17. THERMAL STRESS RELIEF UNITS AND NECESSARY ANCHORS MUST BE PROVIDED IN ACCORDANCE WITH MANUFACTURERS RECOMMENDATIONS.
18. MEP CONTRACTOR TO CO-ORDINATE ALL RISER POSITIONS AND REQUIREMENTS WITH ARCHITECT AND STRUCTURAL ENGINEERS.
19. MEP CONTRACTOR TO CO-ORDINATE ALL ACCESS REQUIREMENTS THROUGH CEILINGS, BULKHEADS ETC., WITH ARCHITECT BASED ON INSTALLATION DRAWINGS.
20. ALL 40Ø CONDENSE WASTE PIPES SERVING HRUs, WHICH CONNECT TO SVP STACKS / AND WASTE STACKS SHALL BE VIA BOSS CONNECTION, TUNDISH & WASTE VALVE ARRANGEMENT.
21. ALL SERVICES LAYOUTS ARE INDICATIVE ONLY TO REPRESENT THE DESIGN PRINCIPLES. THE MEP CONTRACTOR SHALL IN COUNCLTION WITH THE ARCHITECT & CONSULTANT TO DETERMINE ALL FINAL ROOM LAYOUTS AND FF&E REQUIREMENTS AND INCORPORATE WITHIN THEIR FINAL DESIGN
22. ANY DRAINAGE PIPEWORK ON SHOW SHALL BE WHITE IN COLOUR.
23. ALL ABOVE GROUND DRAINAGE WILL BE INSULATED FOR REDUCTION IN SOUND BREAKOUT NOISE
24. EACH VERTICAL STACK WILL BE FITTED WITH AN EXPANSION JOINT TO ALLOW FOR PIPEWORK EXPANSION.
25. ALL VRV AIR CONDITIONING UNITS TO BE FITTED WITH HEPZO VALVES.
26. CONDENSATE DRAINAGE TO BC BOXES, FAN COIL UNITS ETC TO BE DEVELOPED BY THE CONTRACTOR.
27. KITCHEN DRAINAGE POINTS AND POSITIONS TO BE CORDINATED ONCE KITCHEN LAYOUT IS CONFIRMED

REV	DESCRIPTION	DATE	BY	CHKD
P04	STAGE 3 ISSUE - VENT TO BASEMENT AMENDED	03/06/2026	FC	MB
P03	STAGE 3 ISSUE-UPDATED ARCHITECTS GA'S	26/05/2026	FC	MB
P02	STAGE 3 ISSUE	22/05/2026	FC	MB
P01	STAGE 2 ISSUE	07/04/2026	FC	MB

ORIGINATOR: www.ridge.co.uk

RIDGE

PROJECT NUMBER:

CLIENT:
MAKE DEVELOPMENTS

IN ASSOCIATION WITH:

PROJECT:
MARLSBRO HOUSE
MANCHESTER

TITLE:
MECHANICAL SERVICES
DRY RISER & DRAINAGE LAYOUT
BASEMENT

DRAWN BY: F.C. CHECKED BY: MB APPROVED BY: -

SCALE: 1:50 @ A0 DATE: 22/05/2026

STATUS: DESCRIPTION:
S3 SUITABLE FOR REVIEW/COMMENT

DRAWING No: 5031691-RDG-XX-B1-D-M-520000.dwg

PROJECT:	ORG:	FUNCTION:	SPATIAL:	FORM:	DISCIPLINE:	NUMBER:	REV:
5031691	RDG	XX	B1	D	M	520000	P04

0.5 0 0.5 1 1.5 2 2.5
SCALE 1:50 m