




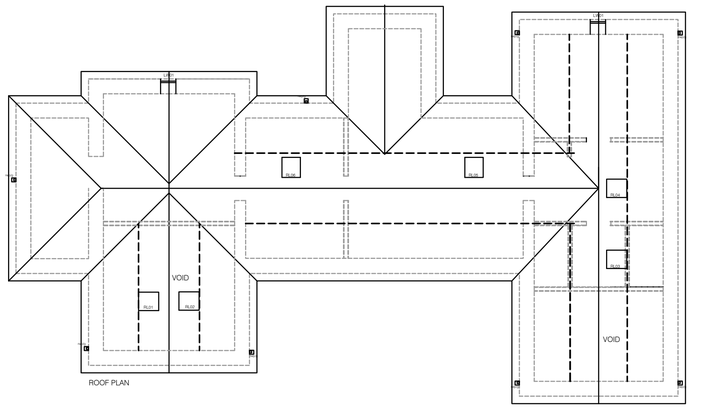


External materials:
Red blue multi facing brick to all elevations
Dark grey horizontal composite board to gables
Dark grey upvc double glazed windows/doors
Dark grey concrete pantiles to pitched roof
Black upvc fascias & bargeboards
Black upvc rainwater goods

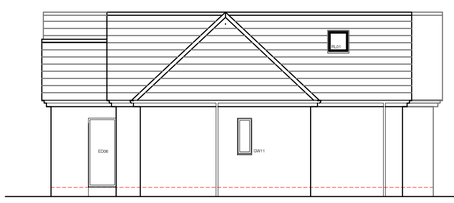


WEST ELEVATION

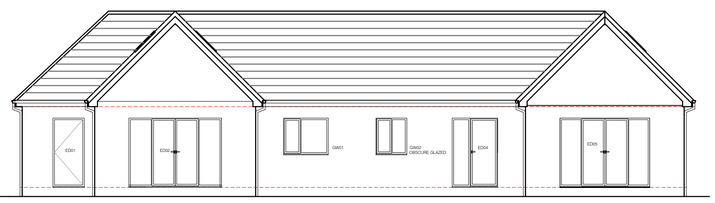

SOUTH ELEVATION

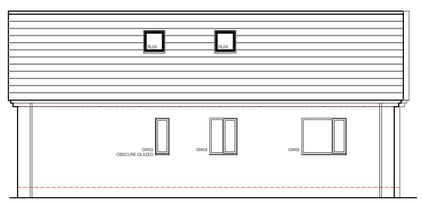

EAST ELEVATION

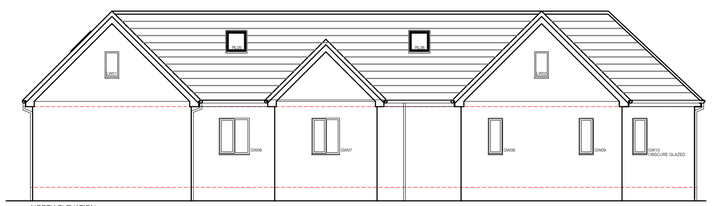

NORTH ELEVATION

Simon R Miles
Chartered Architect
Didsbury
Manchester
T: 07778 137830
E: srmilesarchitect@gmail.com

Contractors must check all dimensions on site before preparing production drawings or commencing any work. This drawing and its design is the copyright of S.R.Miles Ltd and may not be reproduced in any form whatsoever without their prior express written consent.

Revision	Date	Revision note

Notes

Project :
46 WITHENFIELD ROAD BROOKLANDS

Title :
Annexe Floor Plans and Elevations as built

Drawing number :
26 526 PL100

Issue :

Client :
FLANAGAN

Scale :
100 @A1

Date :
19.05.2026

CAD Ref :
26 526

Drawn by :
SRM

SRM
Simon R Miles BA Hons Dip Arch RIBA
Chartered Architect