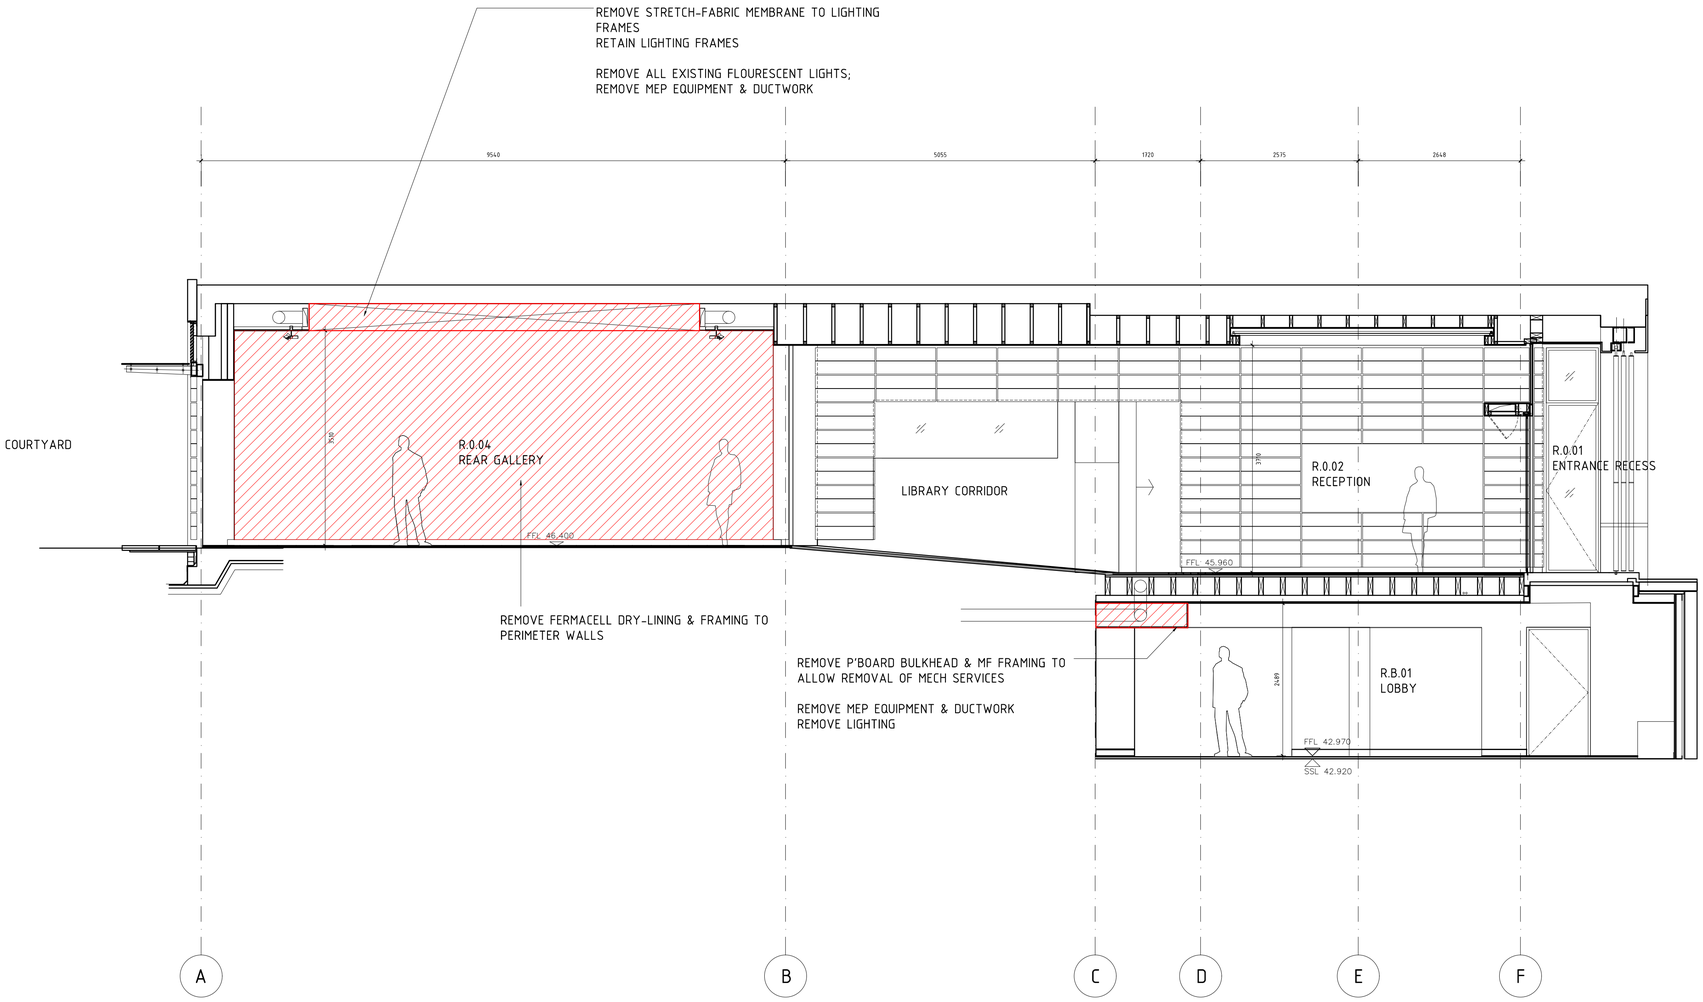


0m 1m 5m

© London Studio Architecture Ltd

GENERAL NOTES

This drawing is for information only
Do not scale from drawing
All dimensions & levels to be checked on site
Any discrepancies to be reported to the Architect


DRAWING NOTES

ALL LAYOUTS & DIMENSIONS BASED ON RECORD DRAWINGS, NOT FROM MEASURED SURVEY - INACCURACIES / DISCREPANCIES MAY OCCUR.

REFER TO CONSULTANT INFORMATION FOR;
- STRUCTURAL ENGINEERING
- UTILITIES
- MEP SERVICES
- SECURITY SYSTEMS
- IT & COMMS

DEMOLITION/ STRIP-OUT

- date -
revision notes

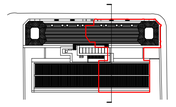

LONDON STUDIO ARCHITECTURE
07788 788198
www.londonstudioarchitecture.com

project
ESEA CONTEMPORARY
title
DEMOLITION/ ALTERATION SECTION A
-
status
FOR INFORMATION
scale | date
1:50@A1/1:100@A3 | 01.Jun.2026
dwg. no. | rev.
LSA/079/PA/D/131 | -