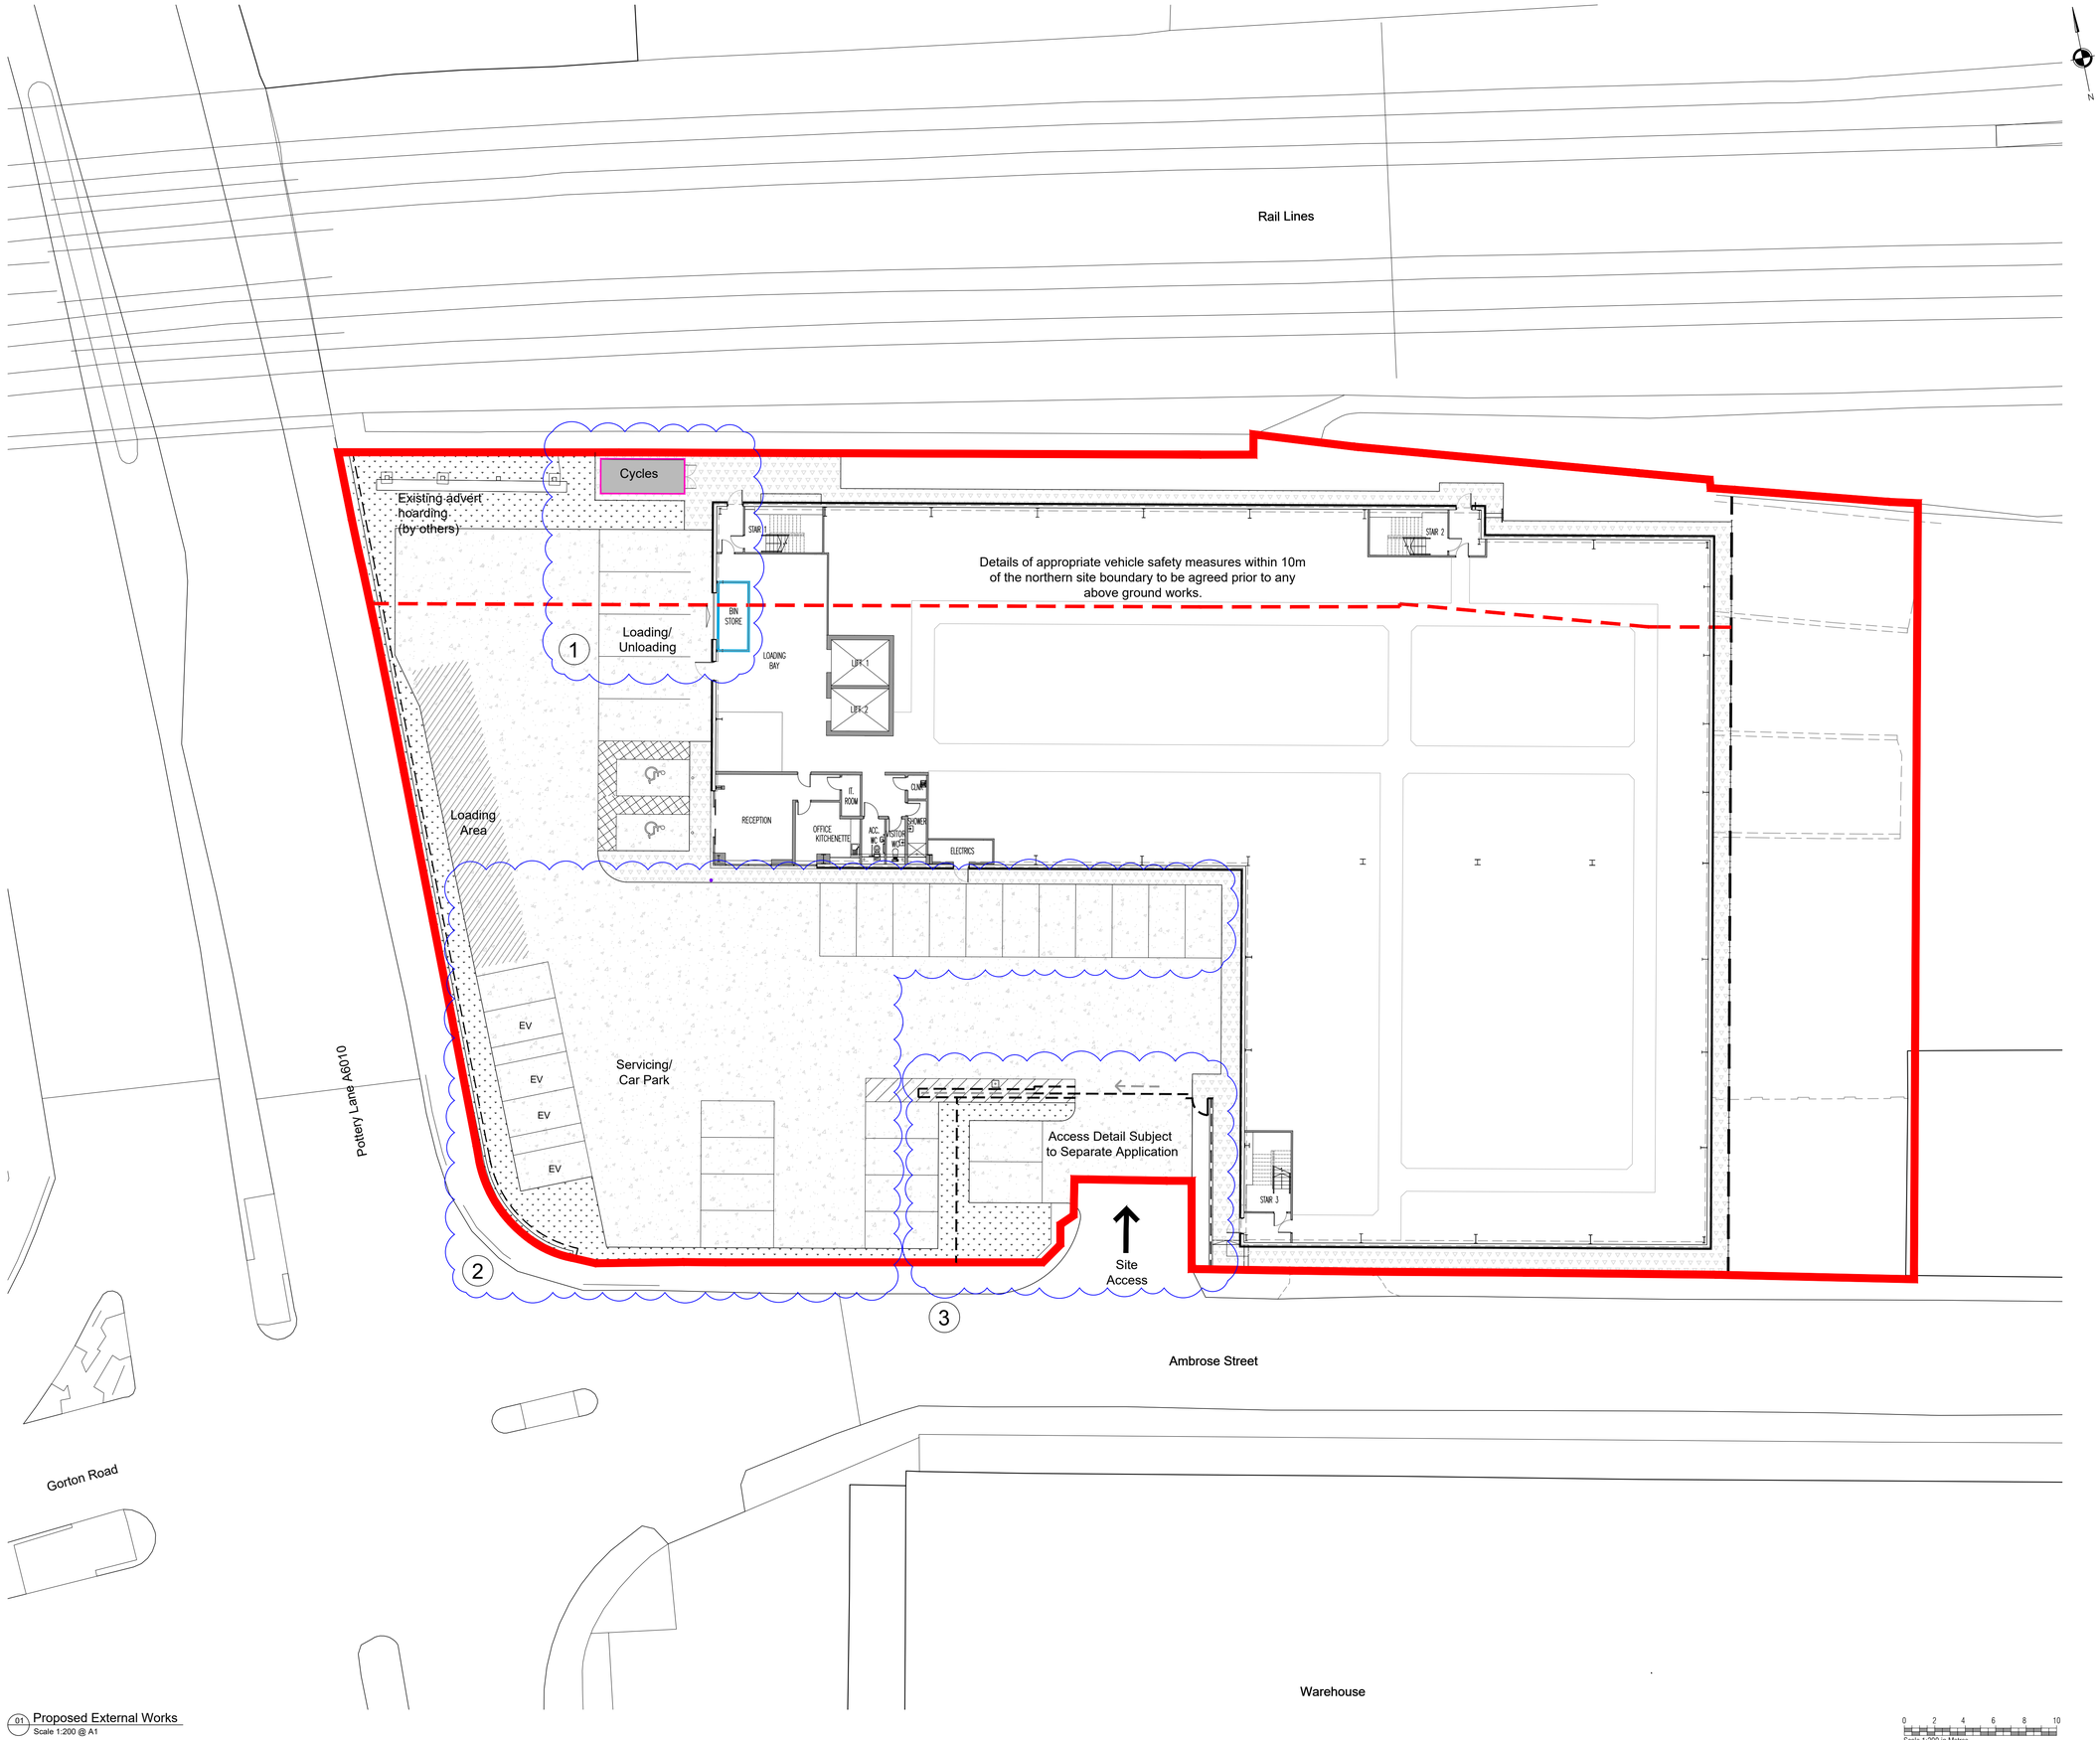


01 Proposed External Works
Scale 1:200 @ A1

0 2 4 6 8 10
Scale 1:200 in Metres

SPECIFICATION:

PROPOSED HARD LANDSCAPE:

TARMAC 4

600X600MM TEXTURED CONCRETE PAVING
MARSHALLS SAXON NATURAL

PROPOSED SOFT LANDSCAPE:

PLANTING

REFER TO LANDSCAPE DRAWING FOR DETAILS.

BOUNDARY TREATMENTS:

2400MM HIGH PALADIN FENCING AND GATES

2400MM PALADIIN FENCE ON RETAINING WALL

10M LINE FROM NORTHERN BOUNDARY

PALADIIN FENCE COLOUR RAL 9005 BLACK

PROPOSED STREET FURNITURE:

BIN STORE

ASGARD CENTURION x14 CYCLE STORE COLOUR: GREY 1

GALVANISED STEEL CRASH PROTECTION BOLLARDS

NB. MATERIALS SUBJECT TO SIMILAR APPROVED BY CLIENT.

SCHEDULE OF REVISIONS:

1 – CYCLE STORE, DUE TO SECURE BY DESIGN COMPLIANCE, UPDATED FROM SHEFFIELD CYCLE STAND AND BRIGHTON CYCLE SHELTER TO ASGARD CENTURION X14 SECURE CYCLE STORE. BIN STORE RELOCATED INTERNALLY.

2 – PARKING ARRANGEMENT AND EV CHARGING SPACES RELOCATED. OVERALL NUMBERS RETAINED ACROSS THE SITE.

3 – ENTRANCE AND ACCESS GATE SUBJECT TO DESIGN DEVELOPMENT. 2 PROSPECTIVE CUSTOMER PARKING SPACES PROVIDED ADJACENT TO ACCESS.

4 – CONCRETE YARD OMITTED IN LIEU OF TARMAC.

Rev	Description	Date	By	Chk
J	UPDATED HARD LANDSCAPING	22.06.26	LT	GB
H	REMOVED OLD CYCLE SHELTER DETAIL	19.05.26	LT	GB
G	UPDATED CYCLE SHELTER AND PARKING	15.05.26	LT	GB
F	GENERAL UPDATES TO SITE PLAN, EXTERNAL BIN STORE REMOVED.	16.09.25	RB	GB
E	ADDED 10m NORTHERN BOUNDARY LINE	22.05.24	LT	GB
D	UPDATED NORTH ELEVATION OF PLAN AND PATHS	06.03.24	LT	GB
C	UPDATED NORTH EAST CORNER	06.09.23	LT	GB
B	RECEPTION/OFFICE/MEETING ROOM/ AMENITIES UPDATED. STORE NOW SHOWER	15.05.23	PS	GB
A	PATH BY EV SPACES, PAVEMENT FILLED	21.04.23	PS	GB

Status: Planning ■ Tender ☐ Construction ☐ As Built ☐ — Purpose for Issue: PLANNING

Client
STORAGE WORLD

Contract
PROPOSED WORKS
STORAGE WORLD, AMBROSE STREET, MANCHESTER

Drawing
PROPOSED EXTERNAL WORKS

bateandtaylor architects
www.bate-taylor.co.uk
macintosh house
4a cambridge street
manchester m1 5gg
tel: 0161 236 0999
fax: 0161 236 0404
mail@bate-taylor.co.uk

Drawing No. MH1314-11 Revision J
Scales 1:200@A1 Date SEPT '22
Drawn PS Checked GB

This drawing is the copyright of the Architect and may not be reproduced without licence.
DO NOT scale from this drawing.