
Notes :
1. Should any discrepancies be found on this drawing, inform jmarchitects.
2. Copyright of this drawing is owned by jmarchitects.
3. This drawing is to be printed in full colour.
4. jmarchitects are not responsible for the content of information from other parties represented on this drawing.
5. This drawing should not be scaled, figured dimensions only to be used.

Structural information is indicative only. For all structural information, refer to the Structural Engineer's drawings and specifications.

1:200

4m 0m 4m 8m 12m 16m 20m

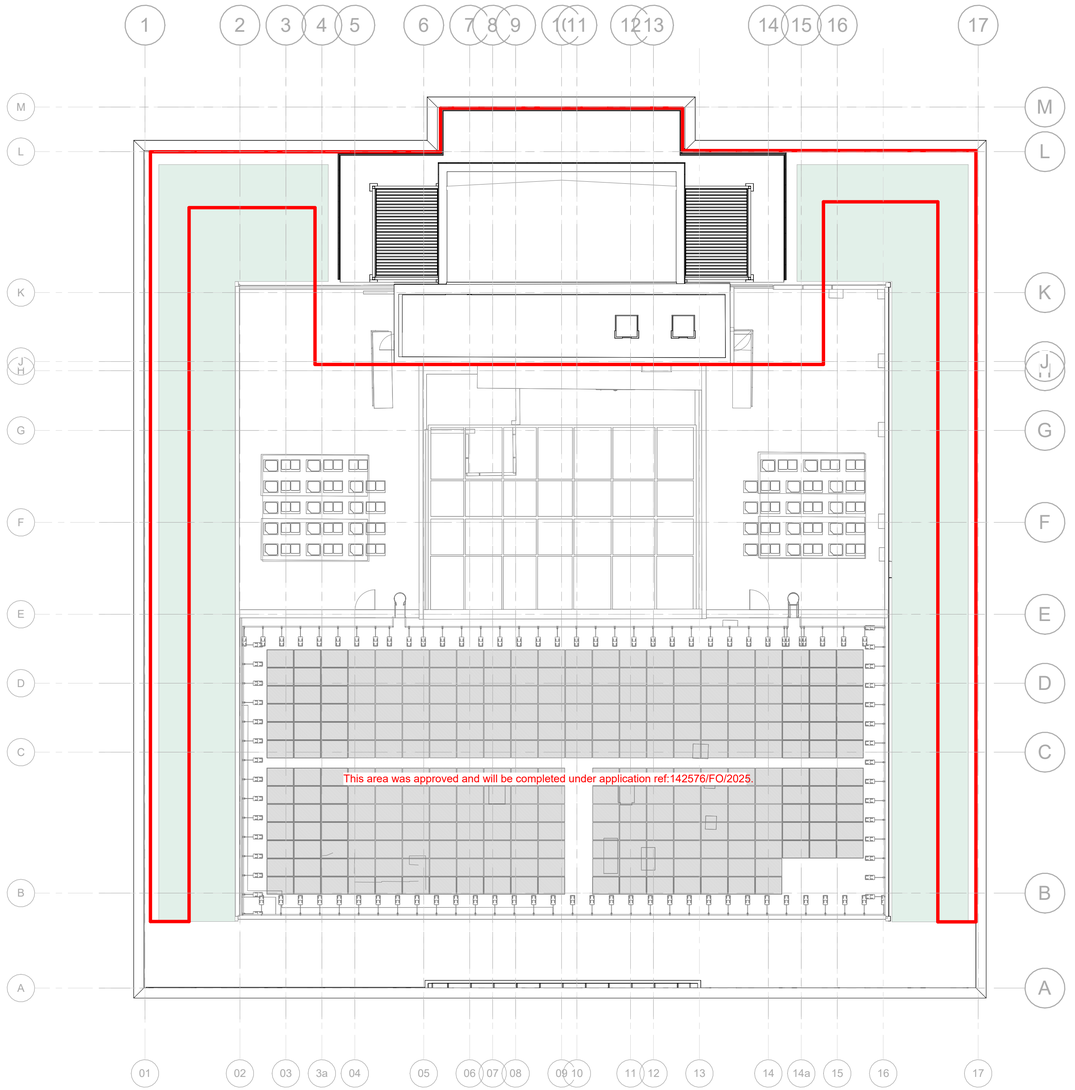


These drawings demonstrate a cumulative proposal that includes the design that falls under planning application reference 142576/FO/2025 (already approved) and further design development. These are clearly marked on the proposed drawings with the previous proposal faded out for clarity.

| Rev | Description | Date | Drn By | Chk By |
|---|---|---|---|---|
| P02 | Red line boundary and approved application note added - Issued for Planning | 2026.07.10 | AK | SK |
| P01 | Project code changed, previous application proposal greyed out for clarity - Issued for Planning | 2026.06.24 | AK | SK |

jmarchitects

3A | 54 Princess Street
Manchester
M1 6HS

T: 0161 200 6300
E: man@jmarchitects.net
W: www.jmarchitects.net

Project
One Tony Wilson Place

Title
Proposed Roof Plan

Client
Ralion Property II Limited

Purpose :
For Planning

Scale :
As indicated @ A1

Drawing Number
Project Code - Originator - Spatial - Form - Discipline - Package / Number
26012-JMA-RL-DR-A-PL0002

Revision
P02

JMA Project Number
7124

Version: 00.00.14