
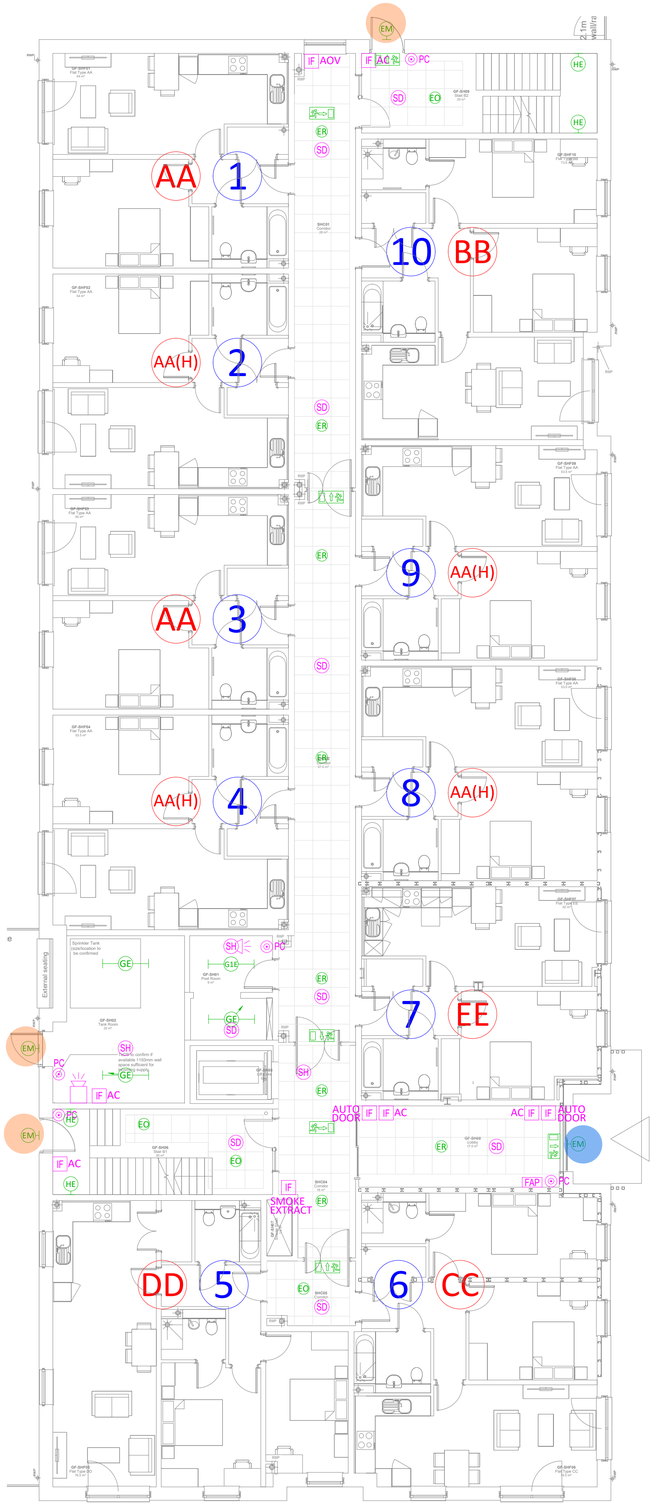


GROUND FLOOR

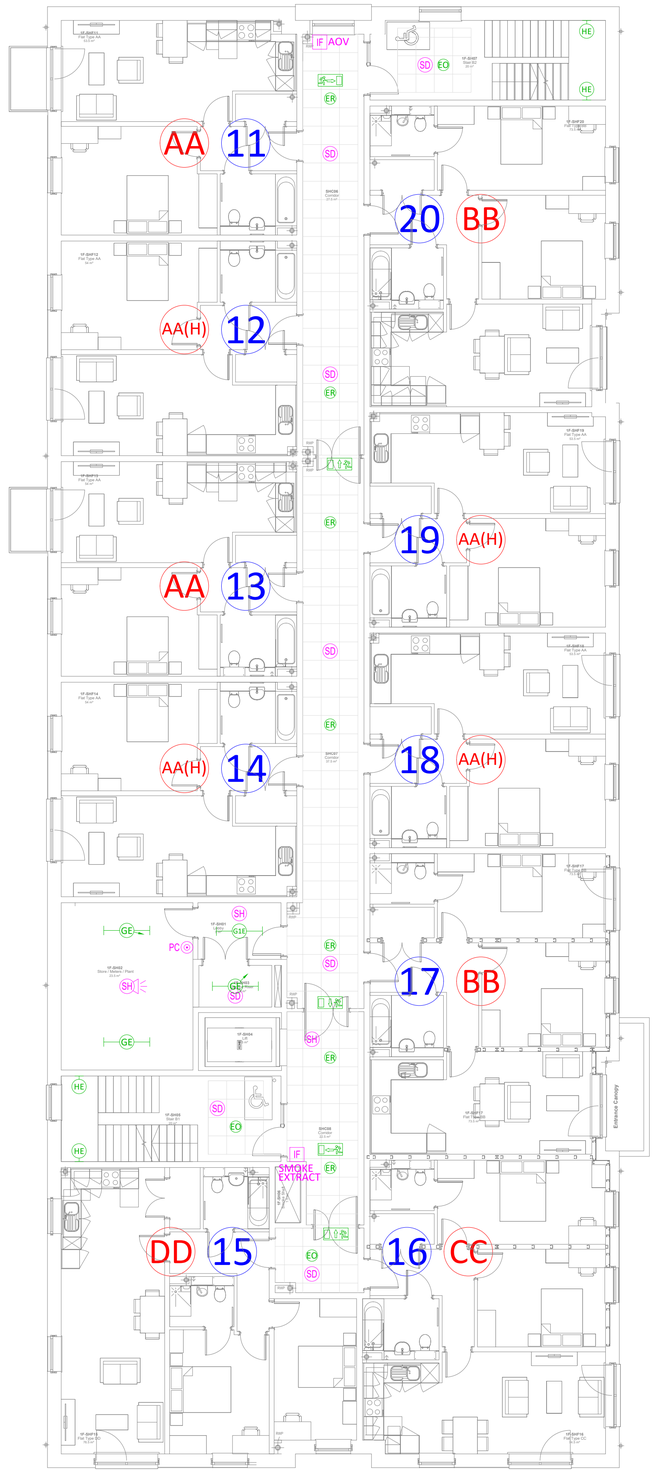

FIRST FLOOR

SYMBOL KEY

- CEILING MOUNTED LUMINAIRE
- WALL MOUNTED LUMINAIRE
- 1500mm LUMINAIRE
- EMERGENCY EXIT SIGN
- FAP 6500 FIRE ALARM PANEL - PANEL 1 GROUND - MAIN ENT
- IF FIRE ALARM I/O INTERFACE
- SD OPTICAL SMOKE DETECTOR
- SD OPTICAL SMOKE DETECTOR C/W SOUNDER
- HD HEAT DETECTOR
- HD HEAT DETECTOR C/W SOUNDER & VAD
- SH COMBINED OPTICAL HEAT DETECTOR
- SH COMBINED OPTICAL HEAT DETECTOR C/W SOUNDER
- SH COMBINED OPTICAL HEAT DETECTOR C/W VAD
- SH COMBINED OPTICAL HEAT DETECTOR C/W SOUNDER & VAD
- MANUAL CALL POINT
- PC MANUAL CALL POINT HINGED COVER FLAP
- WALL MOUNTED SOUNDER C/W VAD

LUMINAIRE SCHEDULE

EM	EMERGENCY BULKHEAD
EO	EMERGENCY OPEN AREA
ER	EMERGENCY ROUTE
F	COMFORT LED DOWNLIGHT
FE	AS ABOVE C/W EMERGENCY
G	1500mm NON CORROSIVE BATTEN
GE	AS ABOVE C/W EMERGENCY
G1E	1500mm NON CORROSIVE BATTEN C/W MICROWAVE & EM
HE	WALL MOUNTED BULKHEAD C/W EMERGENCY & MICROWAVE
SP	APARTMENT SPOTLIGHT CONTROLLED BY TIME CLOCK

TRIANGLE ARCHITECTS MARKUP - 16.07.2026

REV	DESCRIPTION	DATE
A	REVISED TO CONSTRUCTION ISSUE	06/10/2025

ISSUE

CONSTRUCTION

CLIENT

Rowlinson

PROJECT

RUSSELL ROAD - SHARED OWNERSHIP APARTMENTS

TITLE

GROUND & FIRST FLOOR COMBINED FIRE ALARM & EMERGENCY LIGHTING FOR BUILDING CONTROL

SCALE:	1:100 @ A1	DRAWN:	SG
DATE:	NOV 2024	CHECKED:	GM
DRAWING No.	P0257/SH/BC/0/1	REV:	A

TeDS (ELECTRICAL) LTD
ST MARK'S HOUSE, 29 WEST STREET,
DUKINFIELD, CHESHIRE, SK16 4PL
TEL: 0161 330 7506 EMAIL : design@tedsltd.co.uk