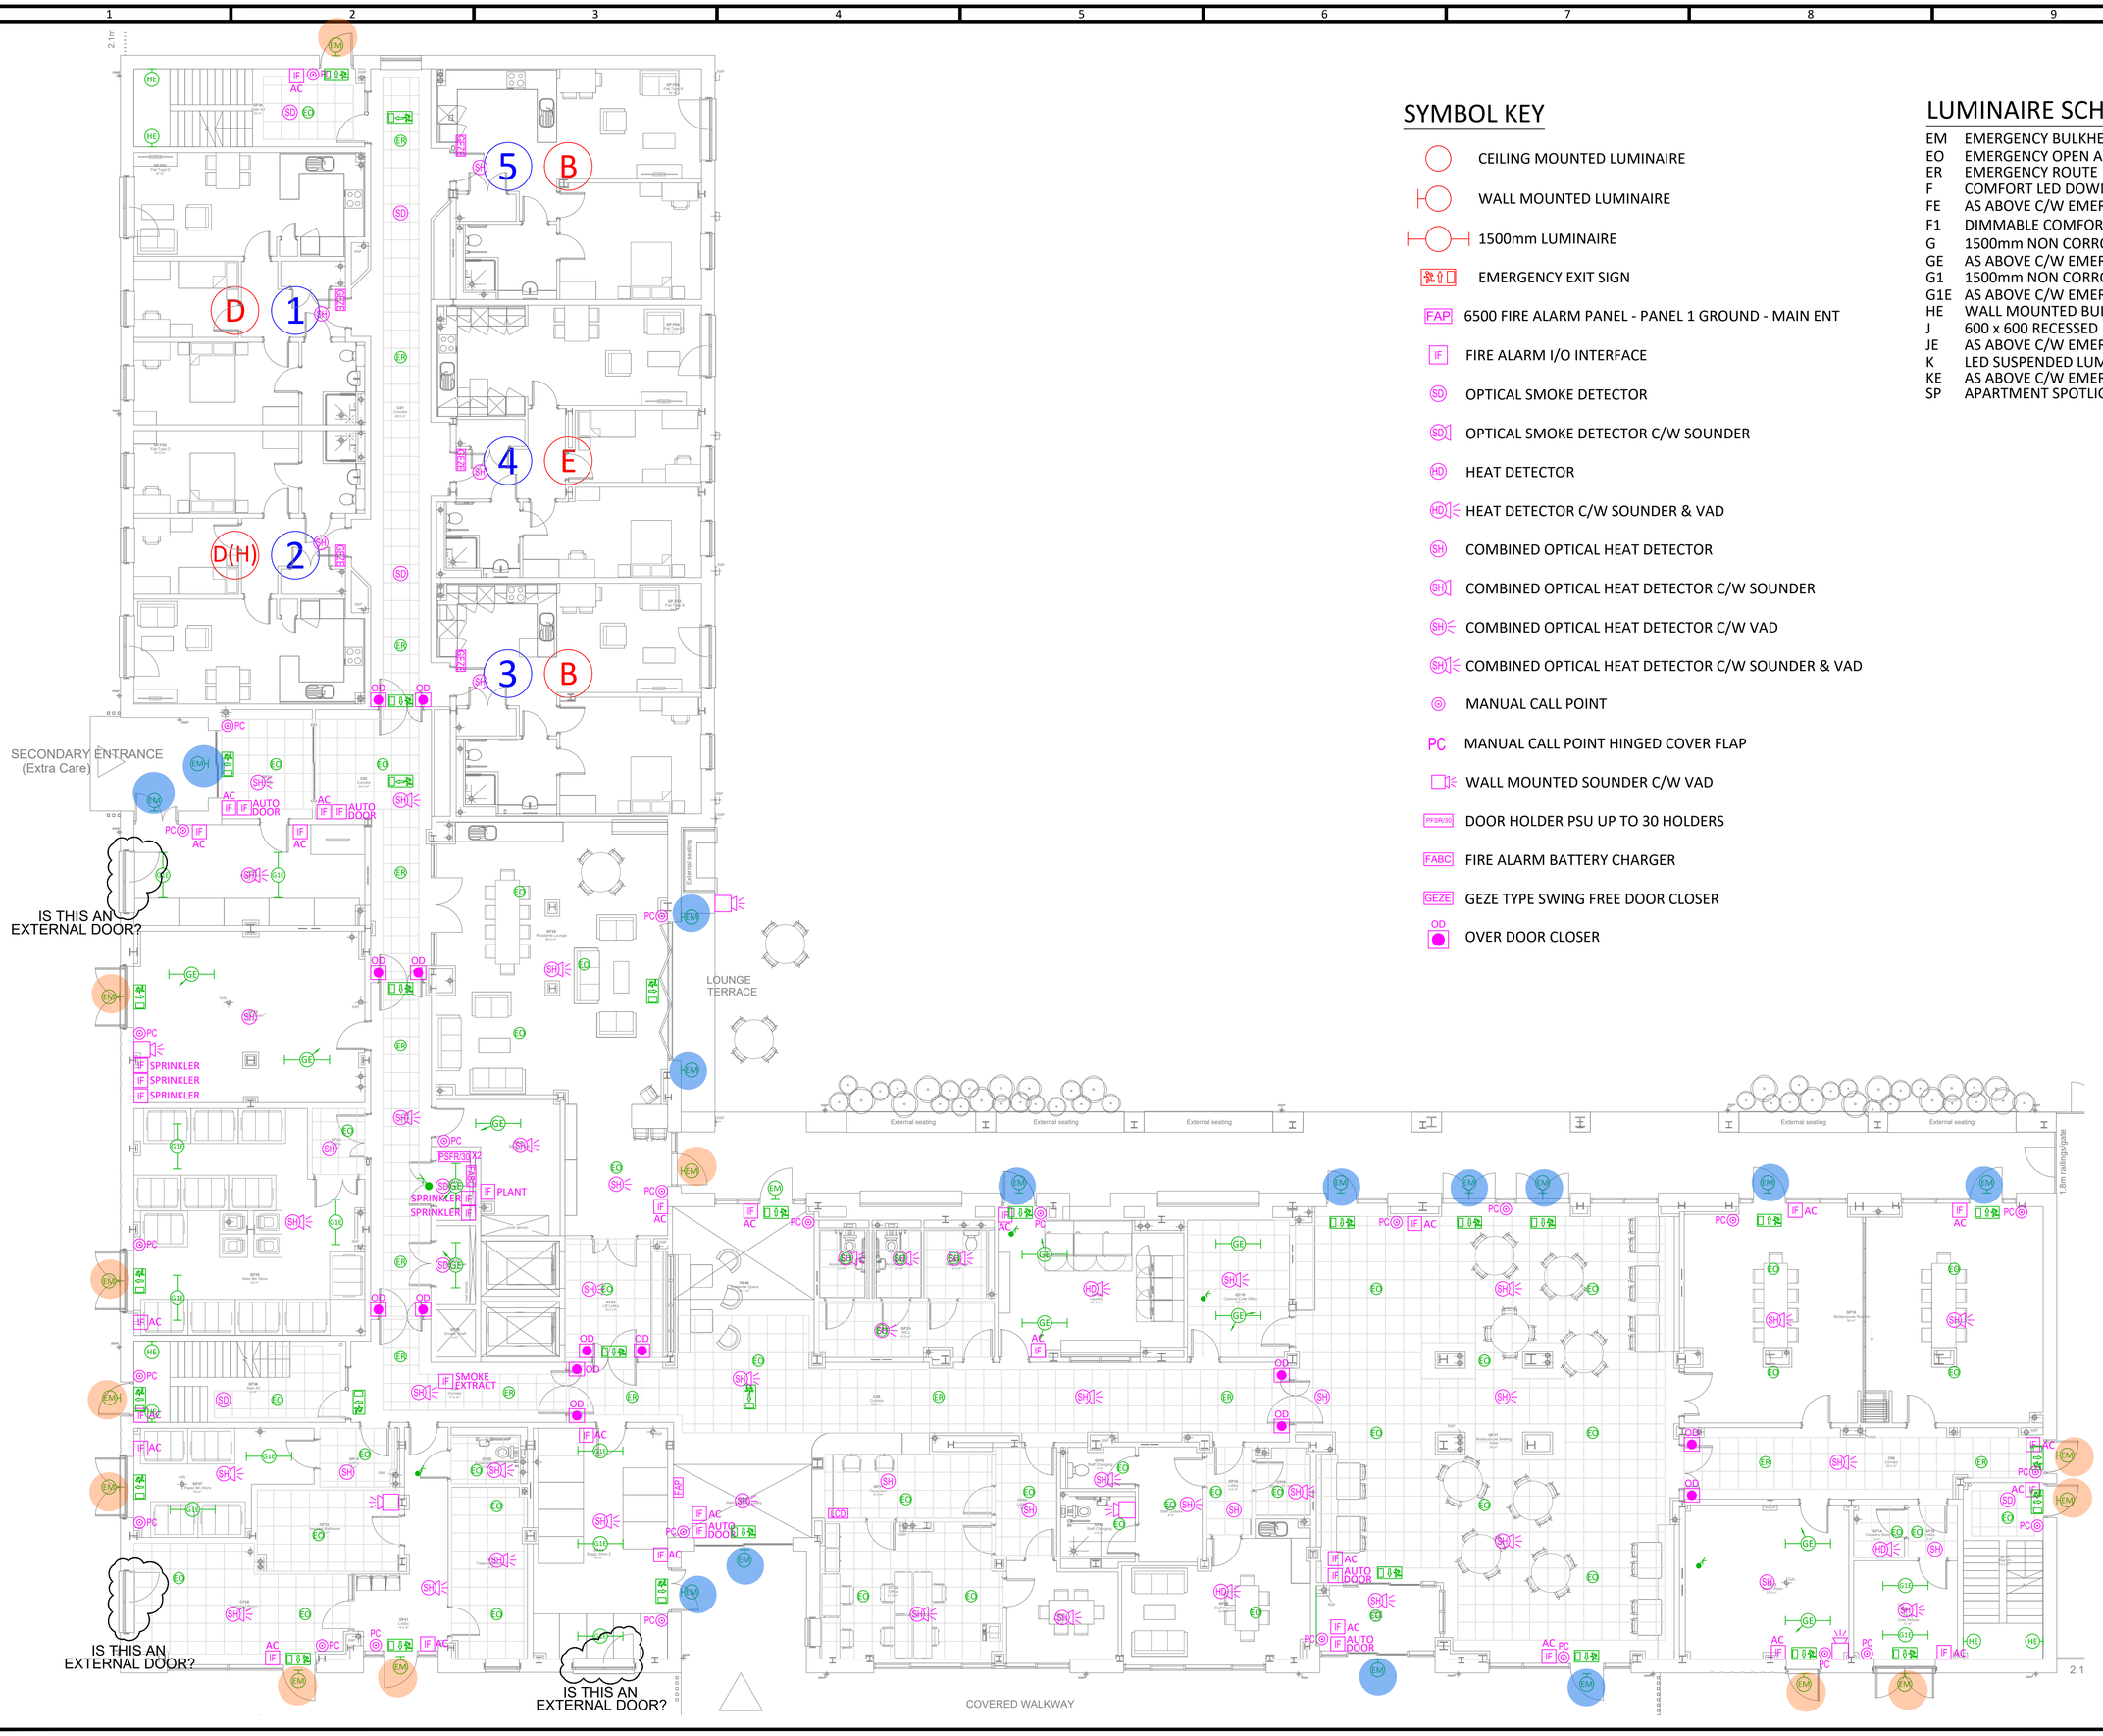


SYMBOL KEY

- CEILING MOUNTED LUMINAIRE
- WALL MOUNTED LUMINAIRE
- 1500mm LUMINAIRE
- EMERGENCY EXIT SIGN
- FAP — 6500 FIRE ALARM PANEL - PANEL 1 GROUND - MAIN ENT
- IF — FIRE ALARM I/O INTERFACE
- SD — OPTICAL SMOKE DETECTOR
- SD — OPTICAL SMOKE DETECTOR C/W SOUNDER
- HD — HEAT DETECTOR
- HD — HEAT DETECTOR C/W SOUNDER & VAD
- SH — COMBINED OPTICAL HEAT DETECTOR
- SH — COMBINED OPTICAL HEAT DETECTOR C/W SOUNDER
- SH — COMBINED OPTICAL HEAT DETECTOR C/W VAD
- SH — COMBINED OPTICAL HEAT DETECTOR C/W SOUNDER & VAD
- MANUAL CALL POINT
- PC — MANUAL CALL POINT HINGED COVER FLAP
- WALL MOUNTED SOUNDER C/W VAD
- PFSR/30 — DOOR HOLDER PSU UP TO 30 HOLDERS
- FABC — FIRE ALARM BATTERY CHARGER
- GEZE — GEZE TYPE SWING FREE DOOR CLOSER
- OD — OVER DOOR CLOSER

LUMINAIRE SCHEDULE

EM	EMERGENCY BULKHEAD
EO	EMERGENCY OPEN AREA
ER	EMERGENCY ROUTE
F	COMFORT LED DOWNLIGHT
FE	AS ABOVE C/W EMERGENCY
F1	DIMMABLE COMFORT LED DOWNLIGHT
G	1500mm NON CORROSIVE BATTEN
GE	AS ABOVE C/W EMERGENCY
G1	1500mm NON CORROSIVE BATTEN C/W MICROWAVE
G1E	AS ABOVE C/W EMERGENCY
HE	WALL MOUNTED BULKHEAD C/W EMERGENCY & MICROWAVE
J	600 x 600 RECESSED LED MOD
JE	AS ABOVE C/W EMERGENCY
K	LED SUSPENDED LUMINAIRE
KE	AS ABOVE C/W EMERGENCY
SP	APARTMENT SPOTLIGHT CONTROLLED BY TIME CLOCK

TRIANGLE ARCHITECTS MARKUP - 17.07.2026

REV	DESCRIPTION	DATE
-	-	-

ISSUE

PRELIMINARY

CLIENT

Rowlinson

PROJECT

RUSSELL ROAD - EXTRA CARE

TITLE

GROUND FLOOR COMBINED FIRE ALARM & EMERGENCY LIGHTING FOR BUILDING CONTROL

SCALE:	1:100 @ A1	DRAWN:	SG
DATE:	AUG 2025	CHECKED:	GM
DRAWING No.	P0257/EC/BC/0	REV:	-

TeDS (ELECTRICAL) LTD
ST MARK'S HOUSE, 29 WEST STREET,
DUKINFIELD, CHESHIRE, SK16 4PL
TEL: 0161 330 7506 EMAIL : design@tedsltd.co.uk