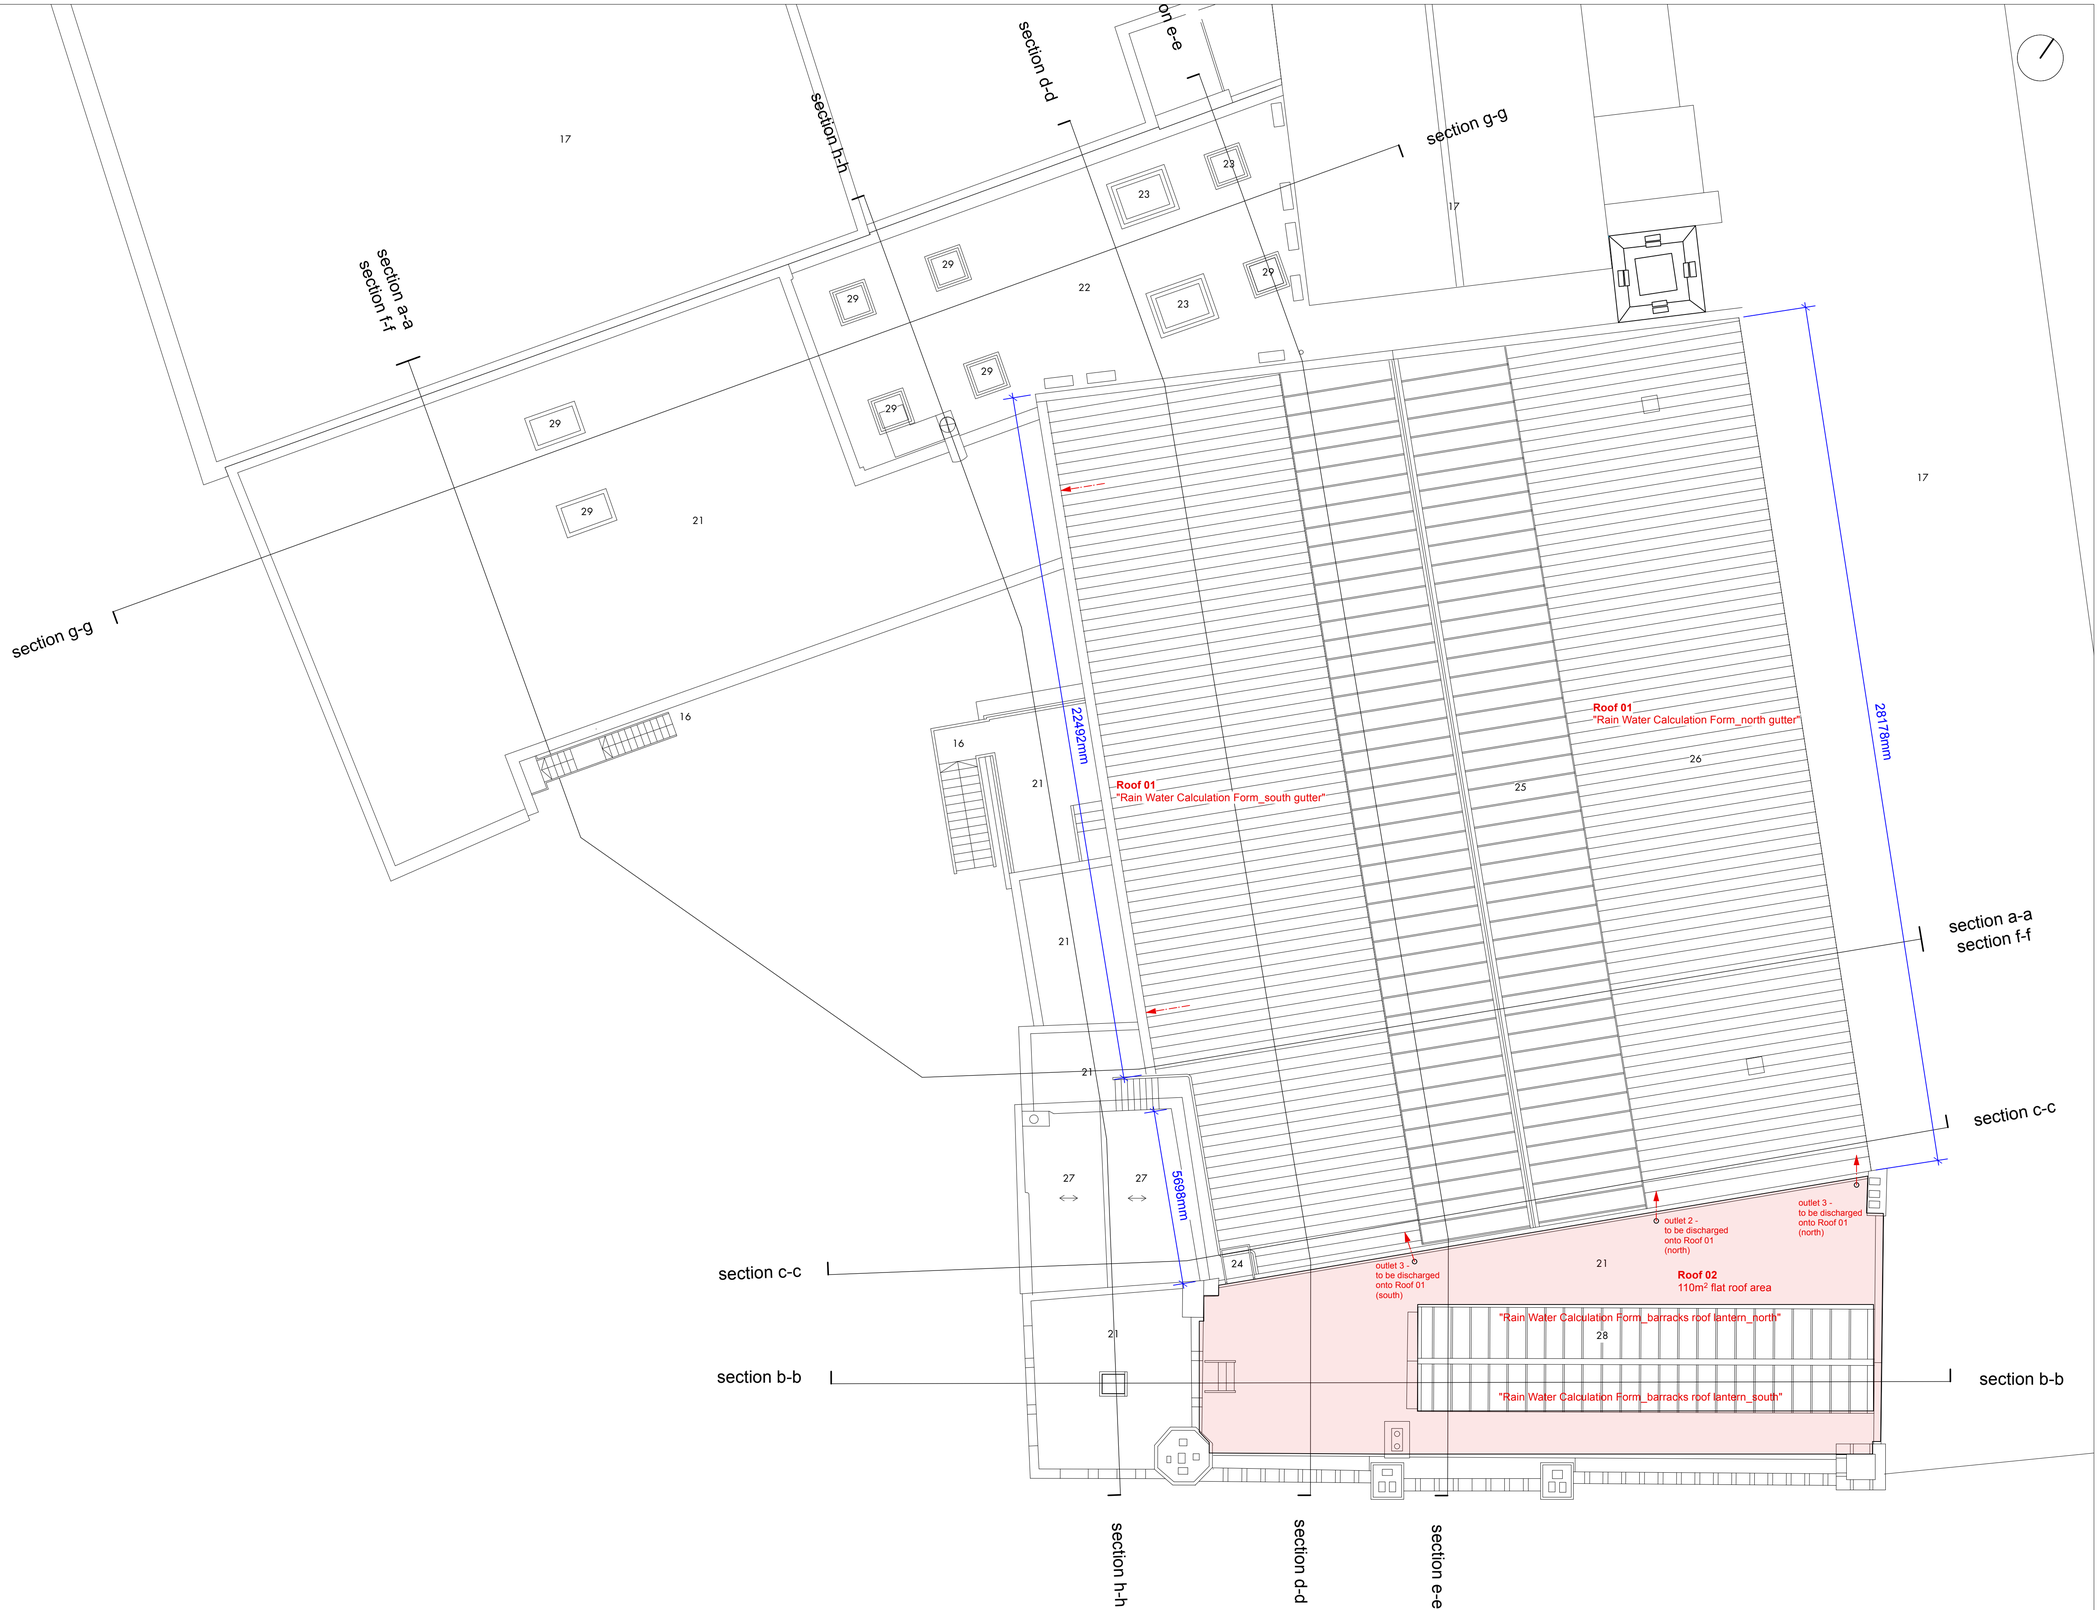


01	car park (adjoining owner)
02	garage entrance
03	car park (internal)
04	WCs
05	lobby
06	welcome area
07	store
08	corridor
09	children's group
10	nursery group
11	former armoury
12	room currently unoccupied
13	accommodation stair
14	former caretaker's apartment (currently unoccupied)
15	barracks building entrance
16	steel escape stair
17	adjacent property
18	worship space
19	former drill hall (currently unoccupied)
20	balcony
21	flat roof
22	existing plant area
23	skylight
24	ladder
25	drill hall roof light
26	metal sheet pitched roof
27	slate pitched roof
28	roof light to former officers' mess
29	skylight (blocked)
30	services riser

notes
for existing ga elevations refer to 009200 series drawings
for existing ga sections refer to 009300 series drawings
for alteration plans refer to 019100 series drawings

009105 existing • roof plan

shedkm
+44 (0)151 709 8211
+44 (0)207 253 8881

project	ardwick barracks
client	fabric church
drawing number	2411-SKM-Z0-ZZ-D-A-009106 **P01**
scale	1:100 @ A1
status	**information**

existing • roof plan_RWP markup

do not scale from this drawing • all dimensions are to be set out and checked on site prior to starting construction • any discrepancy found between information given on this drawing and that given elsewhere or recorded on site shall be brought to the attention of the project architect immediately