© London Studio Architecture Ltd


GENERAL NOTES

This drawing is for information only
Do not scale from drawing
All dimensions & levels to be checked on site
Any discrepancies to be reported to the Architect


DRAWING NOTES

ALL LAYOUTS & DIMENSIONS BASED ON RECORD DRAWINGS, NOT FROM MEASURED SURVEY - INACCURACIES / DISCREPANCIES MAY OCCUR.

REFER TO CONSULTANT INFORMATION FOR;
- STRUCTURAL ENGINEERING
- UTILITIES
- MEP SERVICES
- SECURITY SYSTEMS
- IT & COMMS

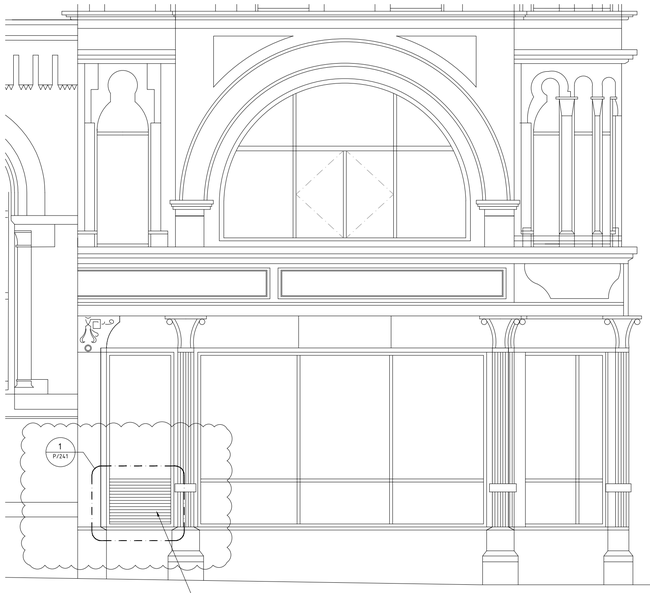


1. SALMON STREET ELEVATION

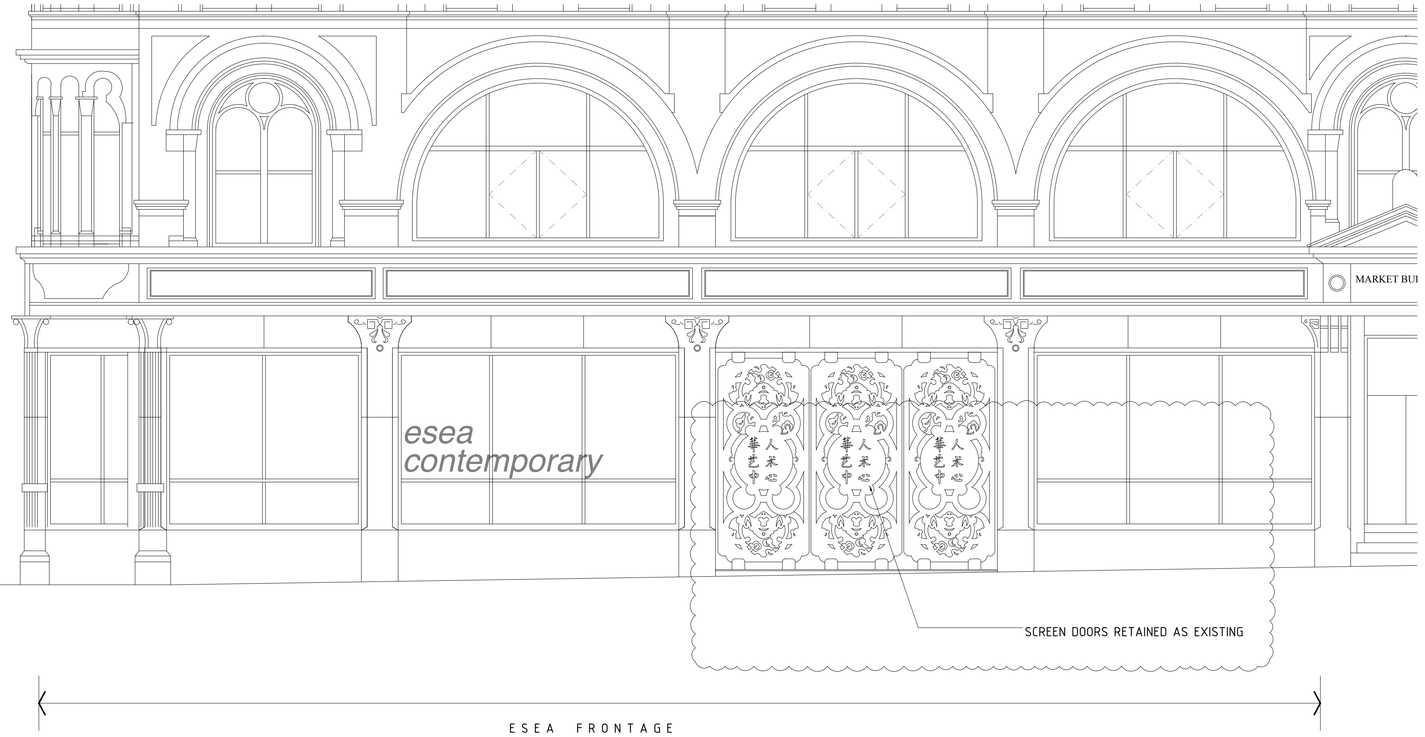

2. THOMAS STREET ELEVATION

0m 1m 5m

A 16.Jul.26 –
revision notes

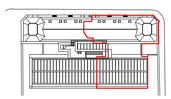

LONDON STUDIO ARCHITECTURE
07788 788198
www.londonstudioarchitecture.com

project
ESEA CONTEMPORARY

title
PROPOSED ELEVATIONS

status
FOR INFORMATION

scale 1:50@A1/1:100@A3
date 01.Jun.2026

dwg. no. LSA/079/PA/P/222
rev. A