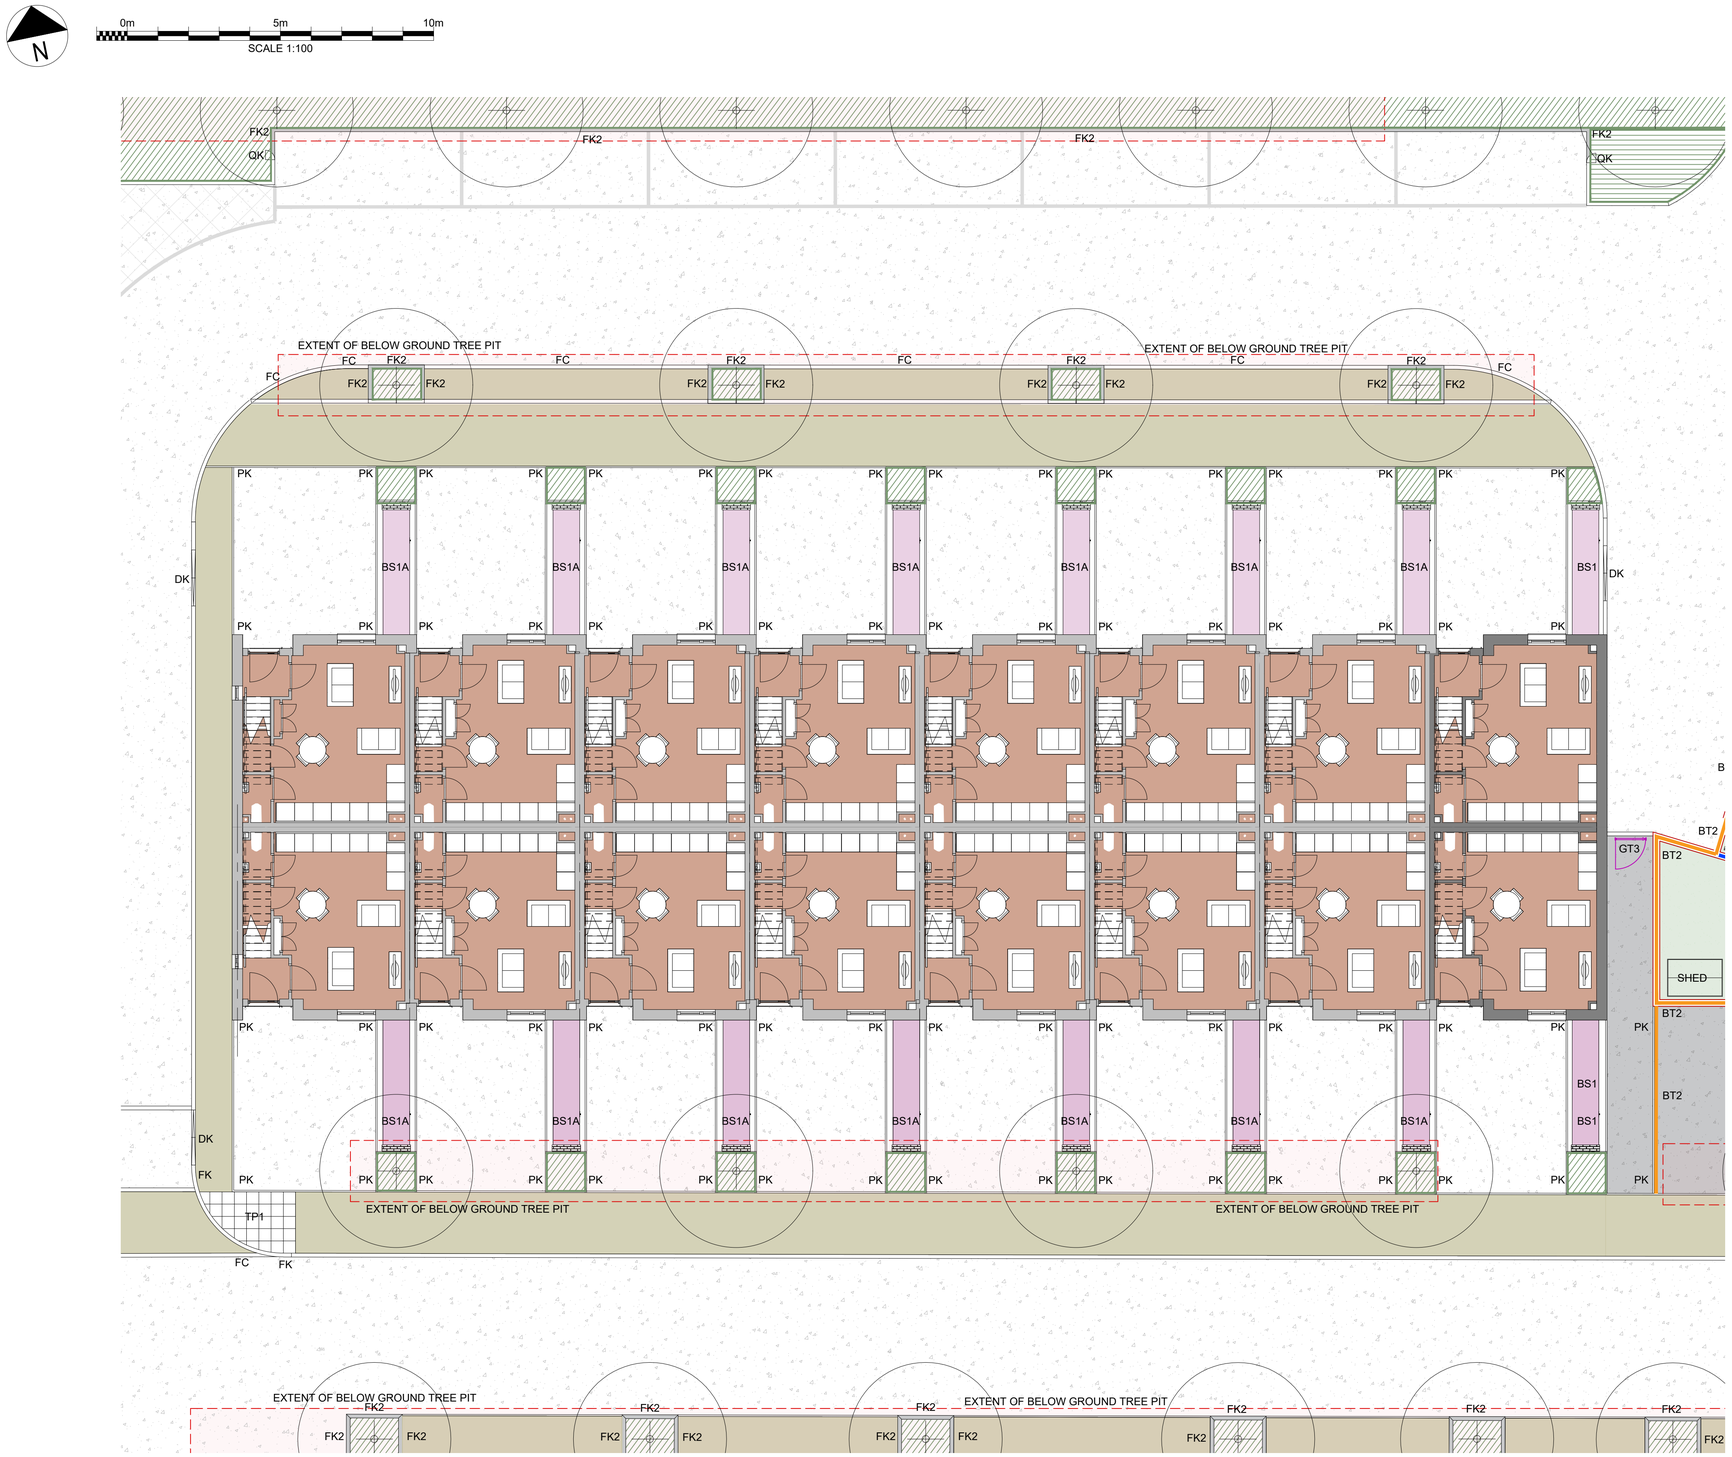


BELOW GROUND ELEMENTS

EXTENT OF BELOW GROUND TREE PITS
REFER TO TREE PIT DETAIL DRAWINGS AND SECTIONS
ELEMENTS TO BE INSTALLED TO SUPPLIERS DETAILS

KERBS/CHANNELS/EDGES

PK — PROPOSED PCC SQUARE PIN KERB
50MM WIDE X 150MM
CONTRACTOR TO CONTROL HAUNCH WITH SHUTTERING

HARD LANDSCAPE SURFACING

PROPOSED VEHICULAR GRADE ASPHALT
TO ENGINEERS SPECIFICATION

PROPOSED PEDESTRIAN GRADE ASPHALT
TO ENGINEERS SPECIFICATION

PROPOSED CONCRETE BLOCK PAVING
'FUSHION' BLOCK PAVING SUPPLIED BY TOBERMORE OSA
LAID STRETCHER BOND ROAD KERB TO PIN KERB IN A LACERTA PATTERN. BLOCK SIZE - 200MM X 100MM X 80MM
COLOURS - SILVER GREY AND MID GREY LAID 'LACERTA PATTERN'

PROPOSED CONCRETE FLAG PAVING
'TEXTURED FLAG' SUPPLIED BY TOBERMORE OSA
COLOUR NATURAL 600MM X 600MM X 40MM

TP1 — PROPOSED BLISTER TACTILE PAVING
COLOUR BUFF - SUPPLIED BY TOBERMORE OSA

HARD LANDSCAPE ELEMENTS

LP — PROPOSED VEHICULAR GRADE ASPHALT
TO ENGINEERS SPECIFICATION

BOUNDARY TREATMENTS

BW — PROPOSED DOUBLE SKIN BRICK WING/RETAINING WALL
WITH BRICK SOLDIER COURSE COPING - HEIGHT VARIES
ARCHITECT TO DETAIL TO MATCH BUILDINGS

BT1A — PROPOSED BOUNDARY TREATMENT TYPE 1A
TIMBER GRAVEL BOARD FENCE 1.8M HIGH
SUPPLIED BY 'JACKSON' OR SIMILAR APPROVED

BT1B — PROPOSED BOUNDARY TREATMENT TYPE 1B
CONCRETE GRAVEL BOARD FENCE 1.8M HIGH
SUPPLIED BY 'JACKSON' OR SIMILAR APPROVED

BT2 — PROPOSED BOUNDARY TREATMENT TYPE 2
TREATED FEATHERBOARD TIMBER FENCE 1.8M HIGH
SUPPLIED BY 'JACKSON' OR SIMILAR APPROVED
FIXED TO TOP OF WALL/RETAINING WALL TO ENGINEERS DETAIL

BT3 — PROPOSED BOUNDARY TREATMENT TYPE 3
FREESTANDING BRICK WALL 2.1M HIGH
TO ARCHITECTS DETAIL

BT4 — PROPOSED BOUNDARY TREATMENT TYPE 4
SECURA RETAINING WALL SUPPLIED BY TOBERMORE OR SIMILAR APPROVED - RETENTION HEIGHT VARIES
BOUNDARY TREATMENT TO BACK OF WALL AS SHOWN
ALL WALL AND FIXING DETAILS DETAILS TO ENGINEERS DESIGN

BT5 — PROPOSED BOUNDARY TREATMENT TYPE 5
FREESTANDING BRICK WALL 1.1M HIGH
TO ARCHITECTS DETAIL

AR2 — PROPOSED SENTRY METAL GARDEN RAILINGS
1280MM HEIGHT AND GALVANISED FINISH
SUPPLIED BY JACKSONS FENCING OR SIMILAR APPROVED

S1 — PROPOSED SLATTED TIMBER SCREEN
STYLE TO MATCH BIN STORE TO ARCHITECTS DETAIL
HEIGHT TO MATCH ADJACENT GREEN SCREEN CIRCA 1.1M

ME — PROPOSED METAL EDGING
EXCELEDGE ALUEXCEL 75MM EDGING. GALVANISED FINISH
SUPPLIED BY KINLEY OR SIMILAR APPROVED

GT1 — PROPOSED GATE TYPE 1 SINGLE LEAF TIMBER
GATE TO MATCH BT1 - FEATHERBOARD FENCING

GT2 — PROPOSED GATE TYPE 2 - 1.8M HIGH DOUBLE LEAF STEEL GATE
'BARBICAN GATE' - COLOUR 'BLACK'
SUPPLIED BY 'JACKSONS FENCING' OR SIMILAR APPROVED

GT3 — PROPOSED GATE TYPE 3 - 1.8M HIGH SINGLE LEAF STEEL GATE
'BARBICAN GATE' - COLOUR 'BLACK'
SUPPLIED BY 'JACKSONS FENCING' OR SIMILAR APPROVED

CB — PROPOSED COLLAPSIBLE HINGED BOLLARD 60MM DIAM. 620MM HIGH
HASLINGTON FOLD DOWN BOLLARD - COLOUR YELLOW
SUPPLIED BY BROXAP OR SIMILAR APPROVED

EV — PROPOSED ELECTRIC VEHICLE CHARGING POINT
SPECIFIED BY OTHERS - REFER TO MEP PLANS

DH — PROPOSED DOOR PROTECTION HOOP
SUPPLIED BY BROXAP OR SIMILAR APPROVED
LENGTH 800MM HEIGHT 1320MM FINISH - POWDER COATED RAL 7016

BE1 — PROPOSED BENCH
'FURNITUBES' FORTIS 4 PERSON BENCH OR SIMILAR
WITH BACK REST AND END AND CENTRE ARMS

ANCILLARY BUILDINGS:

BIN/BIKE STORE VARIOUS TYPES/COMBINATIONS
DESIGNED BY OTHERS
REFER TO ARCHITECTS DETAILS

SHED — PROPOSED TIMBER GARDEN SHED
4FT X 6FT 'OVERLORD' MODULAR SHED
SUPPLIED BY 'DUNSTER HOUSE OR SIMILAR APPROVED
CONCRETE BASE TO SUPPLIERS RECOMMENDED DETAIL

SOFT LANDSCAPING

PROPOSED SPECIMEN TREE
REFER TO SOFT LANDSCAPE PLANS FOR SPECIES AND SIZES
REFER TO TREE PIT DETAILS FOR INSTALLATION

PROPOSED SPECIMEN SMALL TREE
REFER TO SOFT LANDSCAPE PLANS FOR SPECIES AND SIZES
REFER TO TREE PIT DETAILS FOR INSTALLATION

PROPOSED LIGUSTRUM OVALIFOLIUM HEDGE
PLANTED AT 3 PLANTS/LIN M IN A 10L POT

PROPOSED AMENITY SHRUB PLANTING
HATCHES DENOTE SPECIES SEPARATION

PROPOSED LAWN AREASTO BE TURFED
CLIENT MAY OPT TO SEED LARGER AREAS

GS1 — PROPOSED INSTANT GREEN SCREEN 1M HIGH
SUPPLIED BY MOBILANE OSA
HEDERA WOERNER VARIETY

GS2 — PROPOSED INSTANT GREEN SCREEN 1.8M HIGH
SUPPLIED BY MOBILANE OSA
HEDERA WOERNER VARIETY

SQUARE YARD
Landscape Architecture - Urban Design - Masterplanning
Email - studio@sqryrd.co.uk
Web - www.squareyard.info
Tel - 0161 943 6053
Address:
SQR YRD LTD.
Kingfisher Business Centre,
Rossendale, BB4 8EQ

GENERAL NOTES:

1. DIMENSIONS GOVERN
2. ALL DIMENSIONS ARE IN MILLIMETERS UNLESS NOTED OTHERWISE ON THE DRAWINGS
3. ALL DIMENSIONS SHALL BE VERIFIED ON SITE PRIOR TO ANY CONSTRUCTION
4. SQUAREYARD SHALL BE NOTIFIED OF ANY DISCREPANCIES

DRAWING NOTES:

REV	DESCRIPTION	DRAWN	CHECKED	DATE
C1	ISSUED FOR CONSTRUCTION	MG	AV	13/10/2025
C2	AS-BUILT	MG	AV	19/06/2026

PROJECT TITLE
COLLYHURST VILLAGE
ROCHDALE ROAD
MANCHESTER

DRAWING TITLE
PLOT C2 - EXTERNAL WORKS
DETAILED GENERAL ARRANGEMENT

SCALE @ A1
1:100

DATE CREATED
OCT 2025

PROJECT NUMBER
8871

DRAWING No.
CH01-SY-00-GF-DR-L-(03)002

REVISION
C2