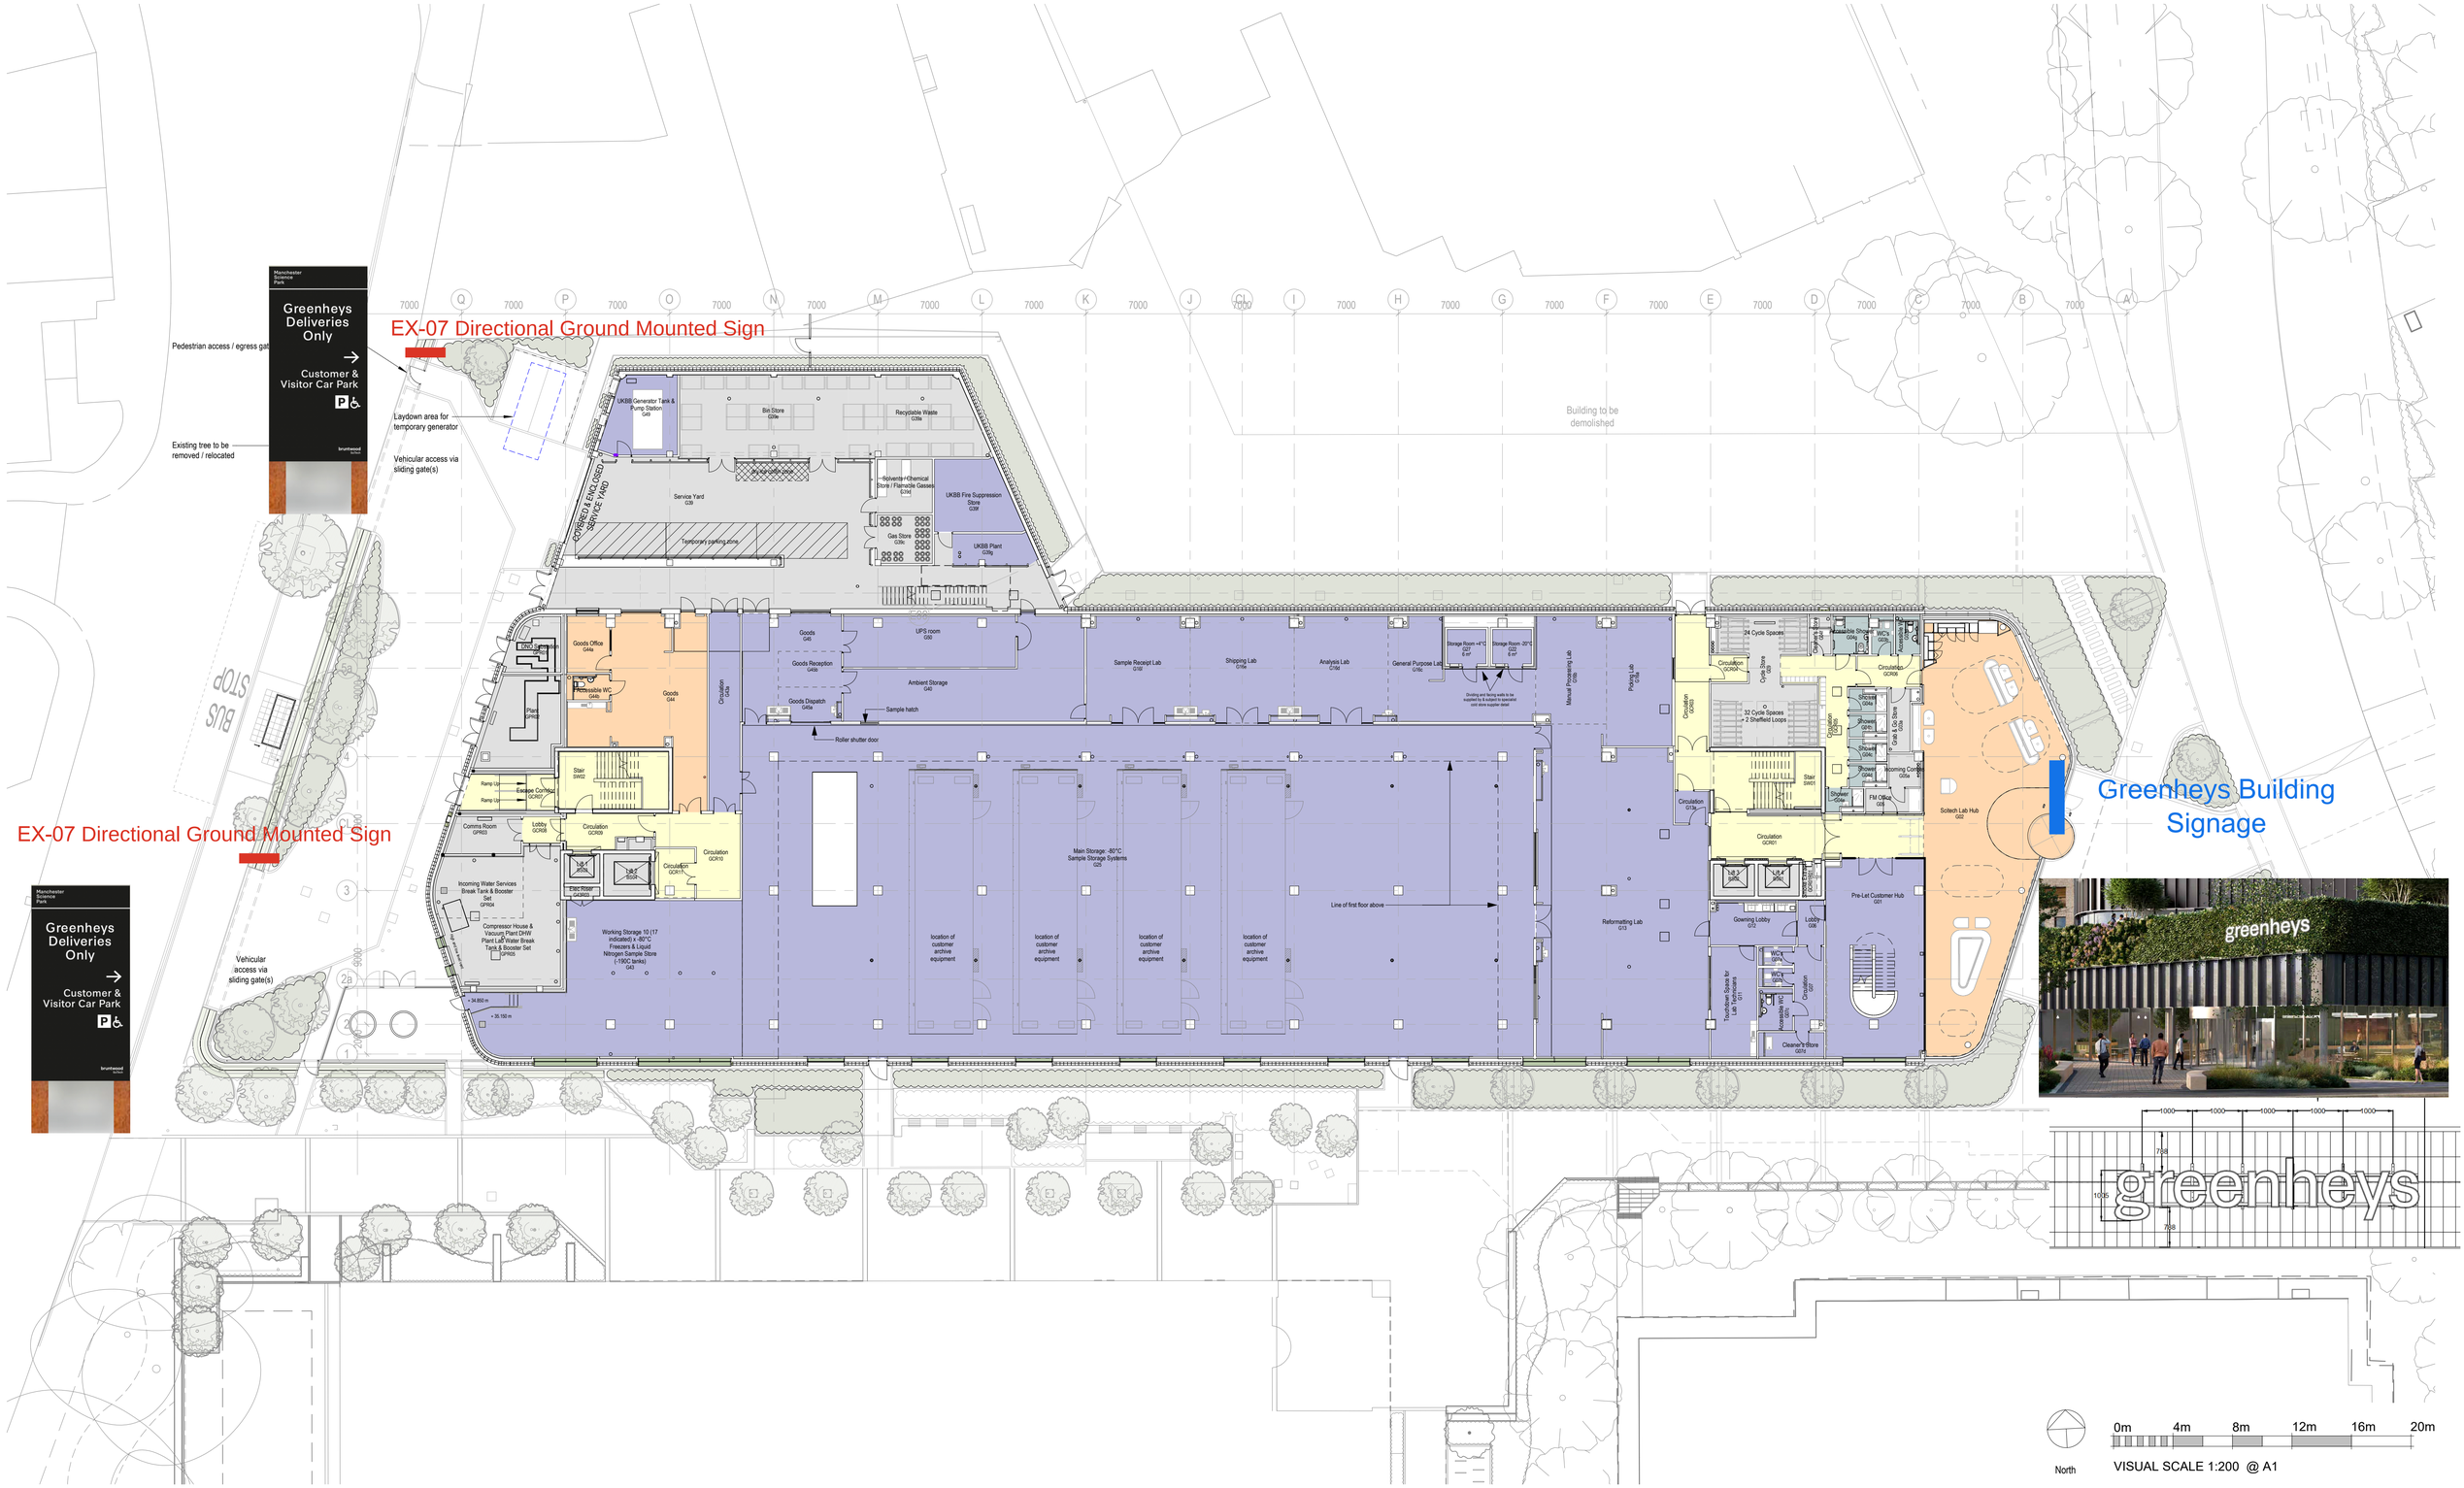


BUILDING DESIGN PARTNERSHIP SHALL HAVE NO RESPONSIBILITY FOR ANY USE MADE OF THIS DOCUMENT OTHER THAN FOR THAT WHICH IT WAS PREPARED AND ISSUED.

ALL DIMENSIONS SHOULD BE CHECKED ON SITE. DO NOT SCALE FROM THIS DRAWING

ANY DRAWING ERRORS OR DIVERGENCIES SHOULD BE BROUGHT TO THE ATTENTION OF BUILDING DESIGN PARTNERSHIP AT THE ADDRESS SHOWN BELOW.

DRAWINGS SHALL BE READ IN CONJUNCTION WITH THE FOLLOWING BEFORE WORK COMMENCES:

- THE CDM DESIGN ISSUES REGISTER
- THE BDP RISK SERIES OF DRAWINGS
- THE PROJECT CDM RISK REGISTER

SUBJECT TO DESIGN DEVELOPMENT, SURVEY, CONSULTANT INPUT & STATUTORY APPROVAL.

NOTES

For CAT C items refer to 72 series drawings.

REVISION	DESCRIPTION	DRAWN	CHECKED	DATE
C02	General Updates	PE	PE	11.09.25
C01	Window sizes reduced by 250mm in accordance with the contractor's specified changes, updated to reflect buffer vessel relocation as a result of BIOs change	OM	PE	12/02/25
P37	General Updates	OM	PE	18.12.24
P36	WC layouts updated as per WC Layout Coordination Mark-ups (issued 15.05.24)	OM	MH	18.07.24
P35	UKBB precontract notes omitted. SVP boxing out to lab lobby omitted. SVP reposition to end of nib wall as indicated. FFE layout updated to labs (G16a-f). See GRE-BDP-ZZ-00-DR-A-7210. Boxing out to bike store added to new incoming services.	MH	PE	18.06.24
P34	Items to be developed post contract annotated & as clouded	PE	MH	06.03.24
P33	Boxing out added, omitted or amended as indicated	MH	PE	26.01.24
P32	Room number review & update	PE	PE	15.01.24

KEYPLAN

CLIENT

MSP MANCHESTER SCIENCE PARTNERSHIPS

BDP.

11 Ducie Street
PO Box 85
Piccadilly Basin
Manchester
M60 3JA
United Kingdom

T +44 (0)161 828 2200
www.bdp.com

PROJECT TITLE: MSP Greenheys (Private & Confidential)

BDP JOB NUMBER: P3001624

DRAWING TITLE: General arrangement - Ground floor

SCALE: @ A1 1 : 200

DATE FIRST ISSUED: June 22

DRAWING No: GRE-BDP-ZZ-00-DR-A-20001

REVISION: C02