


Boundaries

(red line)	Jersey St works boundary
(magenta line)	Jersey Wharf works boundary

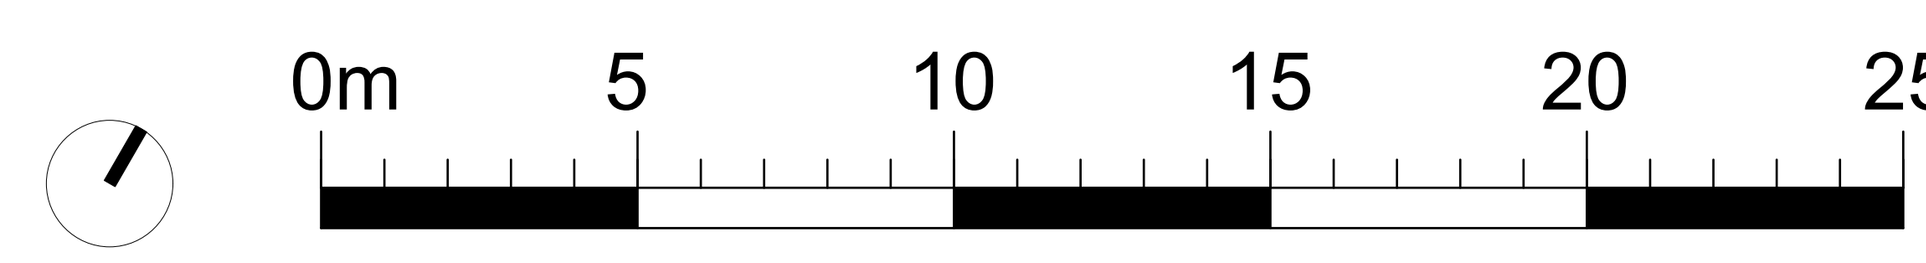

© This drawing is copyright protected and may not be reproduced in whole or part without written authority from the owner.

NOTES:
1. Do not scale from this drawing; always work to noted dimensions.
2. All setting out, levels and dimensions to be agreed on site.
3. All dimensions are in millimetres unless otherwise stated.
4. The dimensions of all materials must be checked on site before being laid out.
5. This drawing must be read with the relevant specification clauses and detail drawings.
6. Order of construction and setting out to be agreed on site.

LOCATION PLAN

Generall arrangement plan to be read in conjunction with drawings:
2895G-PLA-XX-XX-DR-L-1000
2895G-PLA-XX-XX-DR-L-1002
2895G-PLA-XX-XX-DR-L-2000
2895G-PLA-XX-XX-DR-L-2001
2895G-PLA-XX-XX-DR-L-3000
2895G-PLA-XX-XX-DR-L-4000

Revision Notes
1 - Granite setts ST2 omitted from MCL scope of works boundary

2 - Granite banding omitted from the MCL scope of works boundary

Revision	Date	Description	Drawn	Apprvd.
C01	23/01/2026	Construction issue	AS	AS
P05	06/08/2025	Tender issue	AS	AS
P04	18/07/25	For information	AS	AS
P03	14/07/2025	for Coordination	AS	AS
P02	08/07/2025	For information	AS	AS

PLANIT

Manchester | Gloucestershire | Leeds | Liverpool | London

Manchester
2 Back Grafton Street
Altrincham
Cheshire
WA14 1DY

W: planit-ie.com
E: info@planit-ie.com
T: 0161 928 9281

Client MCC

Project Jersey Street Bridge

Drg Title Jersey Street Bridge General Arrangement

Created on	Created by	Approved by
01-07-25	AS	AS

Scale	Size	Workstage
1:200	A1	RIBA 5

Drg No.	Suitability	Revision
2895G-PLA-XX-XX-DR-L-0001	D4	C01

© Planit I.E. Limited