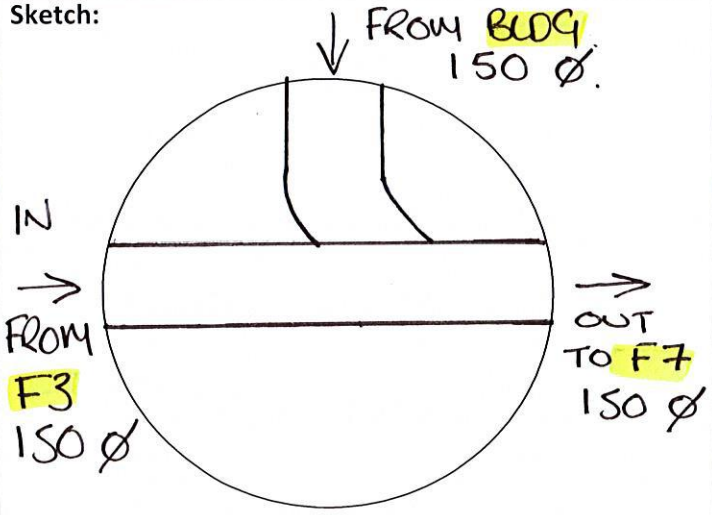
MURRAYWOOD CONSTRUCTION LTD

QA Form - Manholes

Installation of Manhole			Sheet No:	3.
Project	C376 WITHINGTON CDC		**Date:**	28/04/2025
Location: **As built coordinates:** **Cover Level:**	FW 4 383764.523 391996.478	**Drawing No:**	22182-CCS-WCH006-XX-DR-S-93000	
Manhole No: **Invert:**	FW 4 31.341 31.338 BAM.	**Type:** **(circle as appropriate)**	FOUL/~~SURFACE WATER/COMBINED~~	
Inverts and Diameter of pipes:	Upstream: Dia: 150 DIA Downstream: Dia: 150 DIA Inlet 1: 150 DIA Dia: Inlet 2: 150 DIA Dia: Inlet 3: Dia: Inlet 4: Dia: Inlet 5: Dia:	**Sketch:**	 PPIC ALL OTHER CONNECTIONS CAPPED. Position of step irons/fittings, orientation of cover/slab and branches (including backdrops) to be detailed.	
Chamber Details:	Dia. Size: 450 PPIC Overall depth: 1489 Cover Depth: 100 Biscuit Depth: 100 Reducing Slab: NA			

WORK TO BE INSPECTED	Accepted Yes/ No or N/a	Comments	MW Construction Eng/QA Signed as Checked:-
Setting out to drawing	YES		[redacted]
Trench excavation supported	YES		
Installation of concrete to channel	NA	PPIC	

MURRAYWOOD CONSTRUCTION LTD

QA Form - Manholes

Installation of drainage channel/first manhole ring	YES	PPIC	[redacted]	
MWC Signature confirming invert/positioning check	[redacted]		**Date**	**24/06/2025**
Client Signature confirming invert/positioning check			**Date**	24/7/25

WORK TO BE INSPECTED	**Accepted Yes/ No or N/A**	**Comments**	**MW Construction Eng/QA Signed as Checked:-**
Installation of manhole rings to required levels	YES	Depths and No's of rings:	[redacted]
Installation of dropshafts/inlets above manhole invert	NA		
Manhole Surround	YES	Details: CONCRETE	
Backfilling to manhole to required level and layers as instructed in spec	YES		
Biscuit Installation	NA	Type: PPIC	
Benching/Water proofing to Manhole		NA PPIC	
Installation of Step Irons	NA	Type & Numbers: PPIC	
Brickwork		No of courses:	
Lid and Frame	YES	Cover Type: D400 600 X 600 X 100	
Client Signature confirming Handover of Manhole:-	[redacted]	**Date**	18/9/25

MURRAYWOOD CONSTRUCTION LTD	**QA Form - Manholes**

MWC Signature confirming Handover of Manhole:-	[redacted]	**Date**	24/06/2025



MURRAYWOOD CONSTRUCTION LTD

QA Form - Manholes

