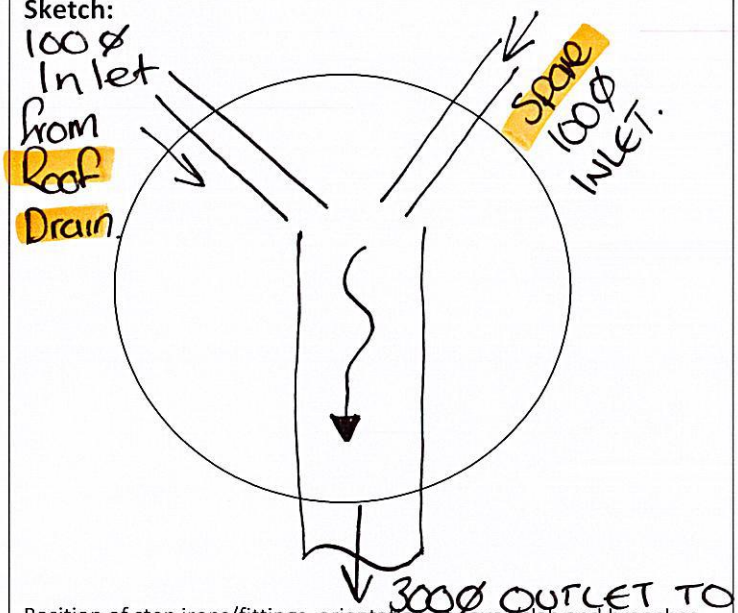
MURRAYWOOD CONSTRUCTION LTD

QA Form - Manholes

Installation of Manhole			Sheet No:	2.
Project	C376 WITHINGTON CDC		**Date:**	28/04/2025
Location: **As built coordinates:** **Cover Level:**	S1 383737.756 392030.818	**Drawing No:**	22182-CCS-WCH006-XX-DR-S-93000	
Manhole No: **Invert:**	MH S1 31.846 BAM 31.858.	**Type:** **(circle as appropriate)**	~~FOUL~~/SURFACE WATER/~~COMBINED~~	
Inverts and Diameter of pipes:	Upstream: END OF LINE Dia: N/A Downstream: 31.846 Dia: 300mm Inlet 1: 31.950 Dia: 100mm Inlet 2:31.950 Dia:100mm Inlet 3: Dia: Inlet 4: Dia: Inlet 5: Dia:	**Sketch:**		
Chamber Details:	Dia. Size: Overall depth: Cover Depth: Biscuit Depth: Reducing Slab:	Position of step irons/fittings, orientation of cover/slab and branches (including backdrops) to be detailed.	MHSW-4.	

WORK TO BE INSPECTED	Accepted Yes/ No or N/a	Comments	MW Construction Eng/QA Signed as Checked:-
Setting out to drawing	Yes	Given Level on drawing incorrect laid to grade Δ400.	[redacted]
Trench excavation supported	Yes	Stepped as required	
Installation of concrete to channel	Yes	+ Half Barrel Pipe Installed	
Installation of drainage channel/first manhole ring	Yes		

MURRAYWOOD CONSTRUCTION LTD	QA Form - Manholes

MWC Signature confirming invert/positioning check	[redacted]	**Date**	25/06/2025
Client Signature confirming invert/positioning check		**Date**	26/6/2025

WORK TO BE INSPECTED	Accepted Yes/ No or N/A	Comments	MW Construction Eng/QA Signed as Checked:-
Installation of manhole rings to required levels	Yes	Depths and No's of rings: 1x 1500 x 500	[redacted]
Installation of dropshafts/inlets above manhole invert	yes		
Manhole Surround	Yes	Details: Concrete	
Backfilling to manhole to required level and layers as instructed in spec	Yes		
Biscuit Installation	Yes	Type: 150mm PCC	
Benching/Water proofing to Manhole			
Installation of Step Irons	NA	Type & Numbers: Shallow Manhole	
Brickwork		No of courses:	
Lid and Frame		Cover Type:	
Client Signature confirming Handover of Manhole:-		**Date**	

MURRAYWOOD CONSTRUCTION LTD	**QA Form - Manholes**

MWC Signature confirming Handover of Manhole:-	B.H	**Date**	25/06/2025

