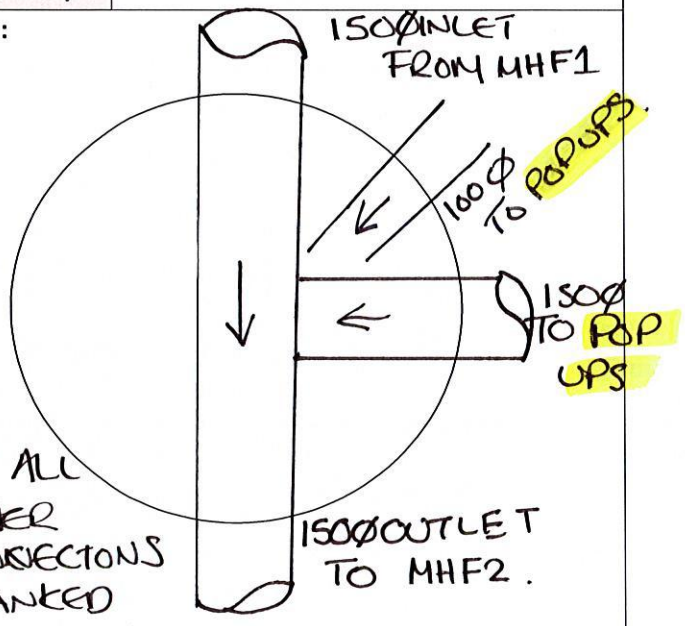
MURRAYWOOD CONSTRUCTION LTD

QA Form - Manholes

Installation of Manhole			Sheet No:	10.
Project	C376 WITHINGTON CDC		**Date:**	28/04/2025
Location: **As built coordinates:** **Cover Level:**	F8 383738.122 391999.734 32.830	**Drawing No:**	22182-CCS-WCH006-XX-DR-S-93000	
Manhole No: **Invert:**	F8 31.631 ✓ to.	**Type: (circle as appropriate)**	FOUL/~~SURFACE WATER/COMBINED~~	
Inverts and Diameter of pipes:	Upstream: 31.639 Dia: 150 DIA Downstream: 31.627 Dia: 150 DIA Inlet 1: 31.672 Dia:150 DIA Inlet 2: 31.701 Dia:100DIA Inlet 3: Dia: Inlet 4: Dia: Inlet 5: Dia:	**Sketch:**	 Position of step irons/fittings, orientation of cover/slab and branches (including backdrops) to be detailed.		
Chamber Details:	Dia. Size: 450PPIC Overall depth: 1199MM Cover Depth: 100MM Biscuit Depth: NA Reducing Slab: NA			

WORK TO BE INSPECTED	Accepted Yes/ No or N/a	Comments	MW Construction Eng/QA Signed as Checked:-
Setting out to drawing	YES	CENTRE LINE OF LINE MOVED TO ALLOW WORKING ROOM	[redacted]
Trench excavation supported	YES	STEPPED AS REQUIRED	
Installation of concrete to channel	YES	BENEITH PPIC UNIT	
Installation of drainage channel/first manhole ring	YES		

QA Form - Manholes

MWC Signature confirming invert/positioning check	[redacted]	**Date**	**26/06/2025**
Client Signature confirming invert/positioning check		**Date**	18-9-25

WORK TO BE INSPECTED	**Accepted Yes/ No or N/A**	**Comments**	**MW Construction Eng/QA Signed as Checked:-**
Installation of manhole rings to required levels	NA	Depths and No's of rings: PPIC	[redacted]
Installation of dropshafts/inlets above manhole invert	YES	PPIC	
Manhole Surround	YES	Details: CONCRETE	
Backfilling to manhole to required level and layers as instructed in spec	YES		
Biscuit Installation		Type:	
Benching/Water proofing to Manhole	YES	SHAFT SEALING RING USED	
Installation of Step Irons	NA	Type & Numbers: PPIC	
Brickwork		No of courses:	
Lid and Frame			

Client Signature confirming Handover of Manhole:-	[redacted]	**Date**	18/9/25
MWC Signature confirming Handover of Manhole:-		**Date**	18/9/2025



MURRAYWOOD
CONSTRUCTION LTD

QA Form - Manholes

