
0 5 10 20 50m

Scale 1:250

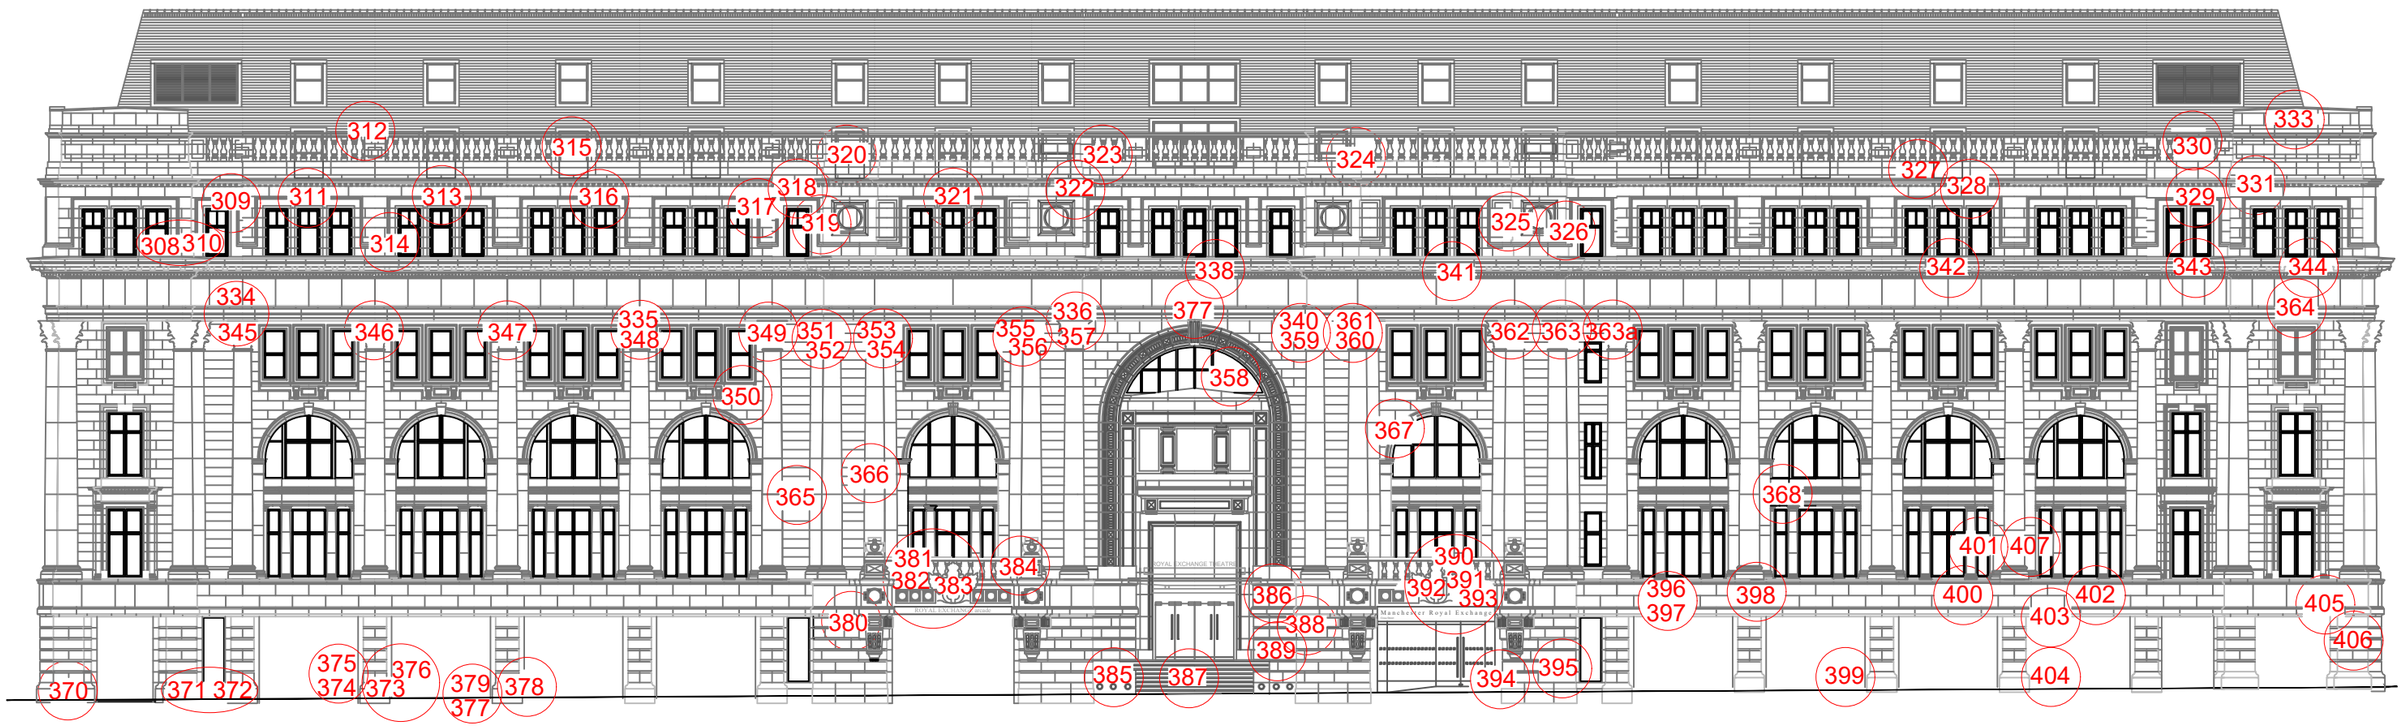


# ELEVATION TO CROSS STREET


STONE CENTRAL

STONE CENTRAL (NW) LTD

STONEMASONRY . RESTORATION . CONSERVATION

Dutch Barn, Hall Lane, Bold, St Helens, WA9 4SJ
Tel: 01744 820 511 Email: info@stonecentral.co.uk
Website: www.stonecentral.co.uk


**Project:**

ROYAL EXCHANGE
MANCHESTER

**Title:**

MARKED UP SURVEY
ELEVATION DRAWING
CROSS STREET

| Scale : | Date : | Drawn : |
|---|---|---|
| 1:250 @ A3 | AUG 2026 | |

| Drawing No : | Revision : |
|---|---|
| SC_RE_03 | |

STONE CENTRAL (NW) LTD COPYRIGHT ©