
0 5 10 20 50m

Scale 1:200

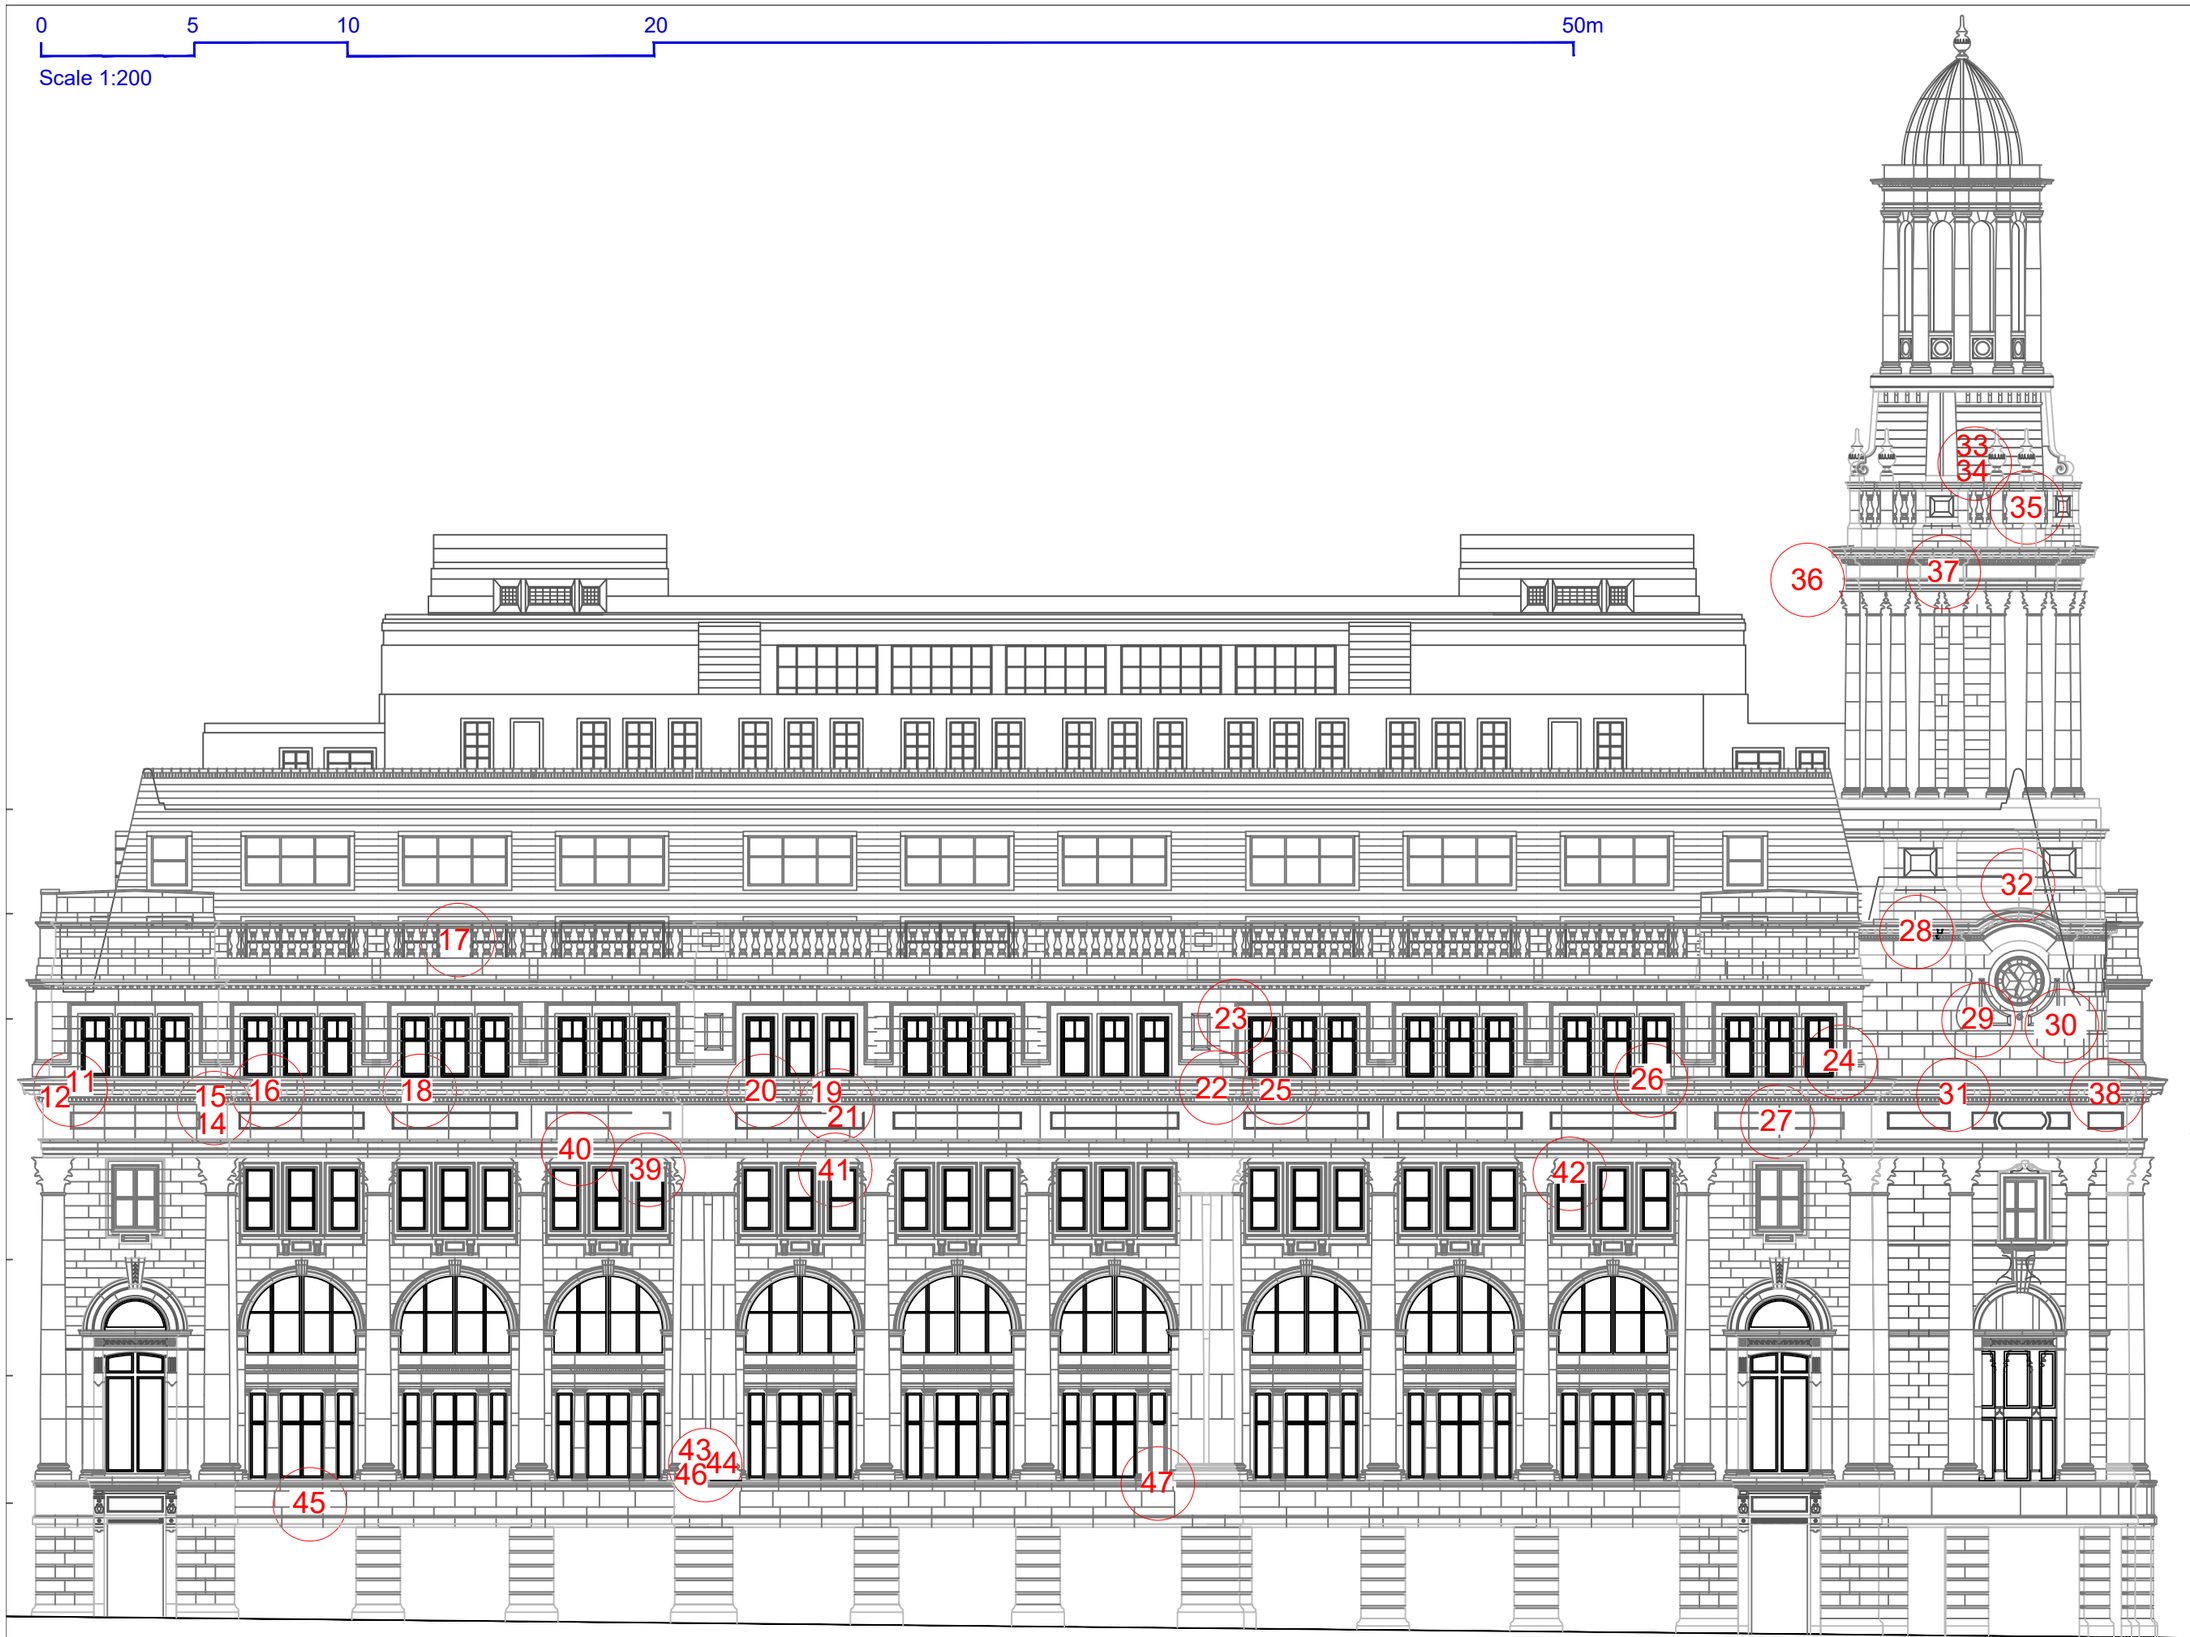

ELEVATION TO MARKET STREET

STONE CENTRAL

STONE CENTRAL (NW) LTD
STONEMASONRY . RESTORATION . CONSERVATION

Dutch Barn, Hall Lane, Bold, St Helens, WA9 4SJ
Tel: 01744 820 511 Email: info@stonecentral.co.uk
Website: www.stonecentral.co.uk

Project:
ROYAL EXCHANGE
MANCHESTER

Title:
MARKED UP SURVEY
ELEVATION DRAWING
MARKET STREET

Scale :	Date :	Drawn :
1:200@ A3	AUG 2026	

Drawing No :	Revision :
SC_RE_01	

STONE CENTRAL (NW) LTD COPYRIGHT ©