

FWP UK Ltd

Copyright Notice:
This drawing and any design theron is the copyright of **FWP UK Ltd** and must not be reproduced without written consent

AIR HA


**CU1**
**GROUND FLOOR**
**CONDENSING UNIT**
**20kW**
**Height 1526mm**
**Width 940mm**
**Depth 340mm**
**Net weight 118kg**

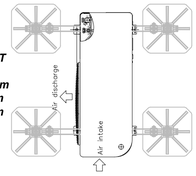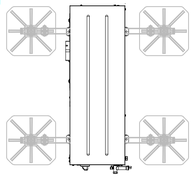


**Height 662mm**
**Width 1101mm**
**Depth 444mm**
**Net weight 76kg**


**CU2**
**GROUND FLOOR**
**CONDENSING UNIT**
**20kW**
**Height 1526mm**
**Width 940mm**
**Depth 340mm**
**Net weight 118kg**

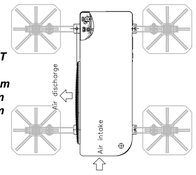

**Height 662mm**
**Width 1101mm**
**Depth 444mm**
**Net weight 76kg**

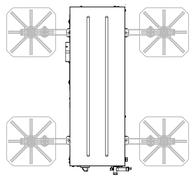**CU3**
**BASEMENT**
**CONDENSING UNIT**
**14kW**
**Height 1416mm**
**Width 940mm**
**Depth 340mm**
**Net weight 98kg**

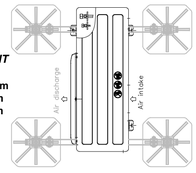


4000

4000

**NOTE**
**ALL ROOF PLANT TO MOUNTED ON SUITABLE SUPPORT SYSTEM (BIGFOOT OR SIMILAR APPROVED)**

I.V.

I.V.

| Rev | Date | Description |
|---|---|---|
| - | - | - |
| - | - | - |
| B | 11/07/24 | Updated To AS BUILT |
| A | 29/02/24 | Drawing Updated |

FWP UK LTD
REFRIGERATION·AIR CONDITIONING·VENTILATION
17 Calverton Business Park
Hoyle Road
Calverton
Nottingham NG14 6QL
tel: 0115 965 5042
web: fwpuk.com

| Drawn: | Checked: | Date: |
|---|---|---|
| - | - | --/--/----- |

Issue:
Provisional ☐ Approved ☐ As Built ■ Current ☐


Site Address:
Flat Iron
Manchester

Drawing Title:
Existing Condensing Units on Roof

| Drawing Number: | Rev: | Paper size: | Scale: |
|---|---|---|---|
| 22329/010 | B | A1 | 1:20 |

FWP UK Ltd

Copyright Notice:
This drawing and any design theron is the copyright of **FWP UK Ltd** and must not be reproduced without written consent

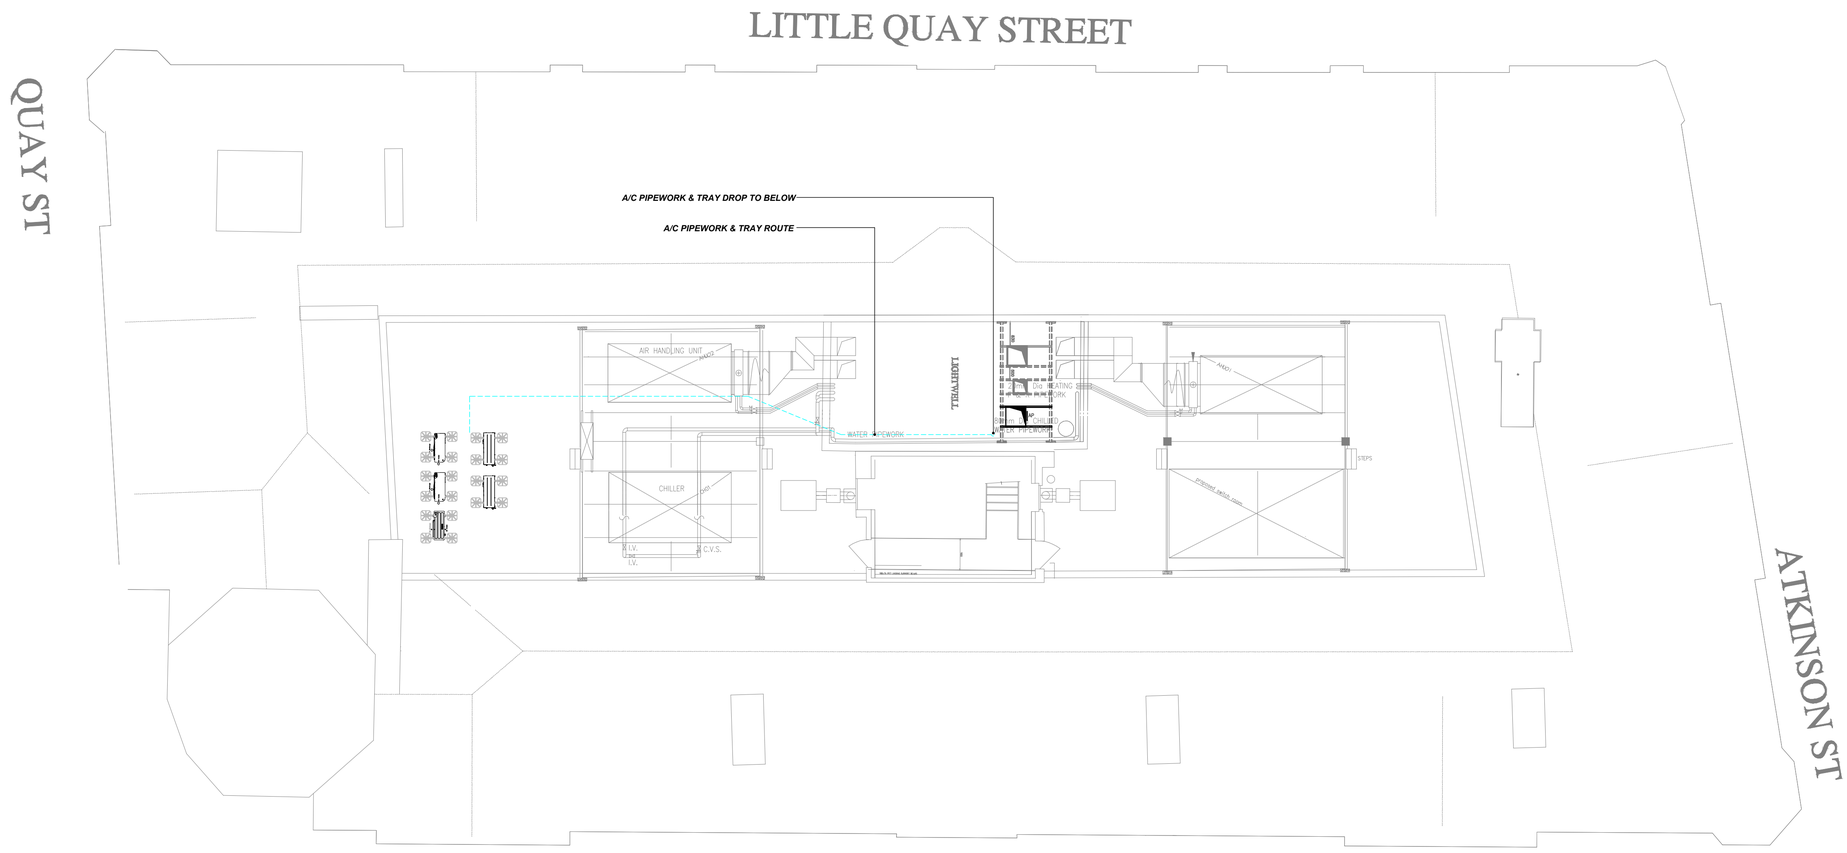


| Rev | Date | Description |
|---|---|---|
| - | - | - |
| - | - | - |
| B | 11/07/24 | Updated To AS BUILT |
| A | 06/03/24 | Drawing Updated |

FWP UK LTD
REFRIGERATION·AIR CONDITIONING·VENTILATION
17 Calverton Business Park
Hoyle Road
Calverton
Nottingham NG14 6QL
tel: 0115 965 5042
web: fwpuk.com

| Drawn: | Checked: | Date: |
|---|---|---|
| - | - | --/--/----- |

Issue:
Provisional ☐ Approved ☐ As Built ■ Current ☐

Site Address:
Flat Iron
Manchester


Drawing Title:
Existing Condensing Units on Roof

| Drawing Number: | Rev: | Paper size: | Scale: |
|---|---|---|---|
| 22329/011 | B | A1 | 1:100 |


FWP UK Ltd

Copyright Notice:
This drawing and any design theron is the copyright of **FWP UK Ltd** and must not be reproduced without written consent


Ground Floor Plan
Scale - 1:100

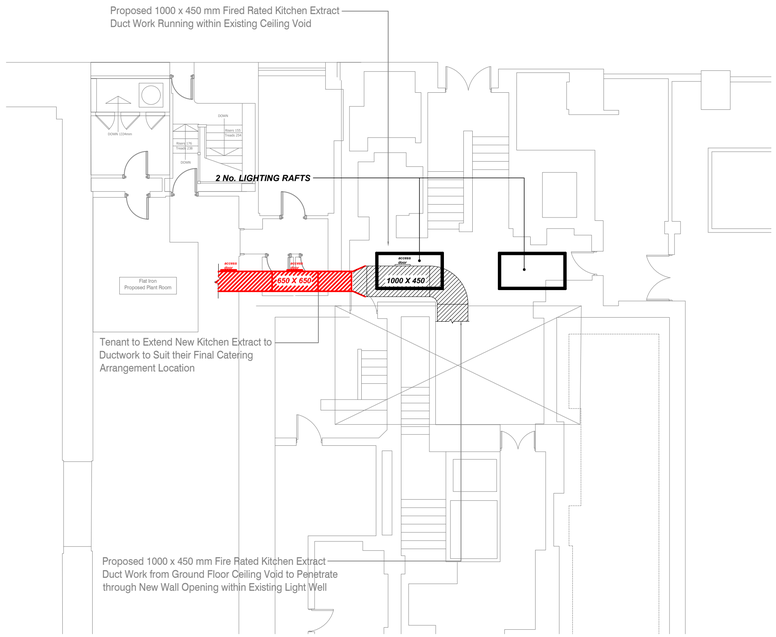



First Floor Plan
Scale - 1:100

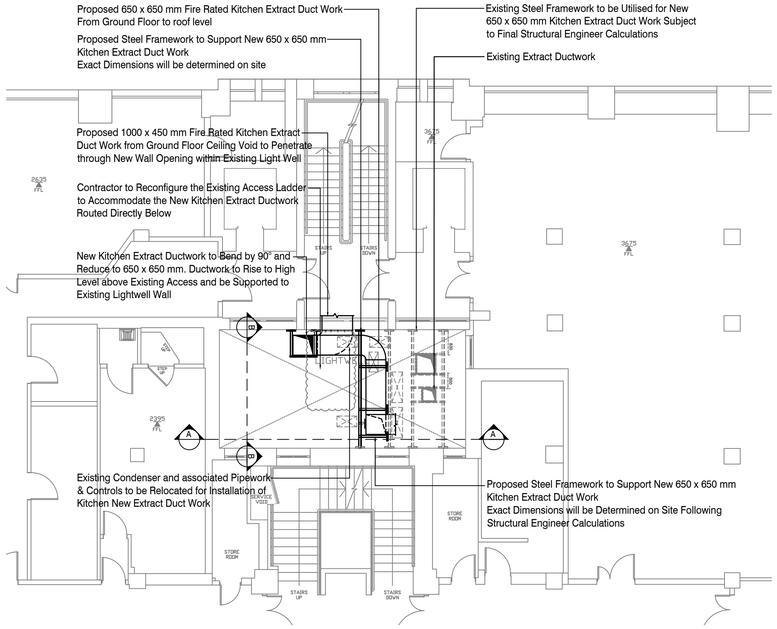



Roof Plan
Scale - 1:100

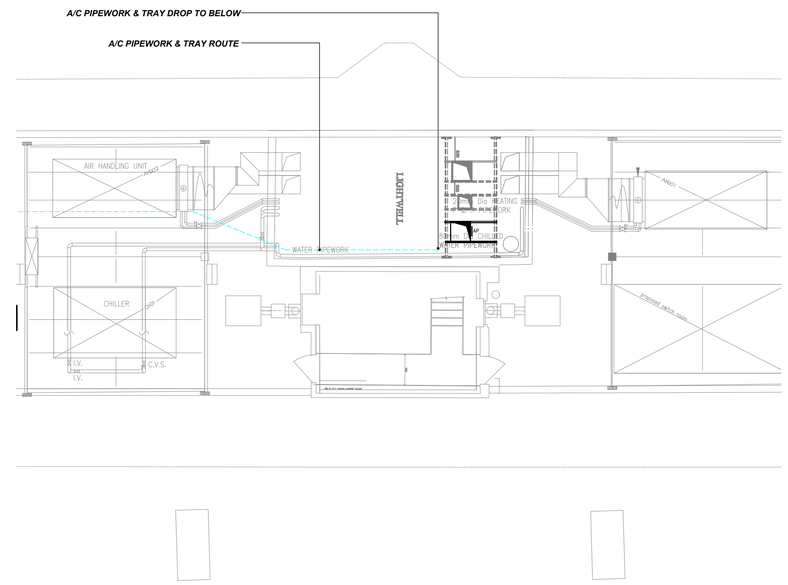


Section A-A (Side View)
Scale - 1:100

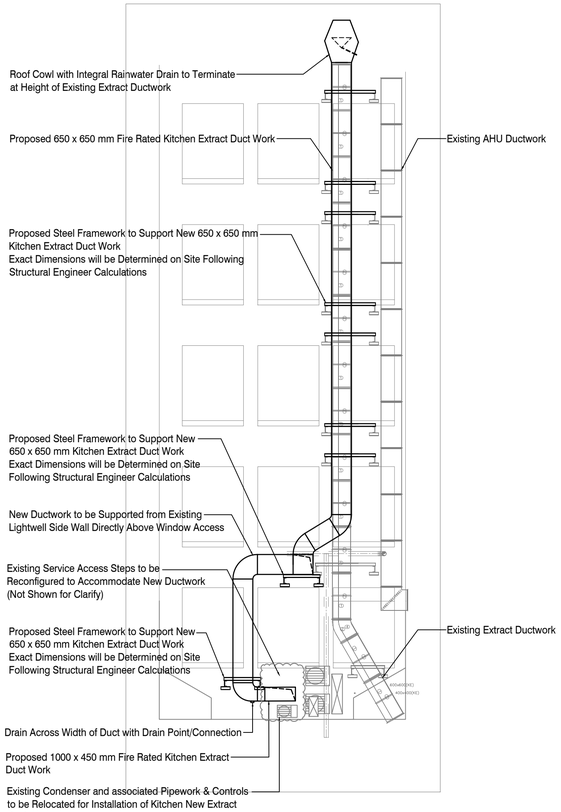


Section B-B (Front View)
Scale - 1:100

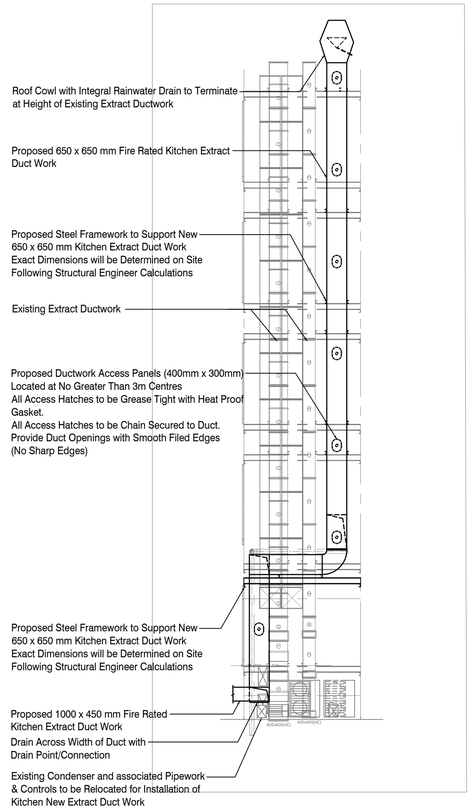


| Rev | Date | Description |
|---|---|---|
| - | - | - |
| - | - | - |
| B | 11/07/24 | Updated To AS BUILT |
| A | 08/05/24 | Drawing Updated |

FWP UK LTD
REFRIGERATION·AIR CONDITIONING·VENTILATION
17 Calverton Business Park
Hoyle Road
Calverton
Nottingham NG14 6QL
tel: 0115 965 5042
web: fwpuk.com

| Drawn: | Checked: | Date: |
|---|---|---|
| - | - | --/--/----- |

Issue: Provisional ☐ Approved ☐ As Built ■ Current ☐

Site Address:
Flat Iron
Manchester

Drawing Title:
Existing Kitchen Extract Route

| Drawing Number: | Rev: | Paper size: | Scale: |
|---|---|---|---|
| 22329/012 | B | A1 | 1:100 |