
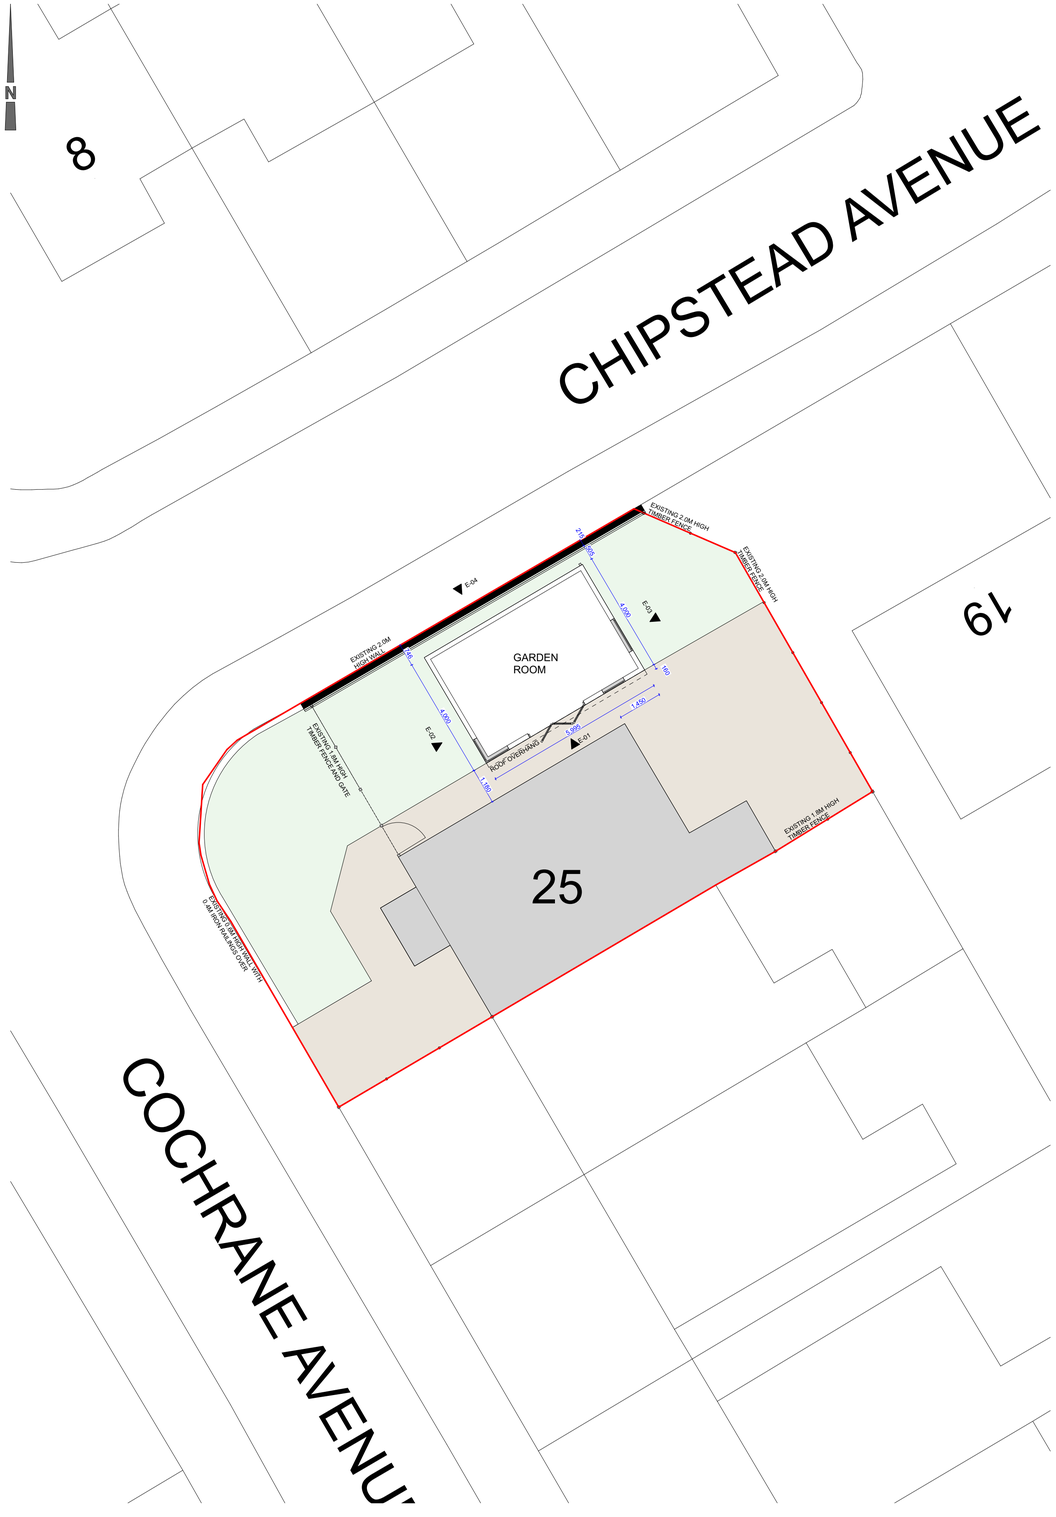



PROPOSED GA PLAN 1:100

0m 1 2 3 4 5

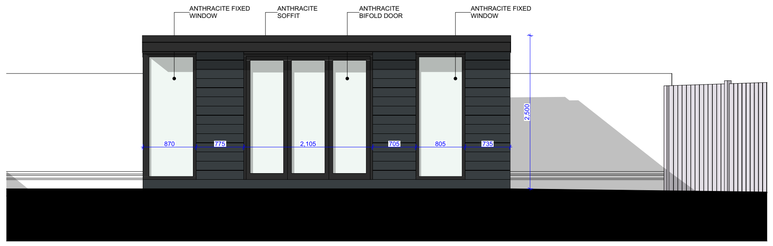


E-01 As Built Elevation 1:50

0m 1 2 3 4 5

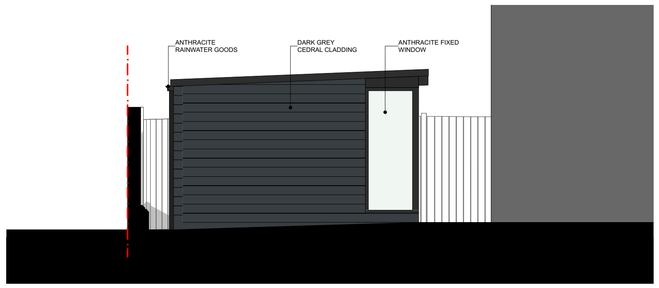


E-02 As Built Elevation 1:50

0m 1 2 3 4 5

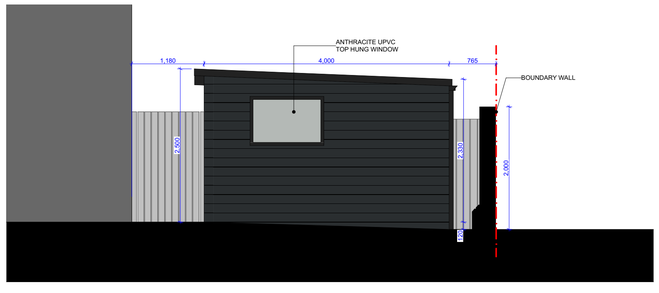

E-03 As Built Elevation 1:50


0m 1 2 3 4 5

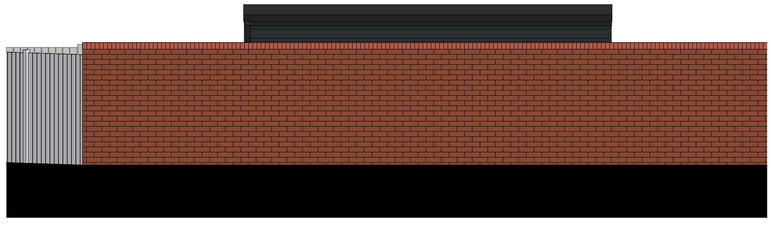

E-04 As Built Elevation 1:50

0m 1 2 3 4 5

DRAWING NOTES

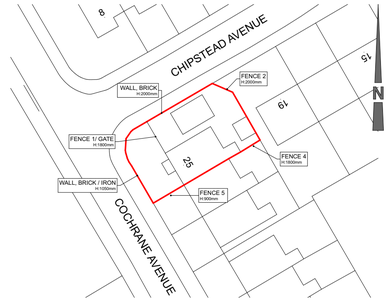

EXISTING BLOCK PLAN 1:500

0 10 20 30 40 50



PROPOSED BLOCK PLAN 1:500

0 10 20 30 40 50



LOCATION PLAN 1:1250

0m 10 20 30 40 50

RevID	Change Name	Date
A	INITIAL ISSUE	13/07/2026

PROJECT STATUS

PLANNING

PROJECT NUMBER

26-0701-R

CLIENT

MS U HANIF

SITE ADDRESS

25 Cochrane Avenue, Ardwick, Manchestern M12 4WD England

PROJECT DESCRIPTION

GARDEN ROOM

DRAWING TITLE

PLANNING INFORMATION: GA PLANS and ELEVATIONS

LEE REDFERN
ARCHITECTURE
contact@leeredfern.co.uk | **07886 332 885** | www.leeredfern.co.uk
190 MANSFIELD ROAD, SHEFFIELD, S12 2AG, UK

DATE	SCALE	DRAWN	SIZE
13/07/2026	SEE DRAWING	LR	A1

DRG № **26-0701-R-01** REVISION **A**

DO NOT SCALE FROM THIS DRAWING